

ATTACHMENTS DISTRIBUTED UNDER SEPARATE COVER

ITEM 2 DA2017/01376 - 495-501 Hunter Street & 364 King Street Newcastle

Demolition of buildings, erection of fifteen storey mixed use development with three retail/commercial tenancies, 87 residential units, associated car parking and site works

Attachment A - Submitted Plans Attachment B - Processing Chronology

PUBLIC VOICE COMMITTEE MEETING


18 February 2020


PV 18/02/2020

DA2017/01376 - 495-501 Hunter Street & 364 King Street Newcastle

Attachment A: Submitted Plans

DISTRIBUTED UNDER SEPARATE COVER

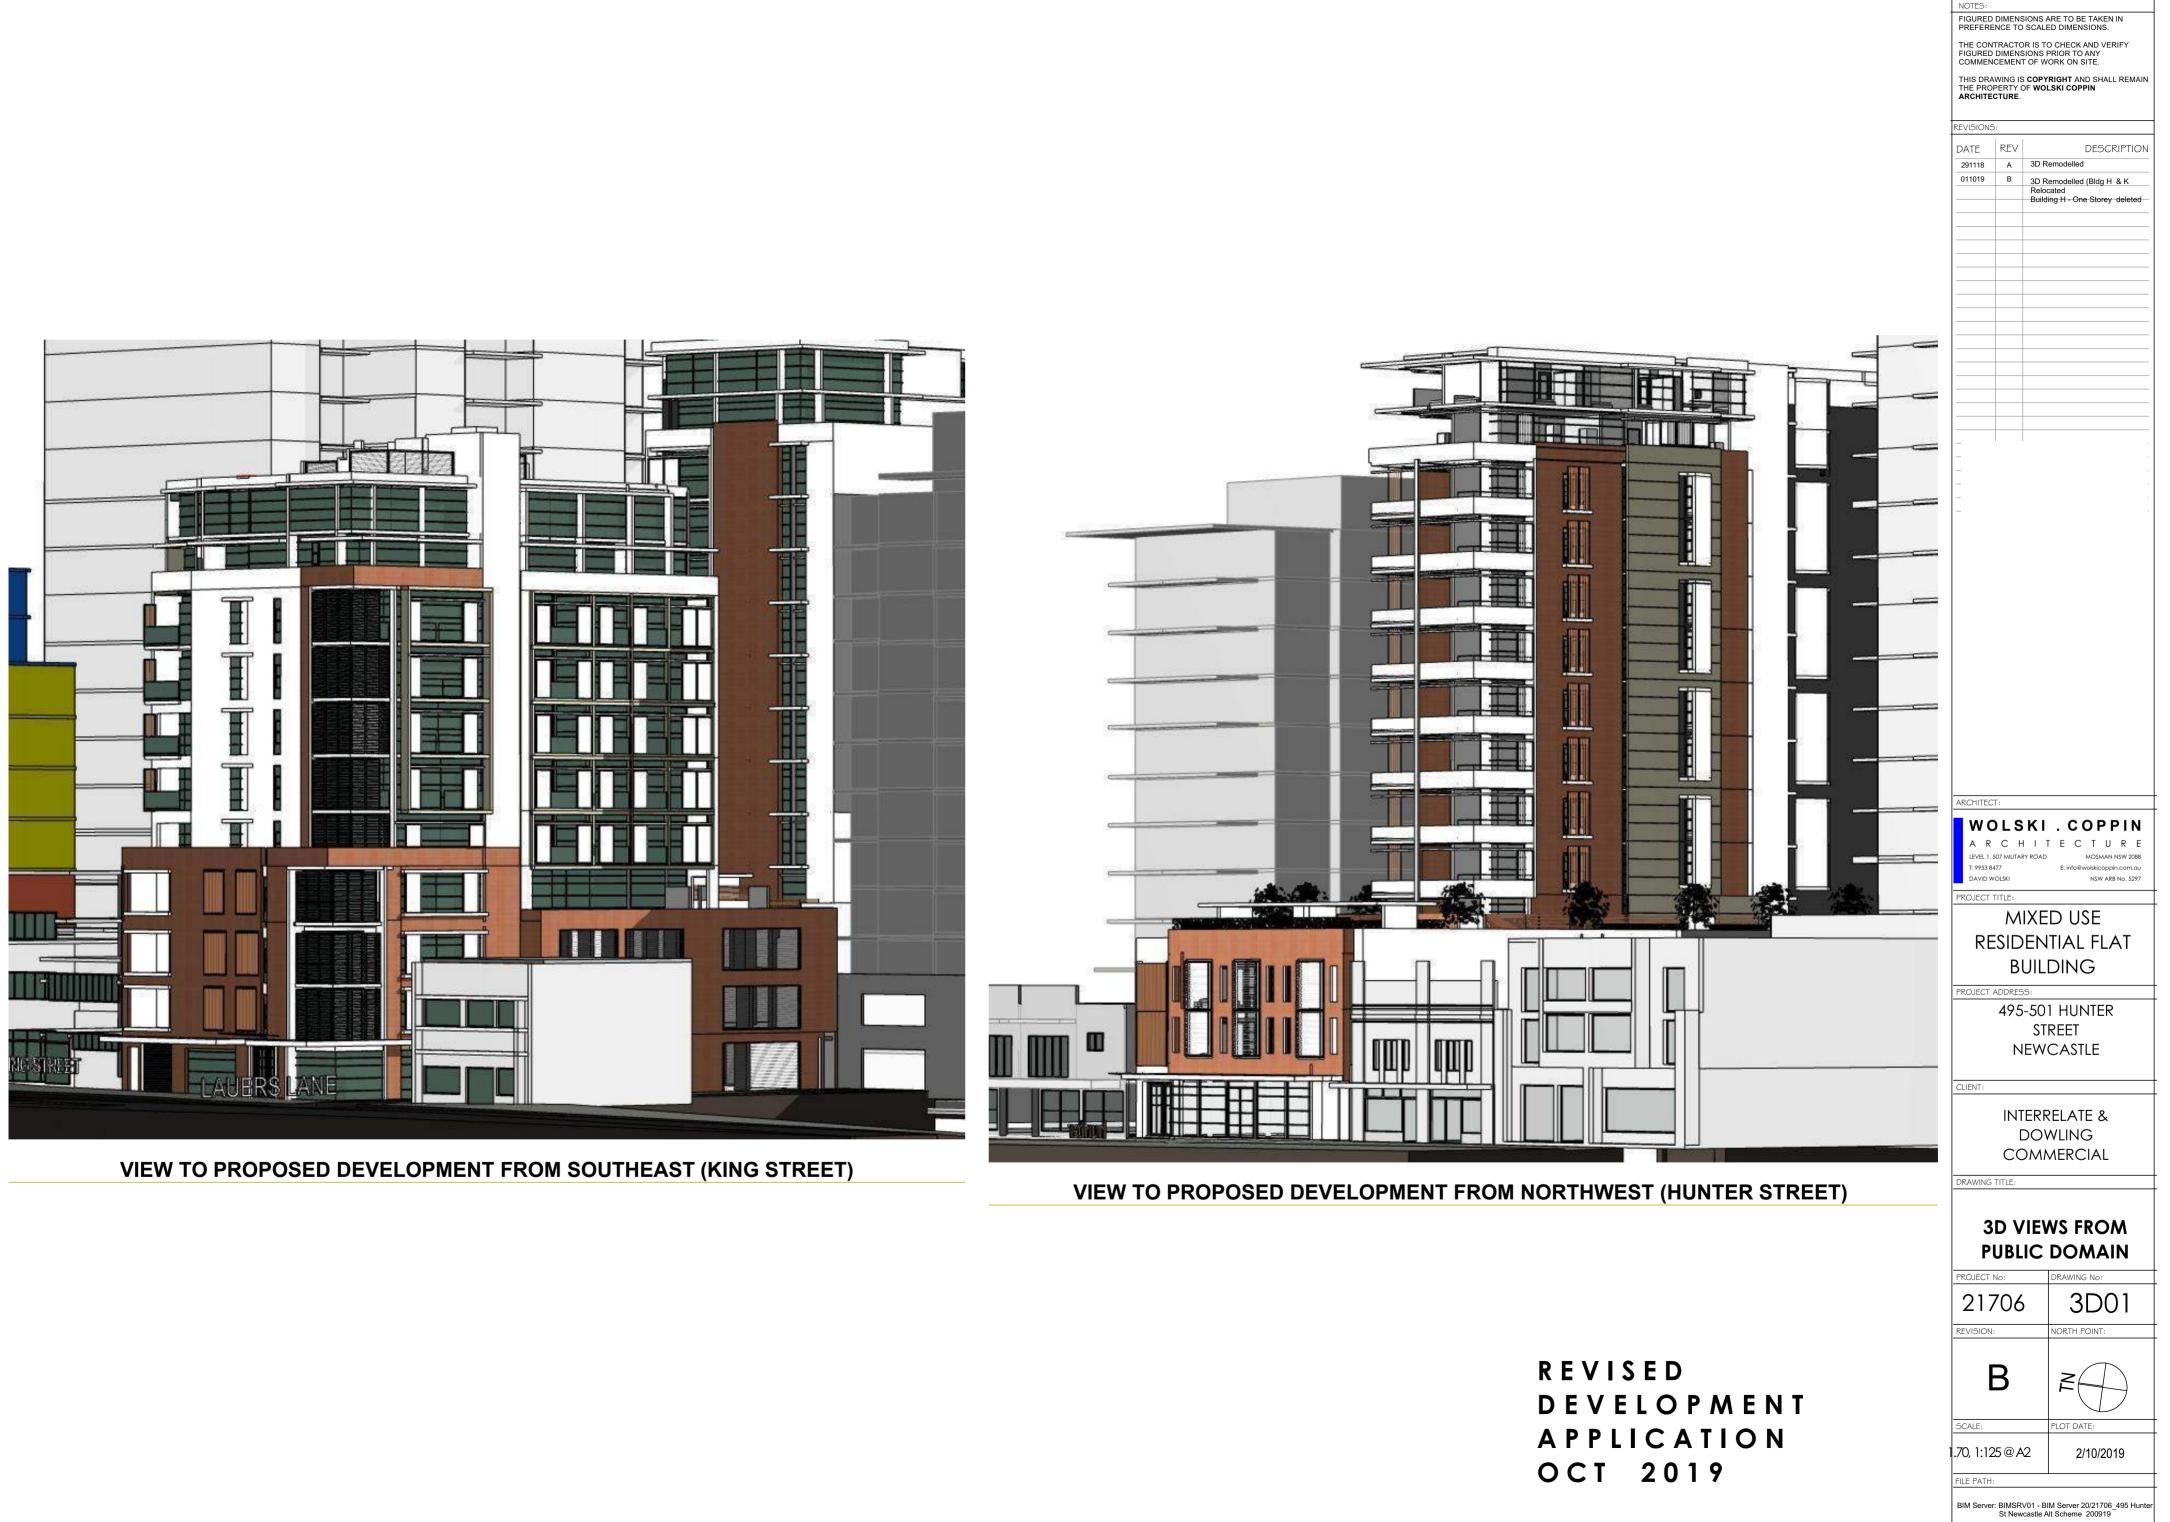


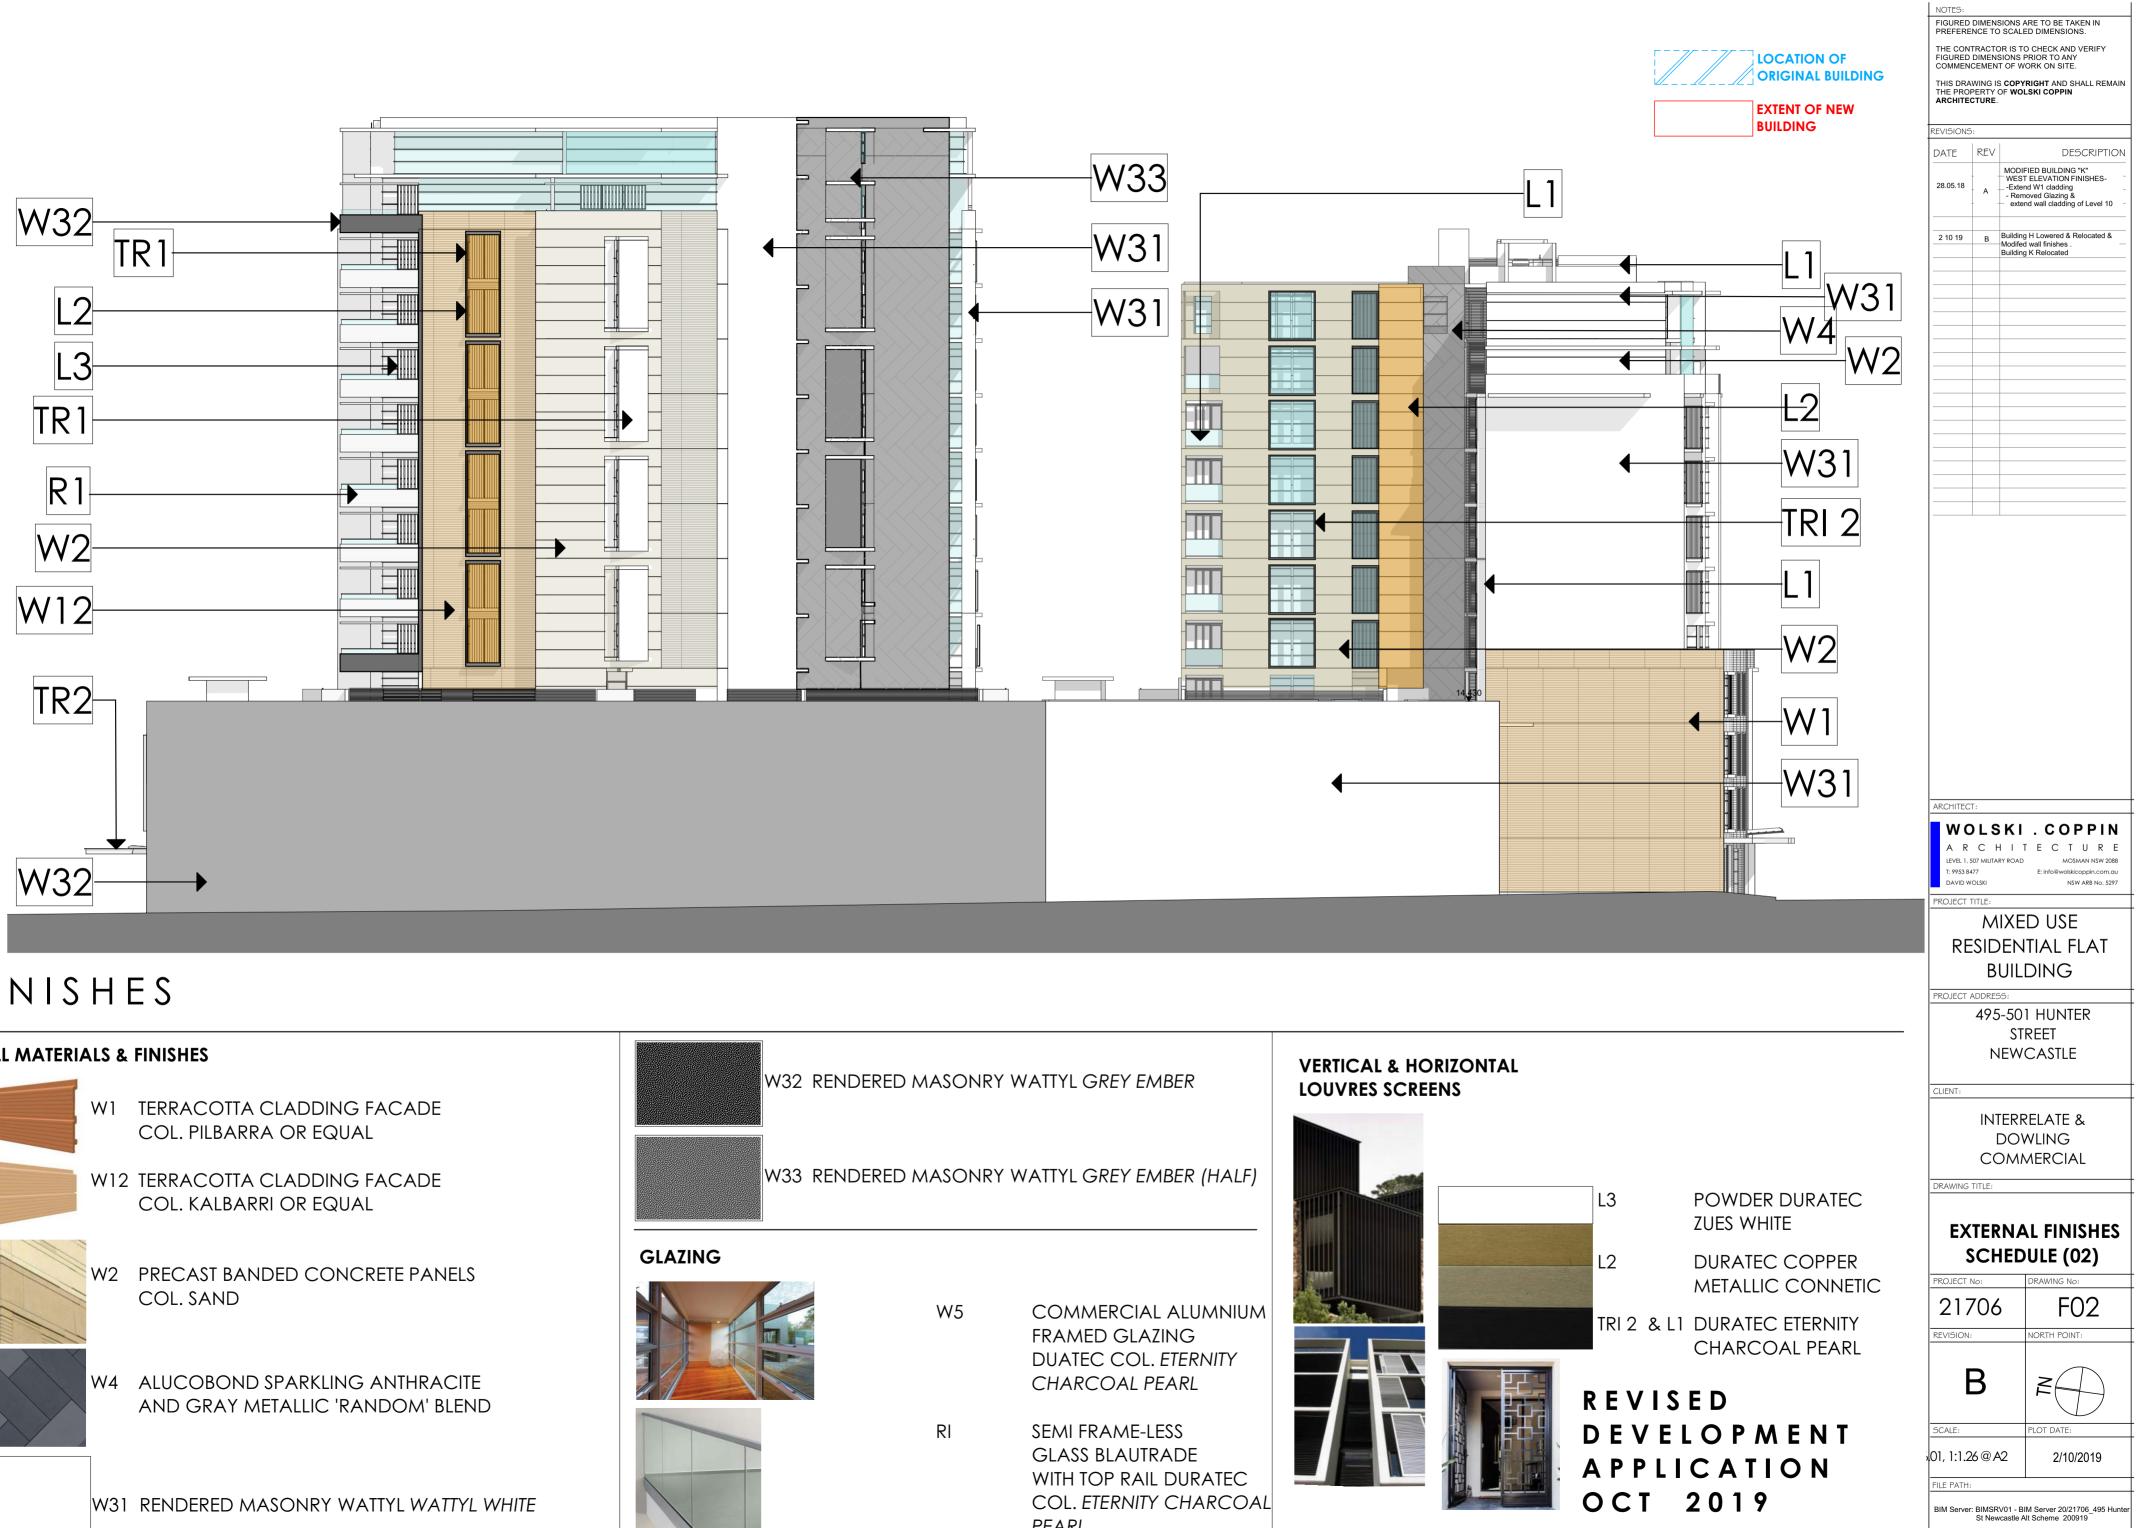

FINISHES

WALL MATERIALS & FINISHES



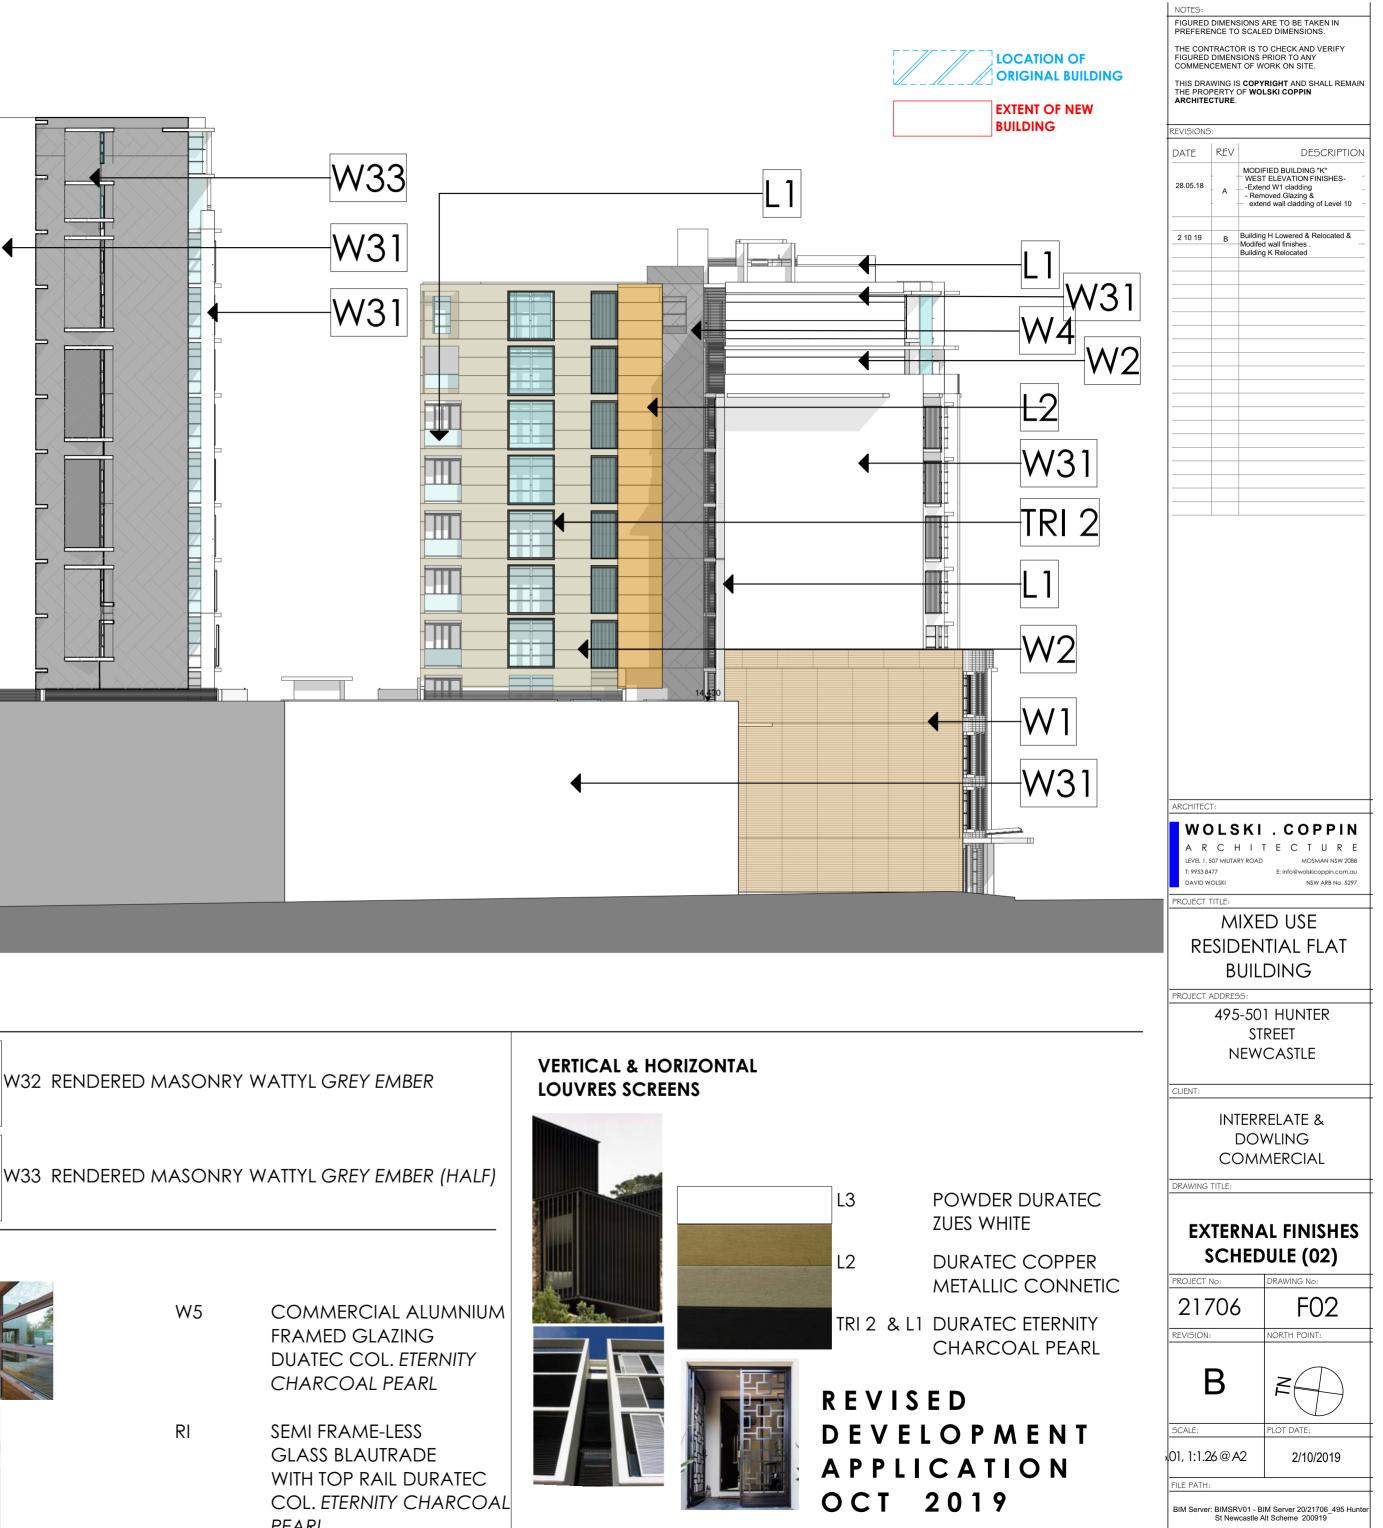




/5	COMME FRAMED DUATEC CHARCO
l	SEMI FRA GLASS B WITH TO


PEARL

REVISED DEVELOPMENT APPLICATION OCT 2019

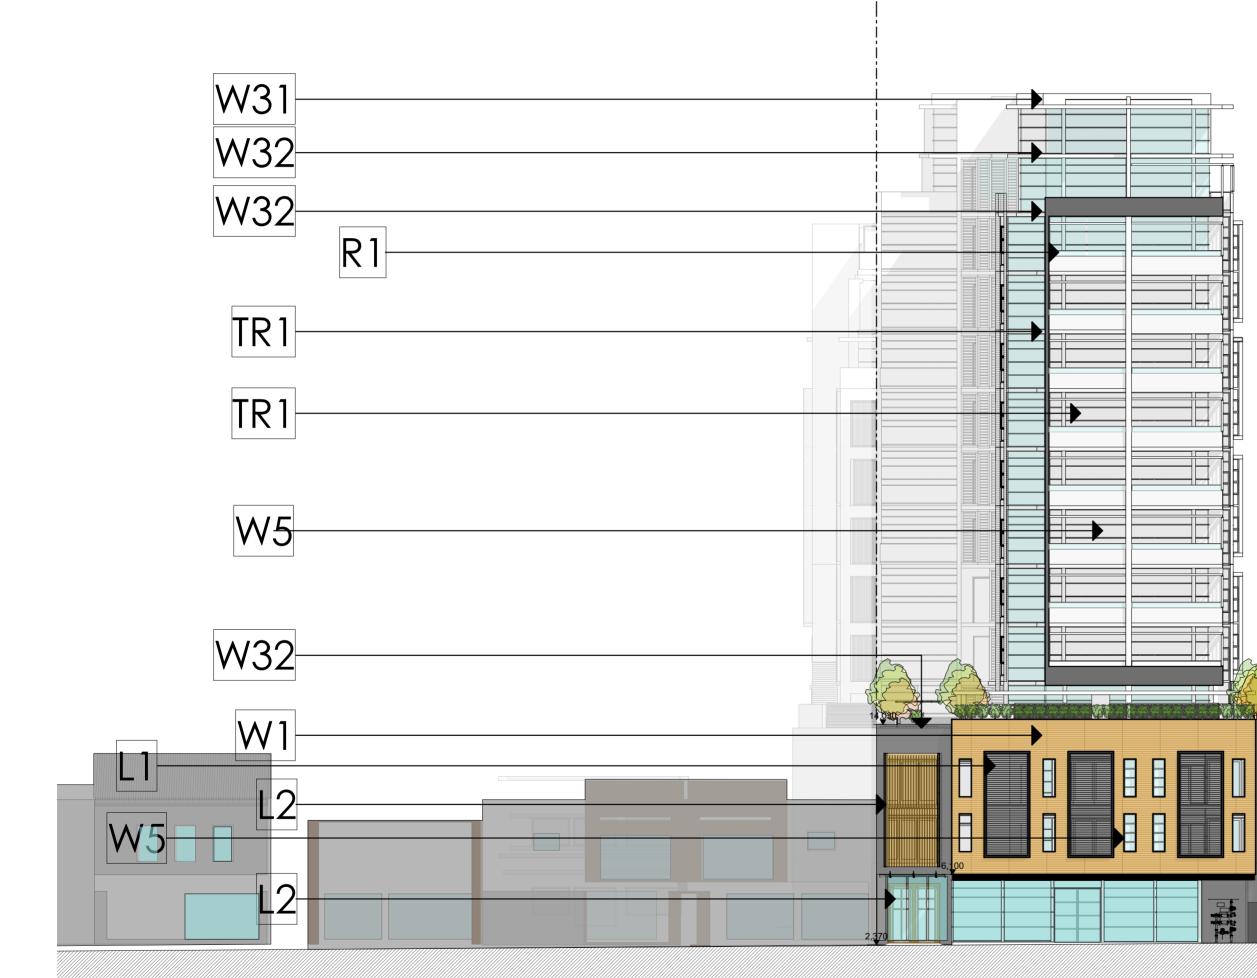

FIGURED DIMENSIONS ARE TO BE TAKEN IN PREFERENCE TO SCALED DIMENSIONS. FINISHES THE CONTRACTOR IS TO CHECK AND VERIFY FIGURED DIMENSIONS PRIOR TO ANY COMMENCEMENT OF WORK ON SITE. THIS DRAWING IS **COPYRIGHT** AND SHALL REMAIN THE PROPERTY OF **WOLSKI COPPIN ARCHITECTURE**. WALL MATERIALS & FINISHES VISIONS: DATE REV W1 TERRACOTTA CLADDING FACADE DESCRIPTION 28.05.18 A Modified Wall height & Finishes COL. PILBARRA OR EQUAL One storey deleted. Modified Wall Finishes 2.10.19 B W12 TERRACOTTA CLADDING FACADE COL. KALBARRI OR EQUAL W2 PRECAST BANDED CONCRETE PANELS COL. SAND W4 ALUCOBOND SPARKLING ANTHRACITE AND GRAY METALLIC 'RANDOM' BLEND W31 RENDERED MASONRY WATTYL WATTYL WHITE W32 RENDERED MASONRY WATTYL GREY EMBER W33 RENDERED MASONRY WATTYL GREY EMBER (HALF) **VERTICAL & HORIZONTAL** RCHITECT: LOUVRES SCREENS WOLSKI . COPPIN ARCHII LEVEL 1, 507 MILITARY RO POWDER DURATEC MOSMAN NSW 2088 L3 9953 8477 kicoppin.com.a DAVID WOLSKI NSW ARB No. 5297 ZUES WHITE PROJECT TITLE: MIXED USE L2 DURATEC COPPER **RESIDENTIAL FLAT** METALLIC CONNETIC BUILDING TRI 2 & L1 DURATEC ETERNITY PROJECT ADDRESS 495-501 HUNTER CHARCOAL PEARL STREET NEWCASTLE CLIENT **INTERRELATE &** DOWLING COMMERCIAL DRAWING TITLE: GLAZING **EXTERNAL FINISHES SCHEDULE 01** W5 COMMERCIAL ALUMNIUM PROJECT No: DRAWING No: FRAMED GLAZING F01 21706 DUATEC COL. ETERNITY CHARCOAL PEARL REVISION: NORTH POINT: В RI SEMI FRAME-LESS GLASS BLAUTRADE WITH TOP RAIL DURATEC SCALE: LOT DATE: COL. ETERNITY CHARCOAL 51, 1:1.26@A2 28 05 18 PEARL FILE PATH:


> BIM Server: BIMSRV01 - BIM Server 20/21706_495 Hunt St Newcastle Alt Scheme 200919

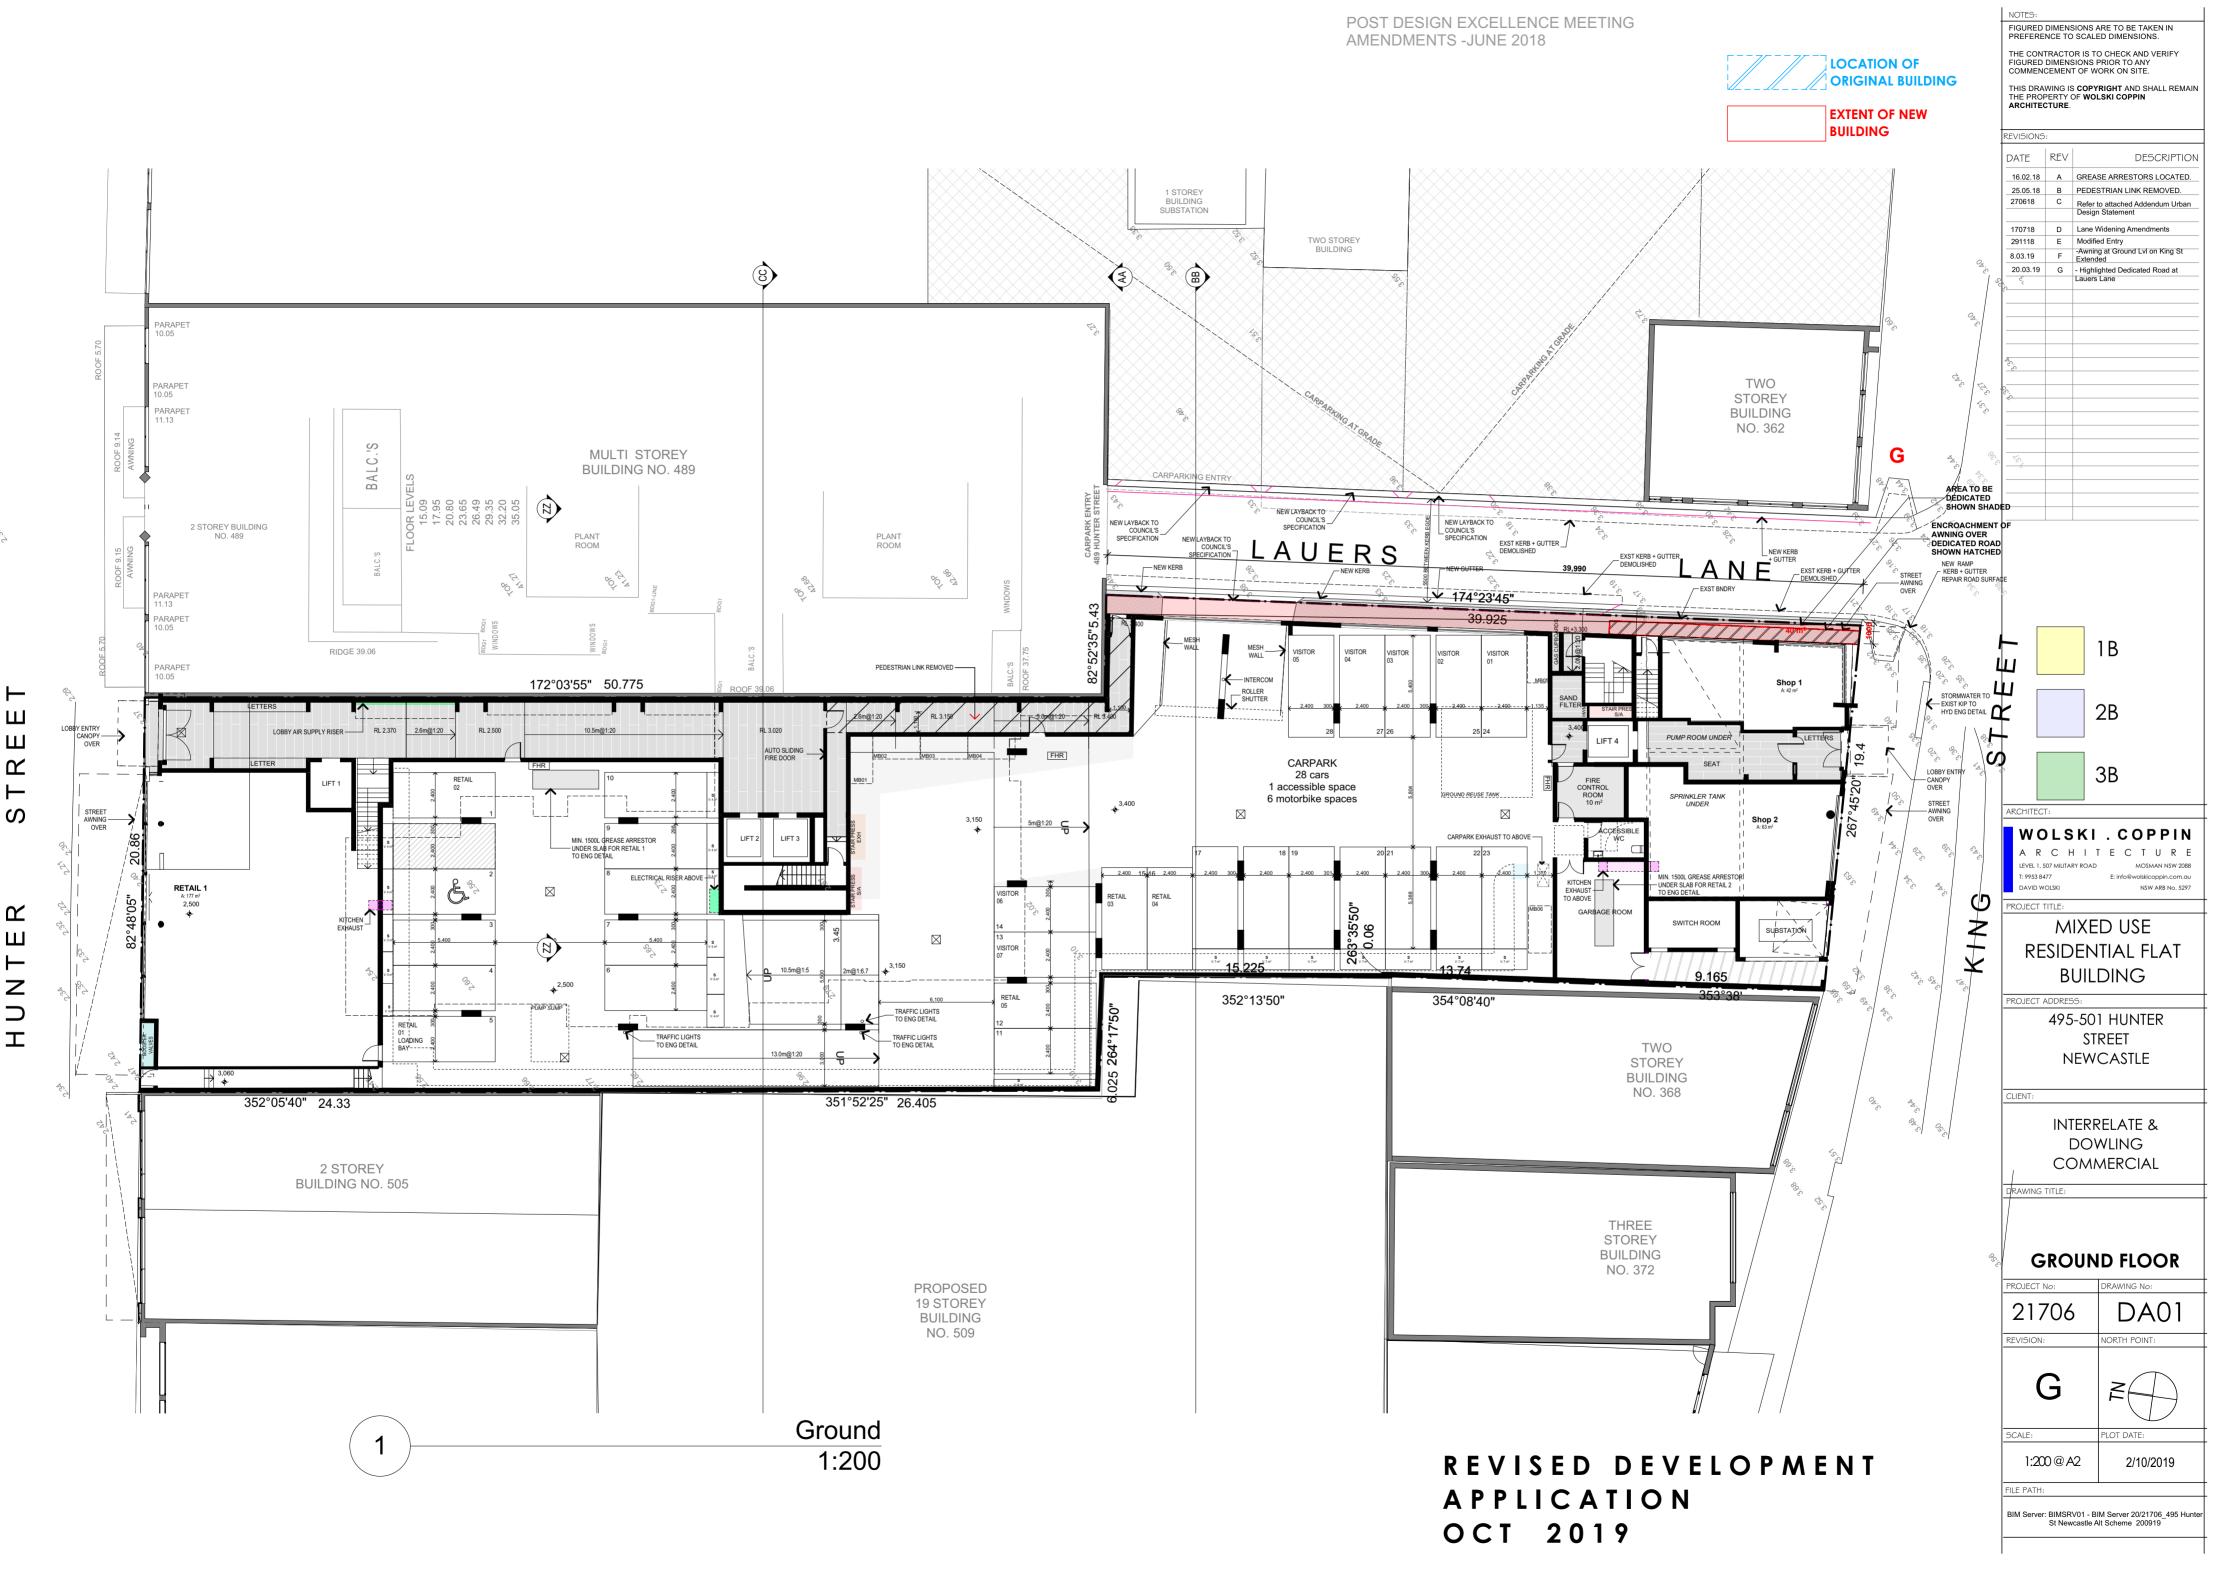


ш $\mathbf{\mathcal{L}}$ \vdash S $\mathbf{\mathcal{L}}$ ш \vdash Ζ

 \vdash ш

2c.2

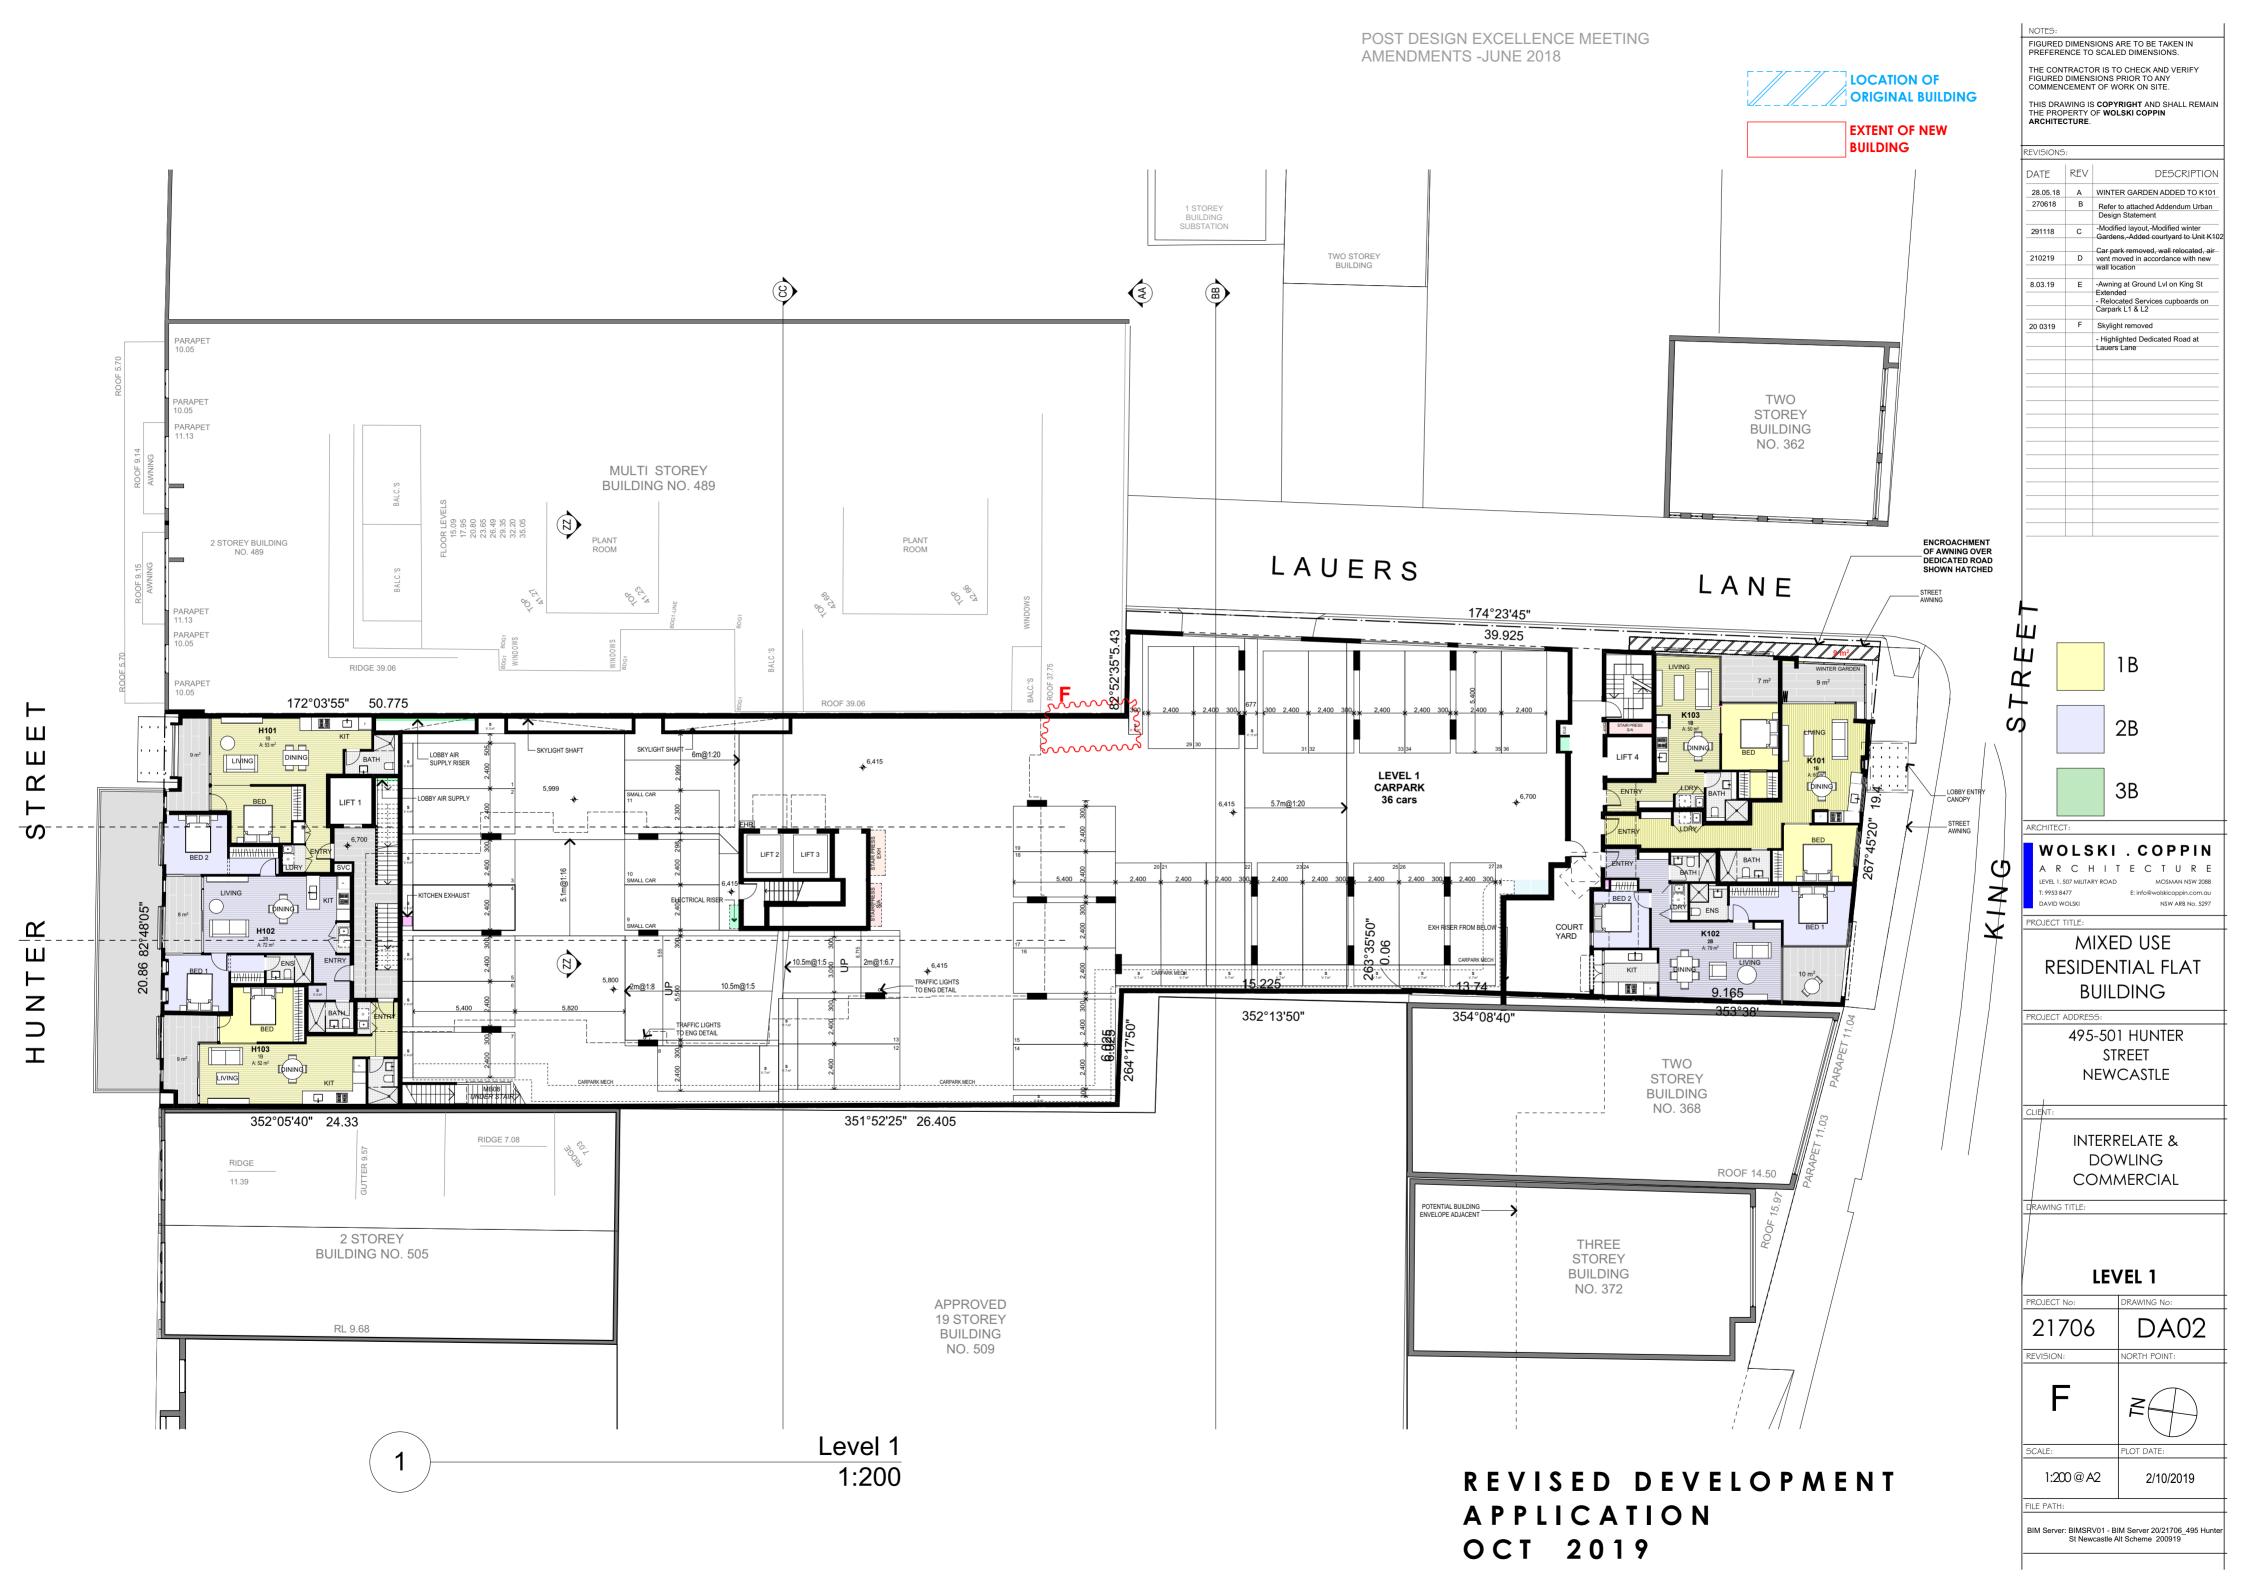

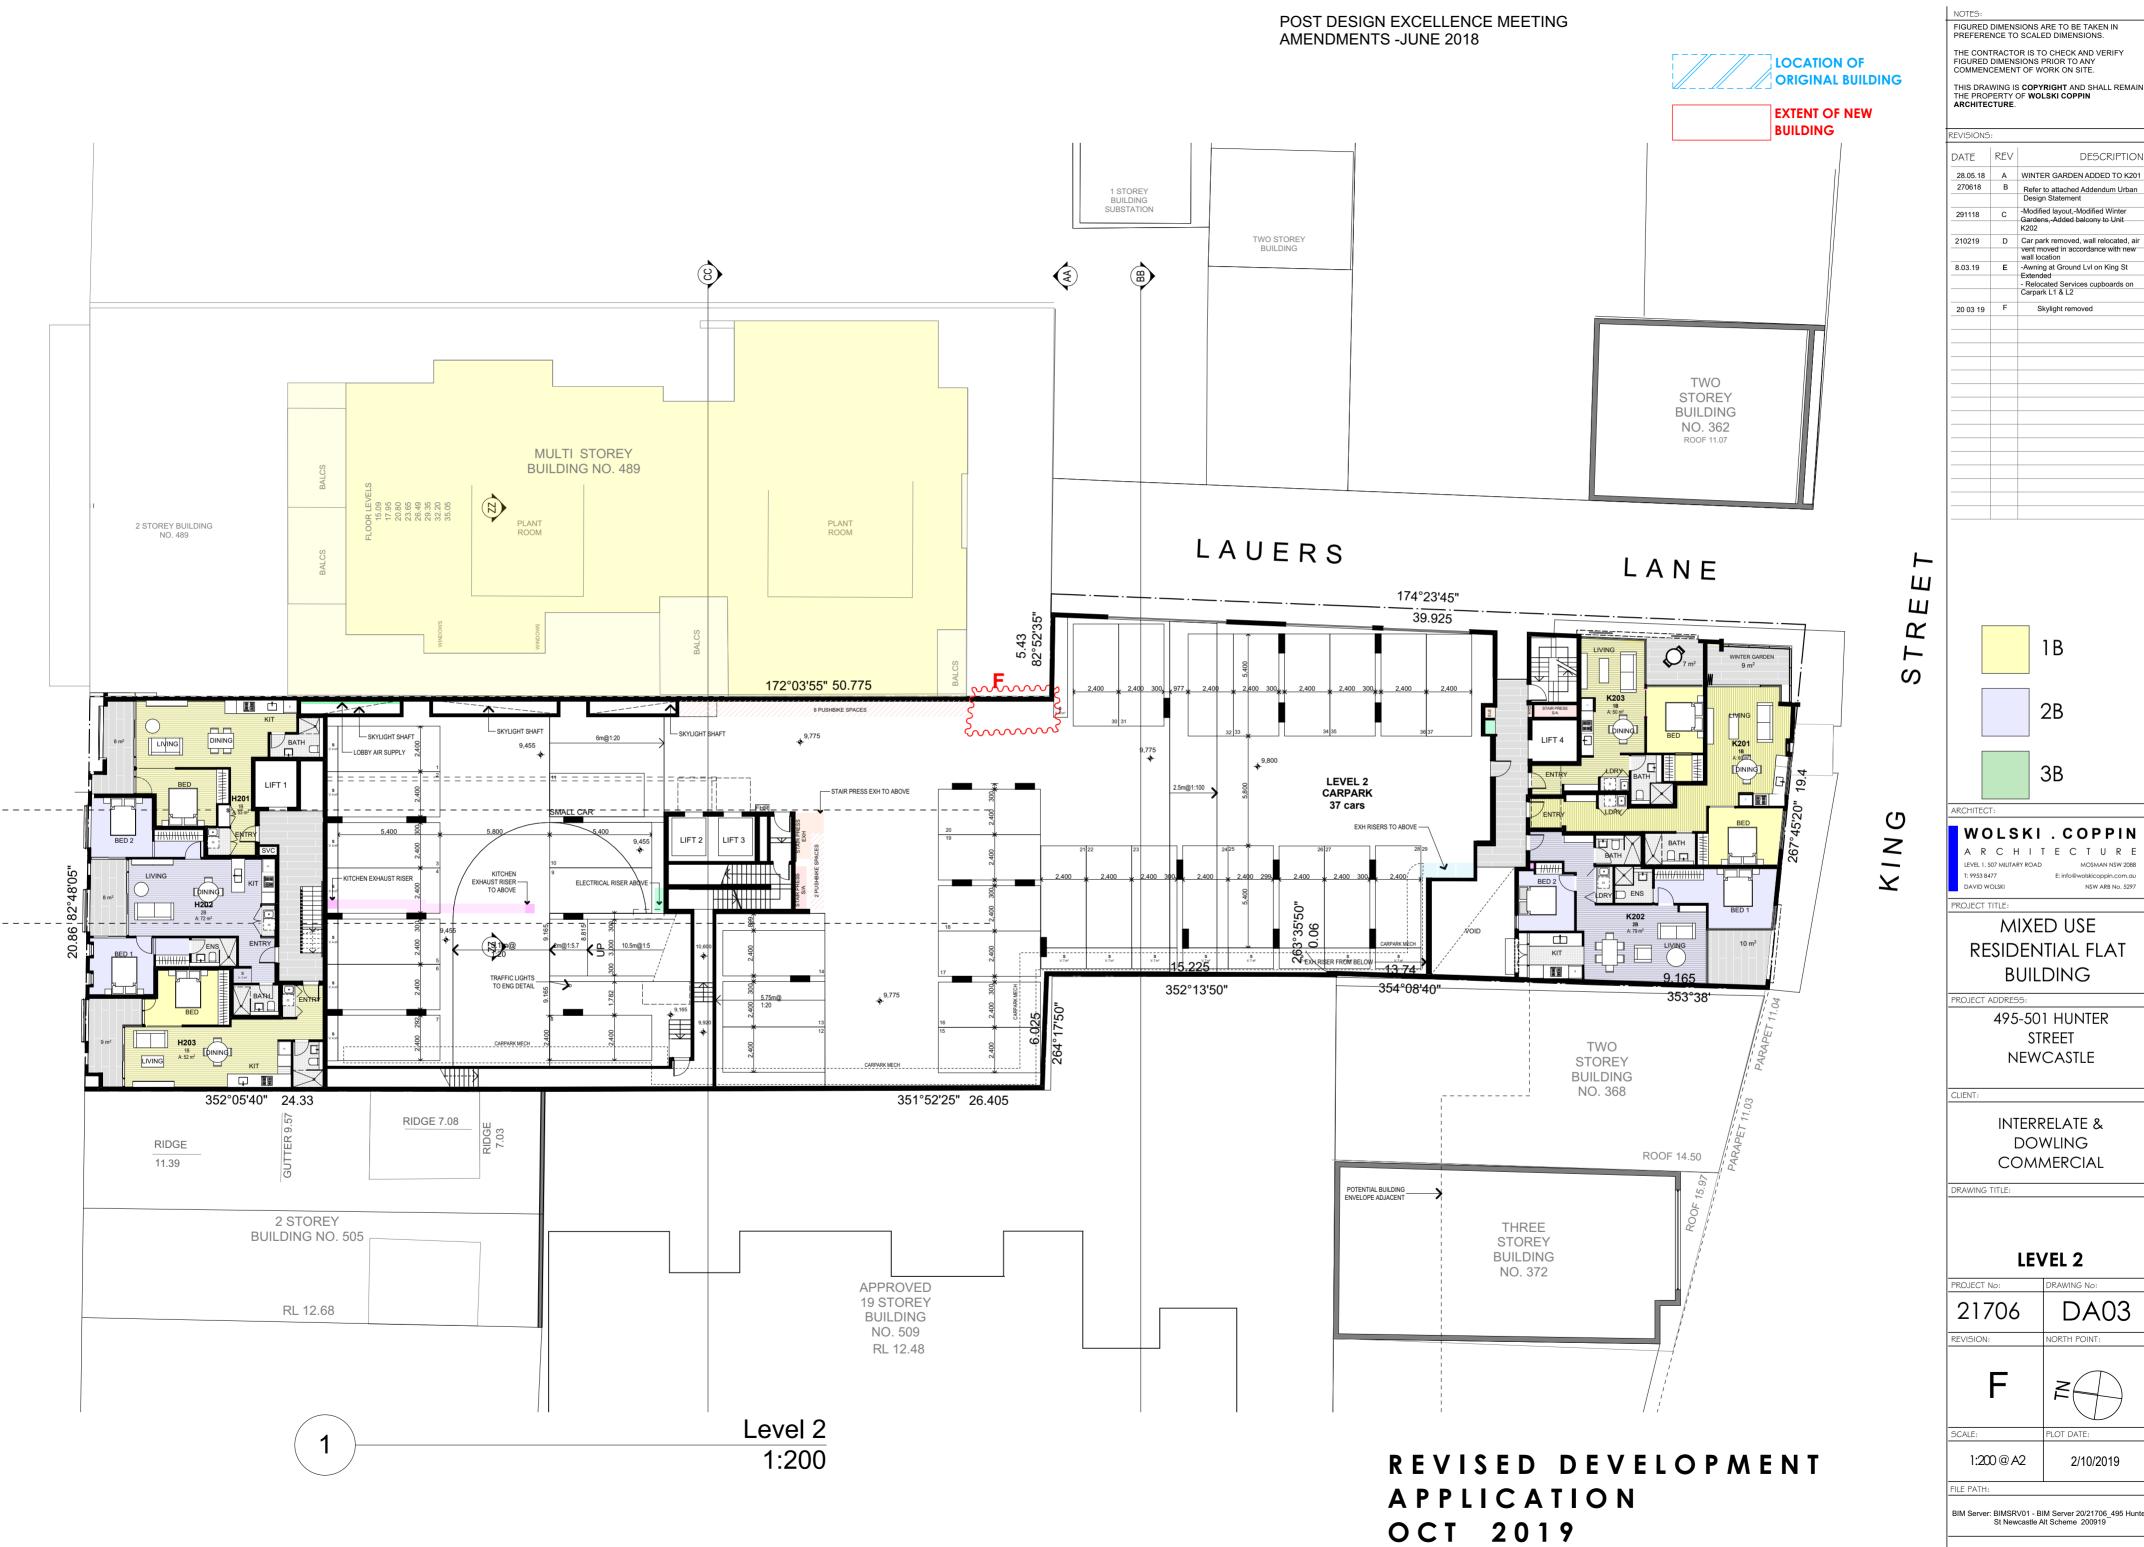


ш ш $\mathbf{\mathcal{L}}$ \vdash _**℃**_ \mathbf{r} ш \vdash

Ζ


 \supset

Т

 \vdash

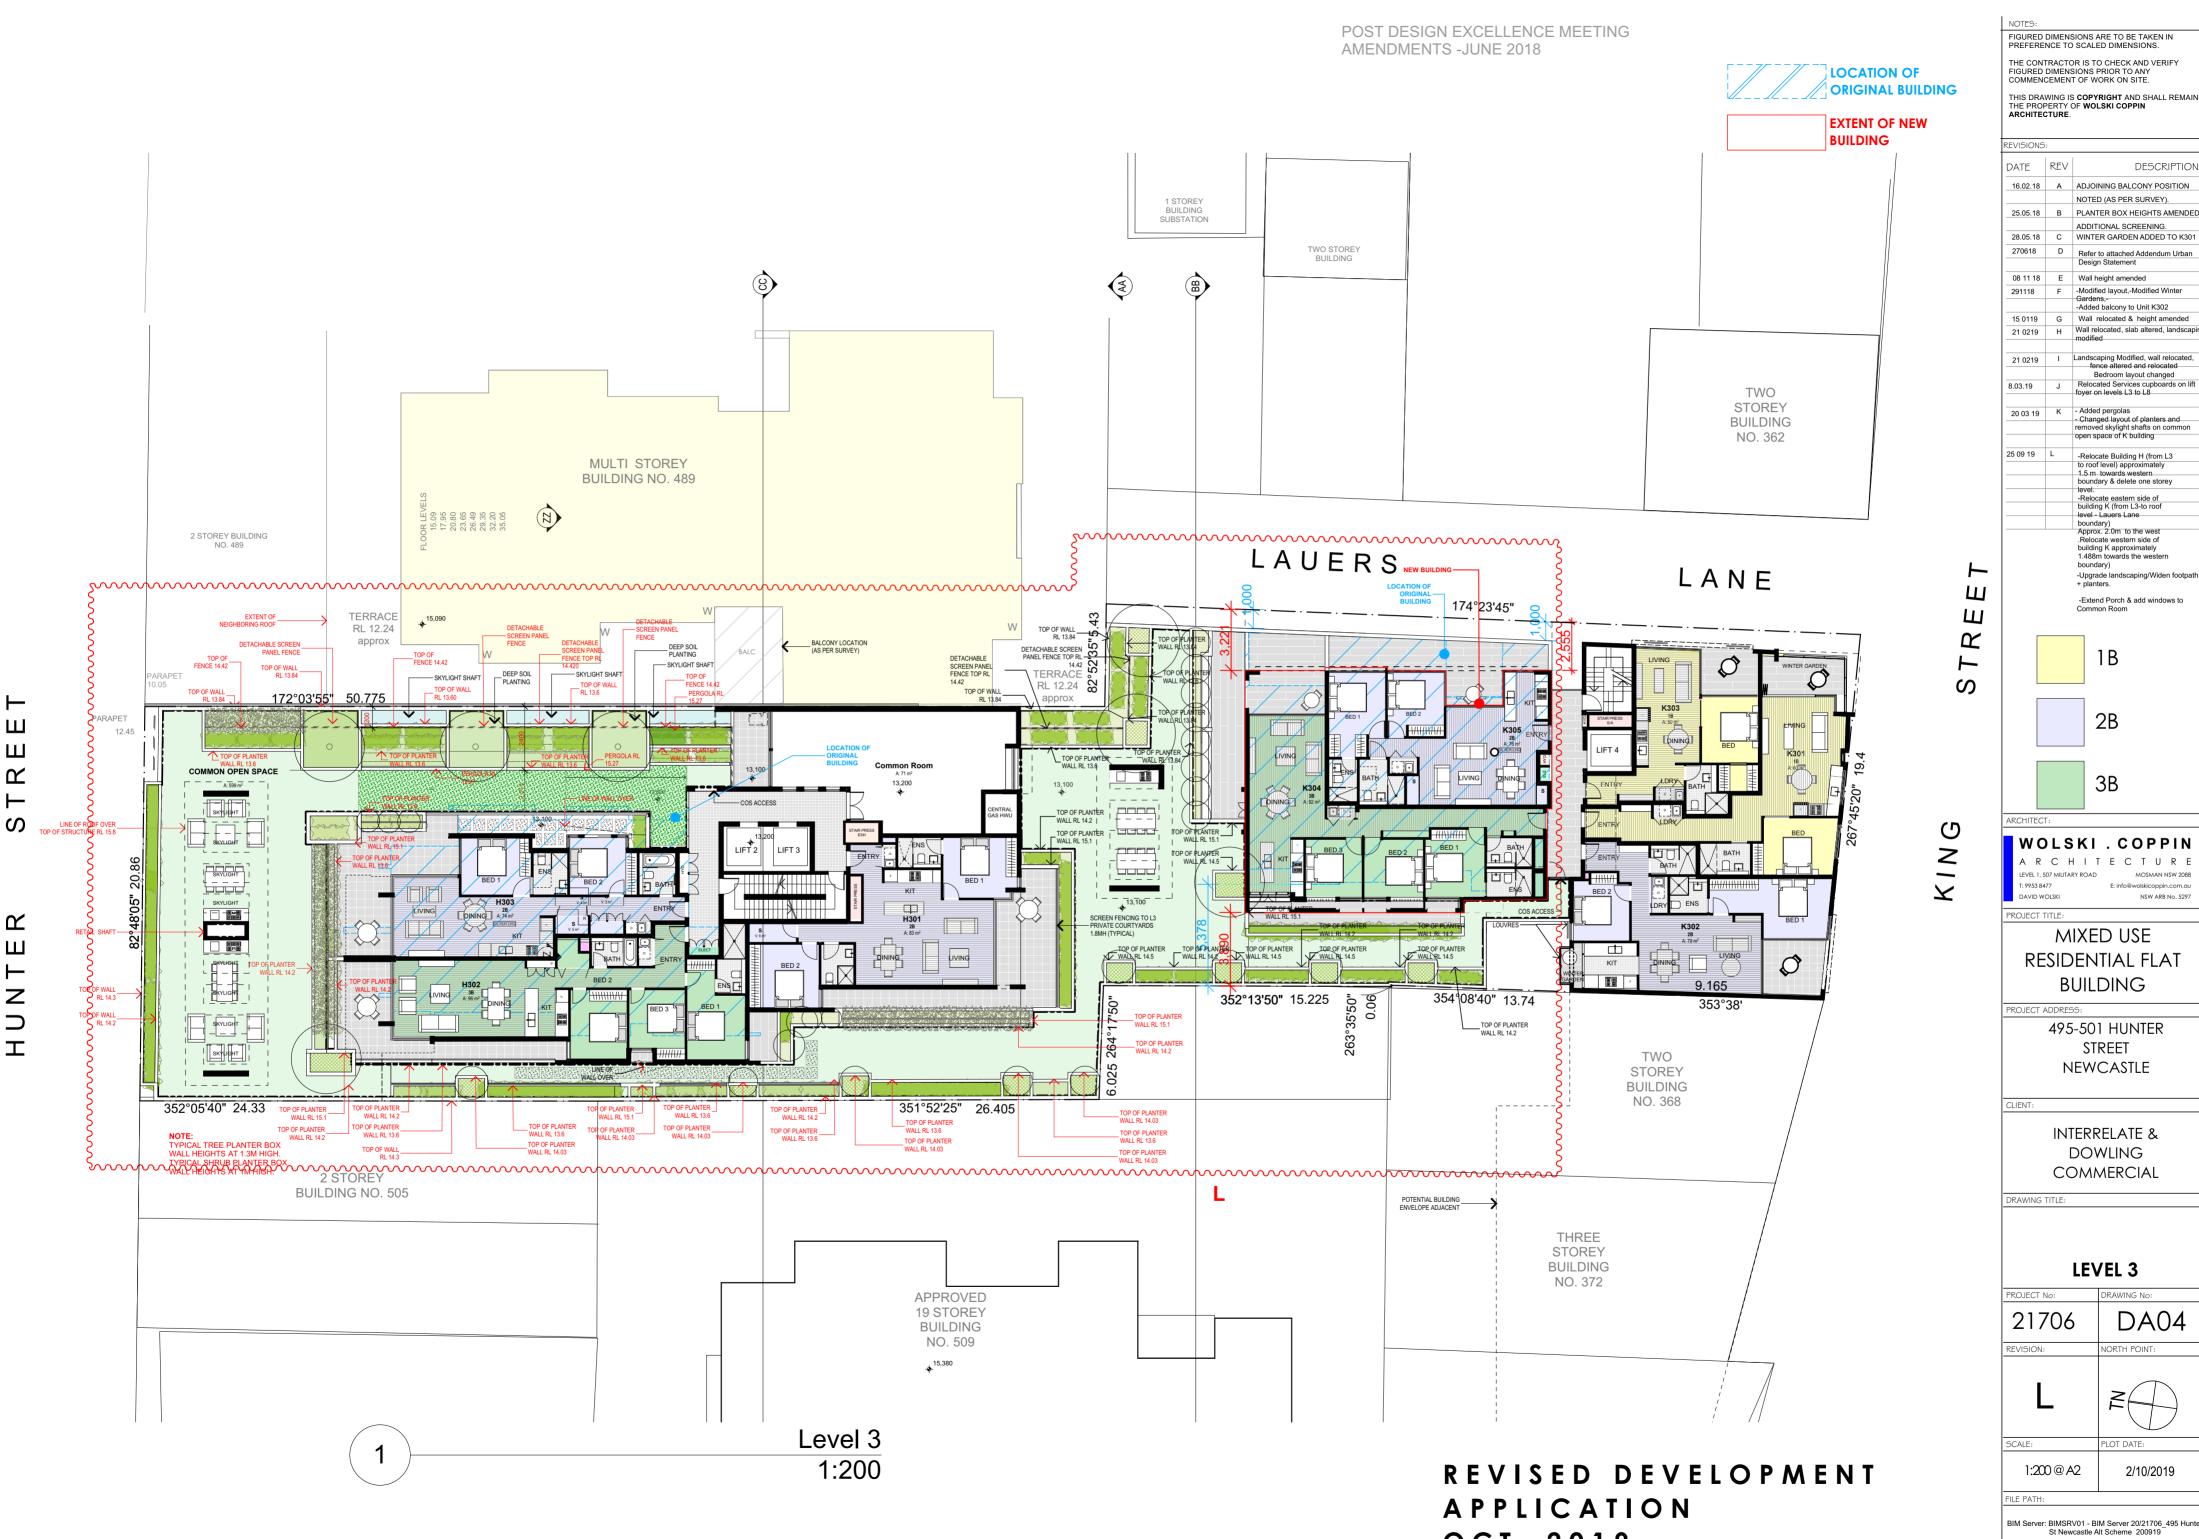


OCT 2019

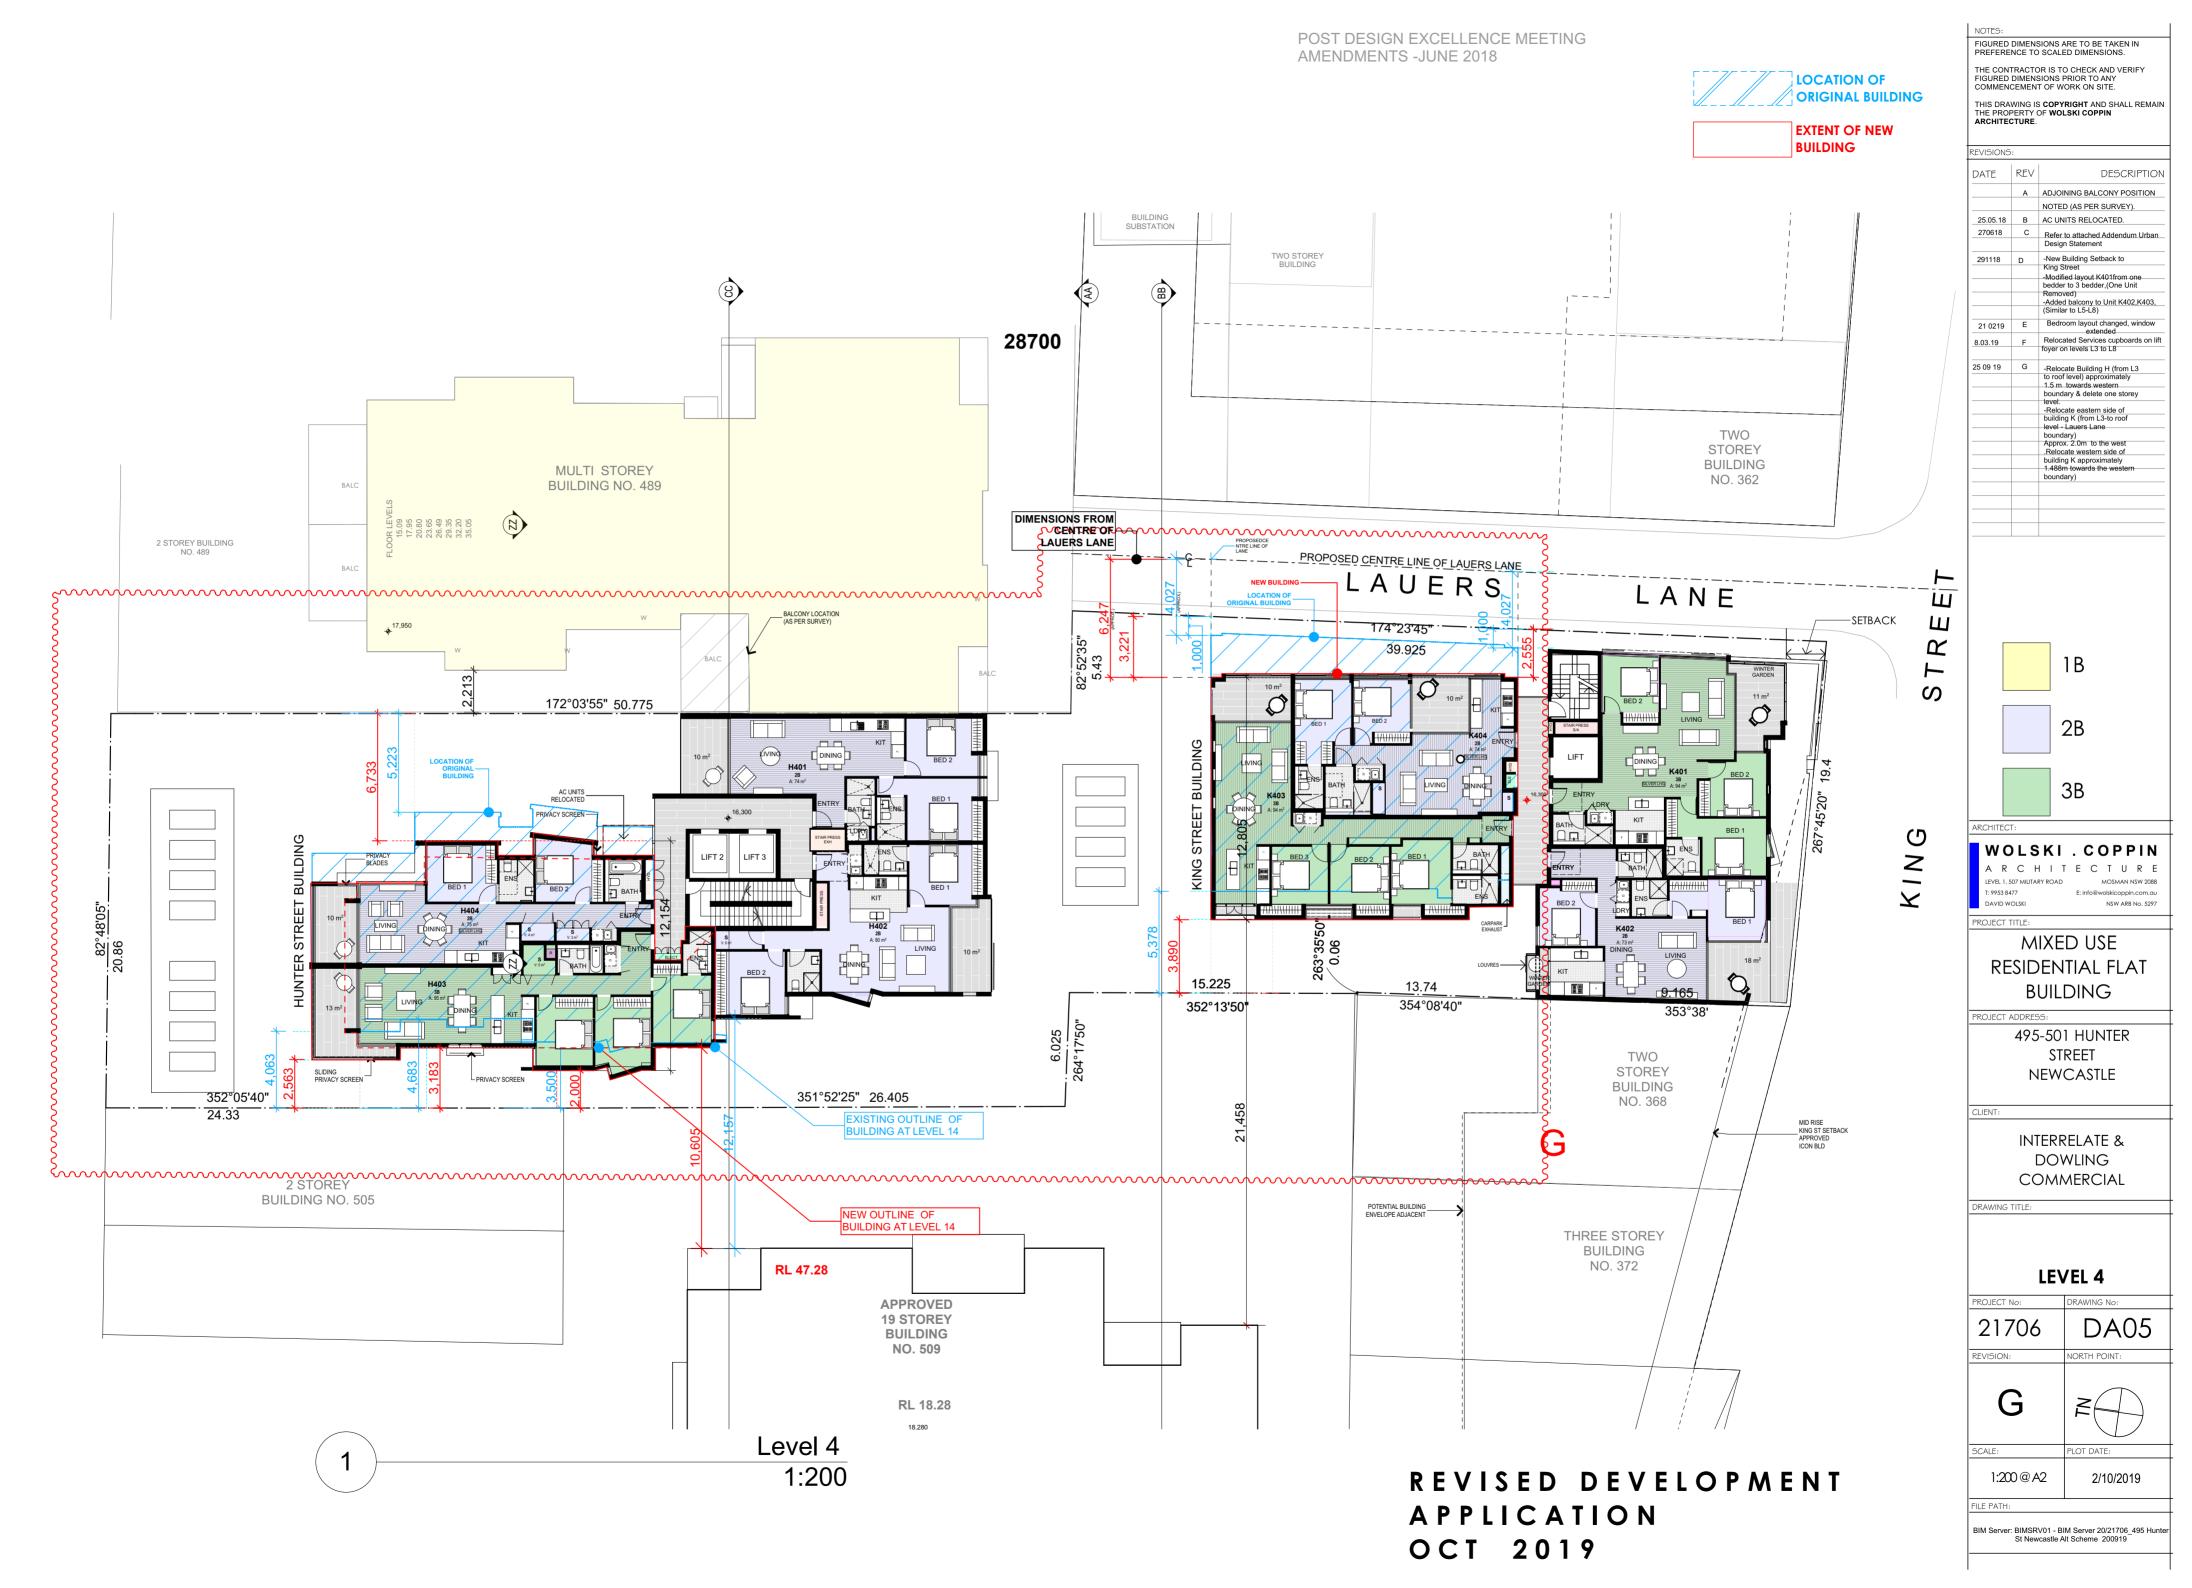


UNTER STREE

Т

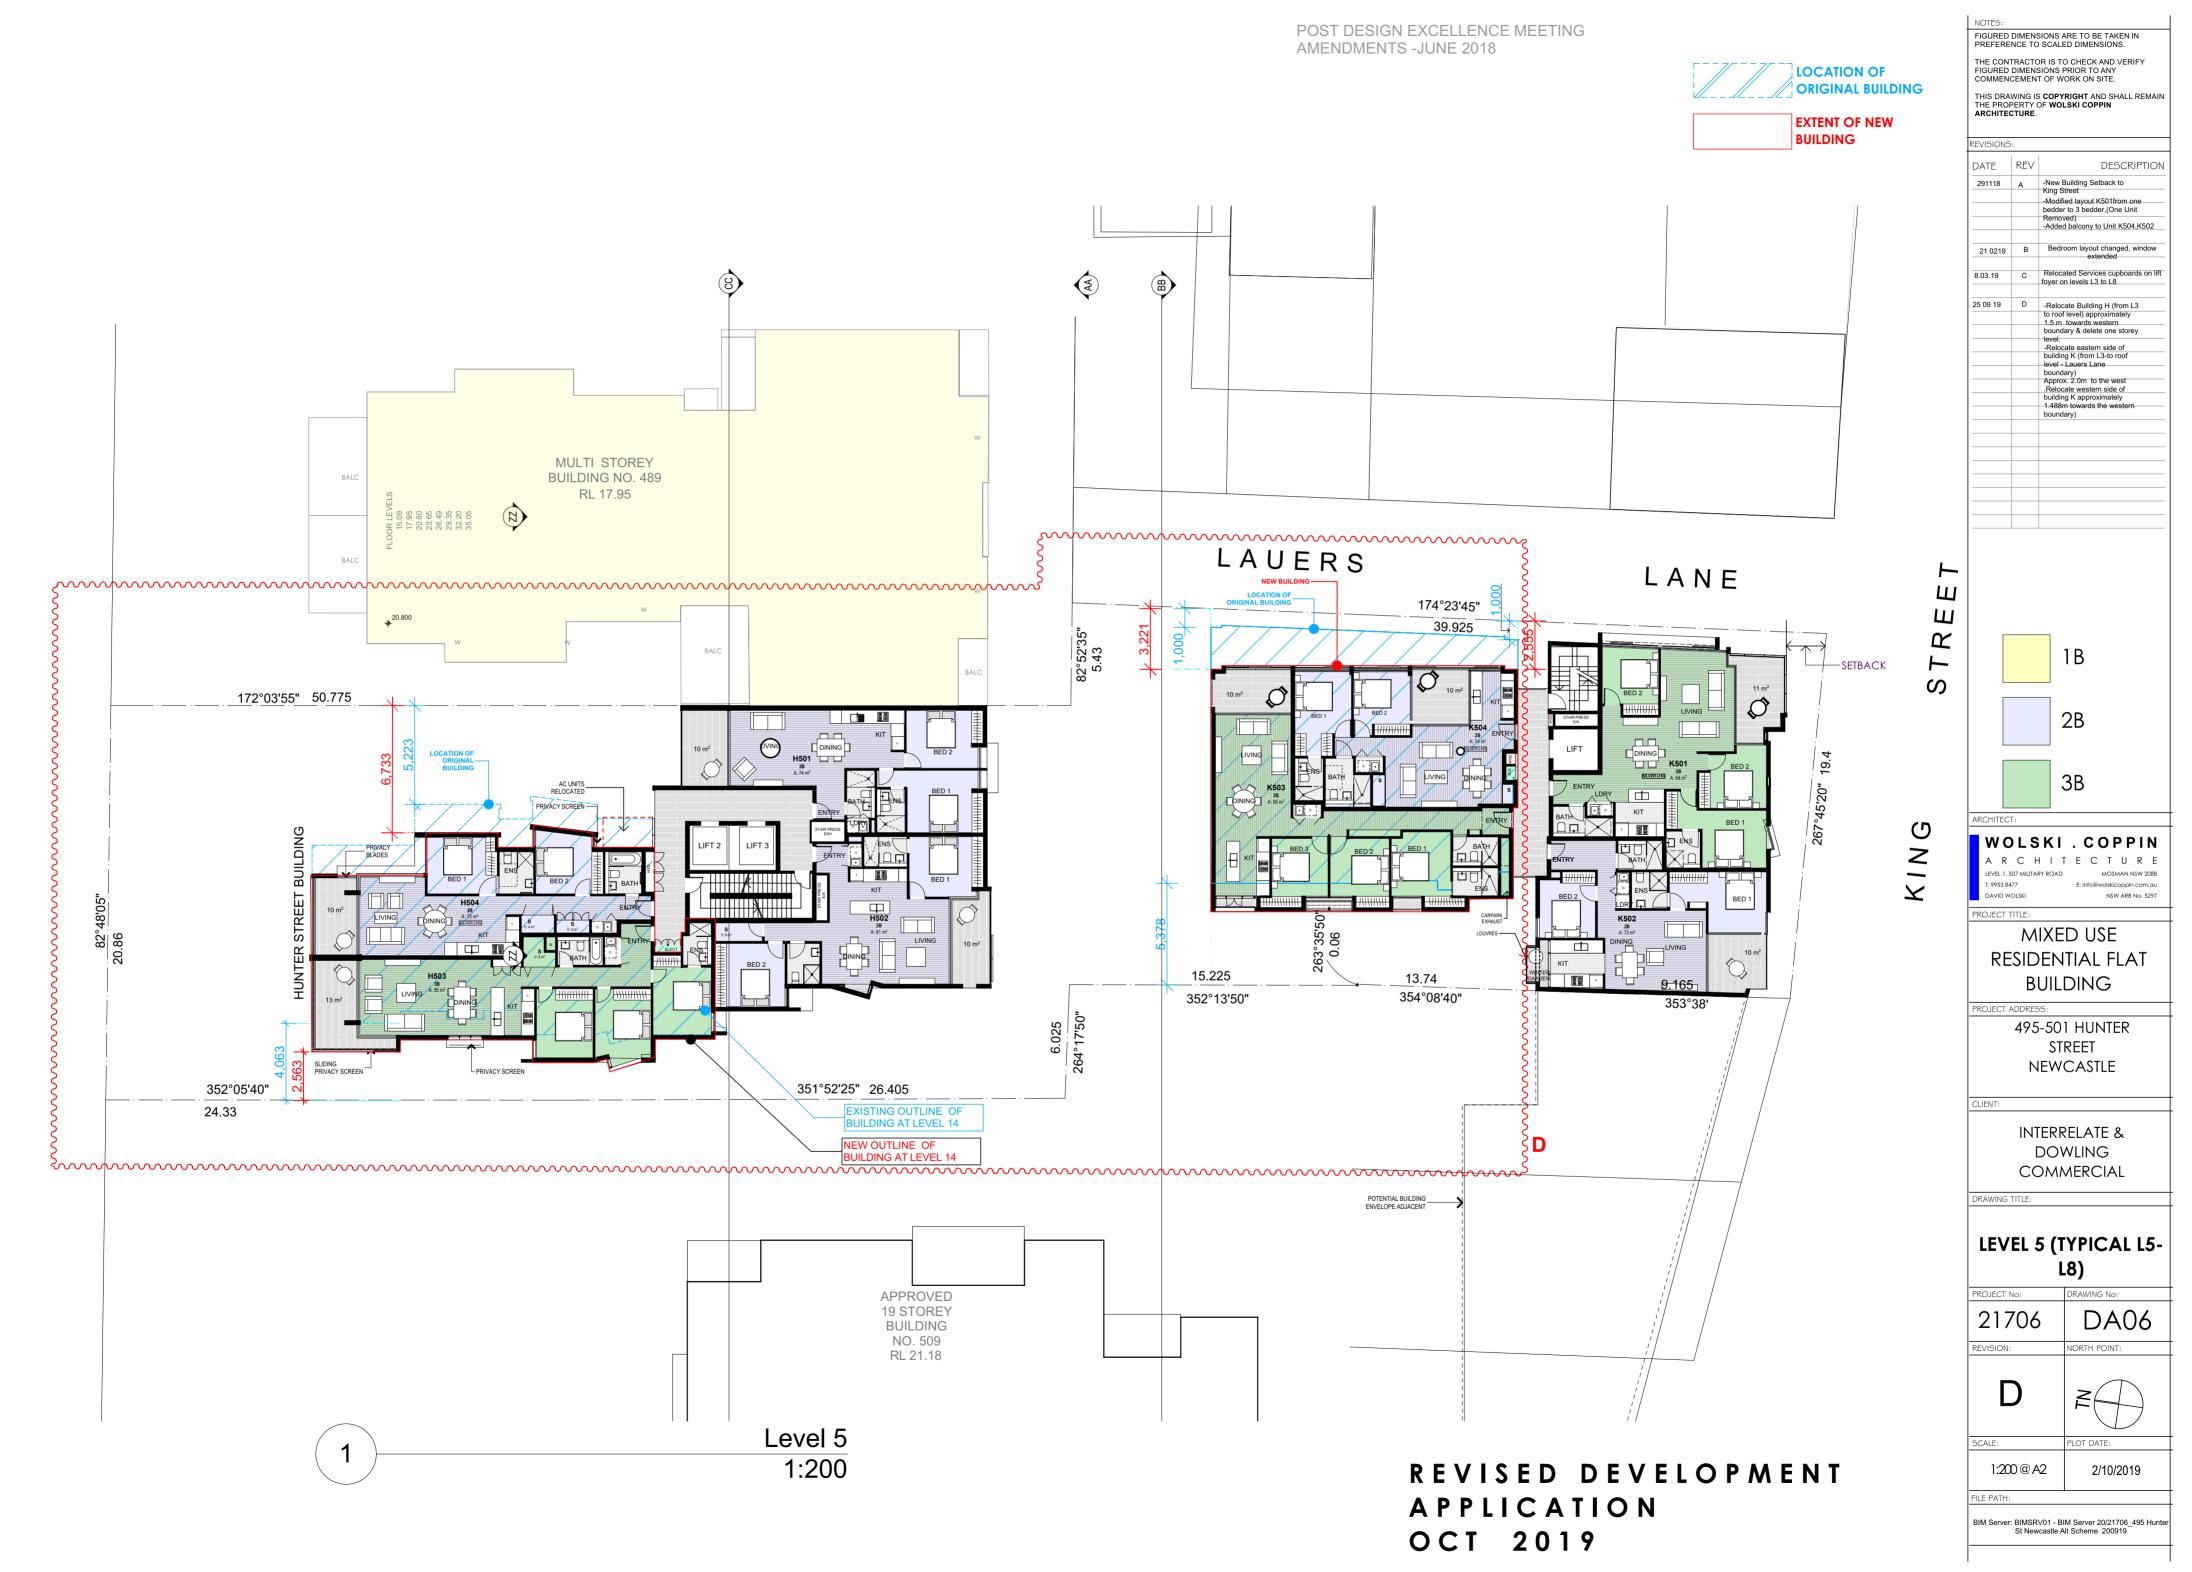


Т

Ш

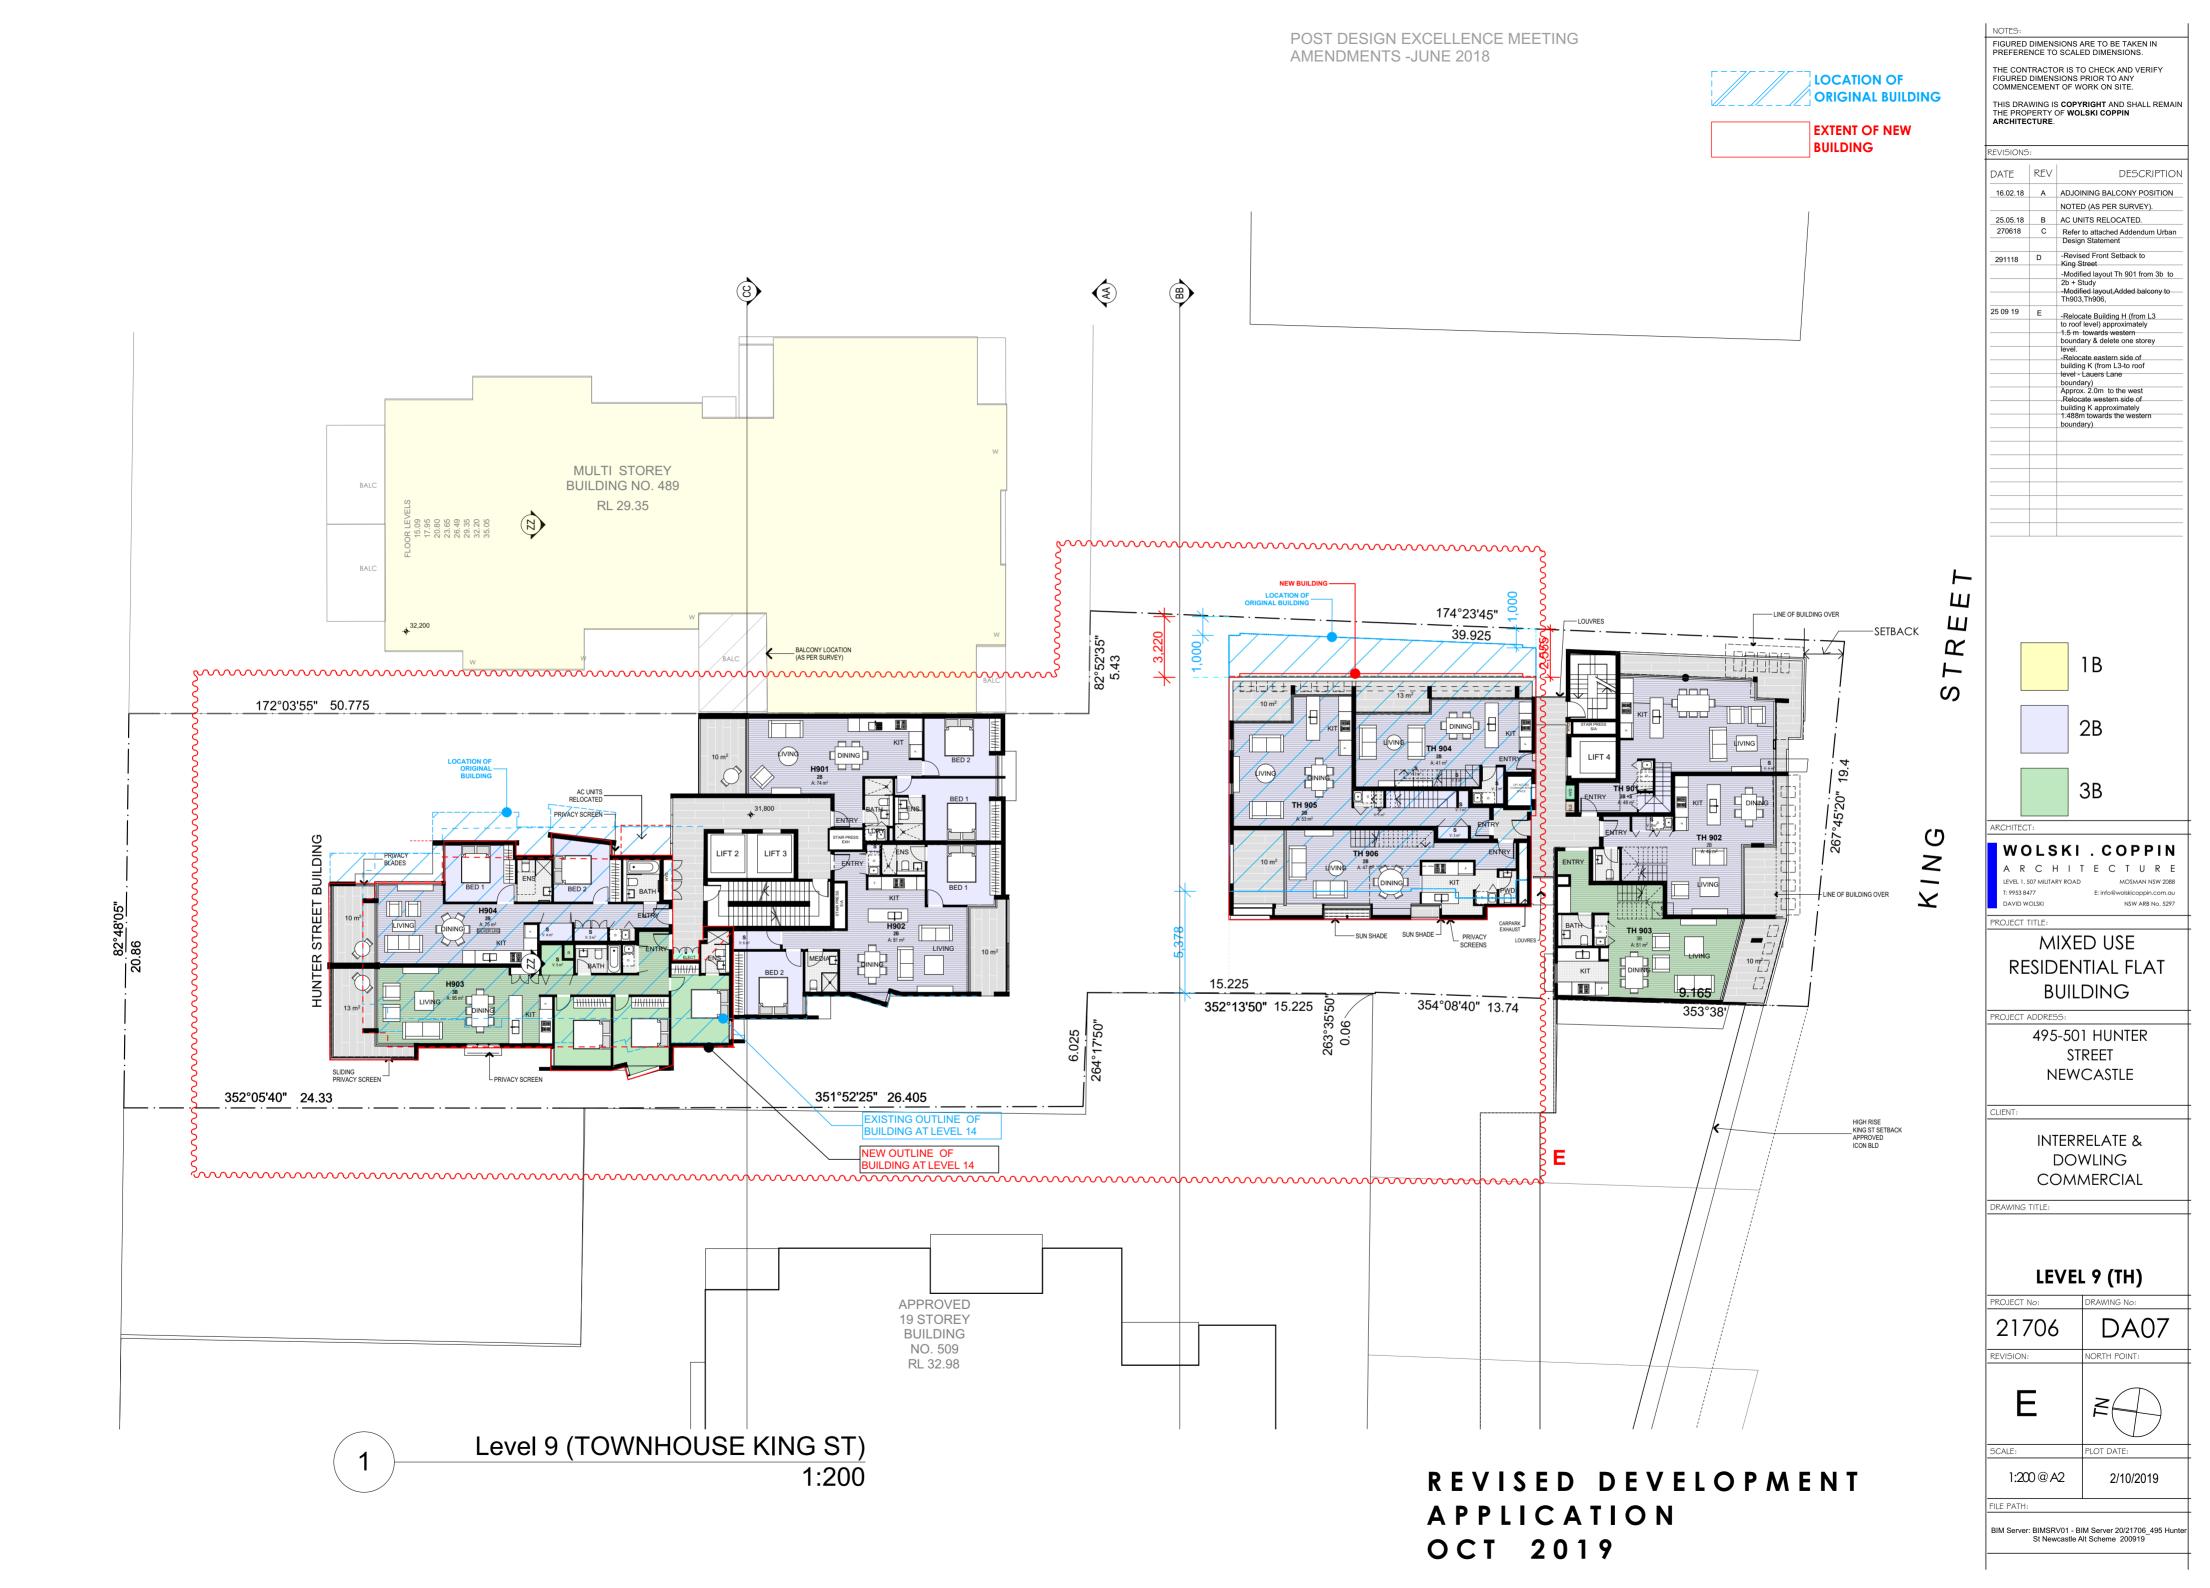



 \vdash

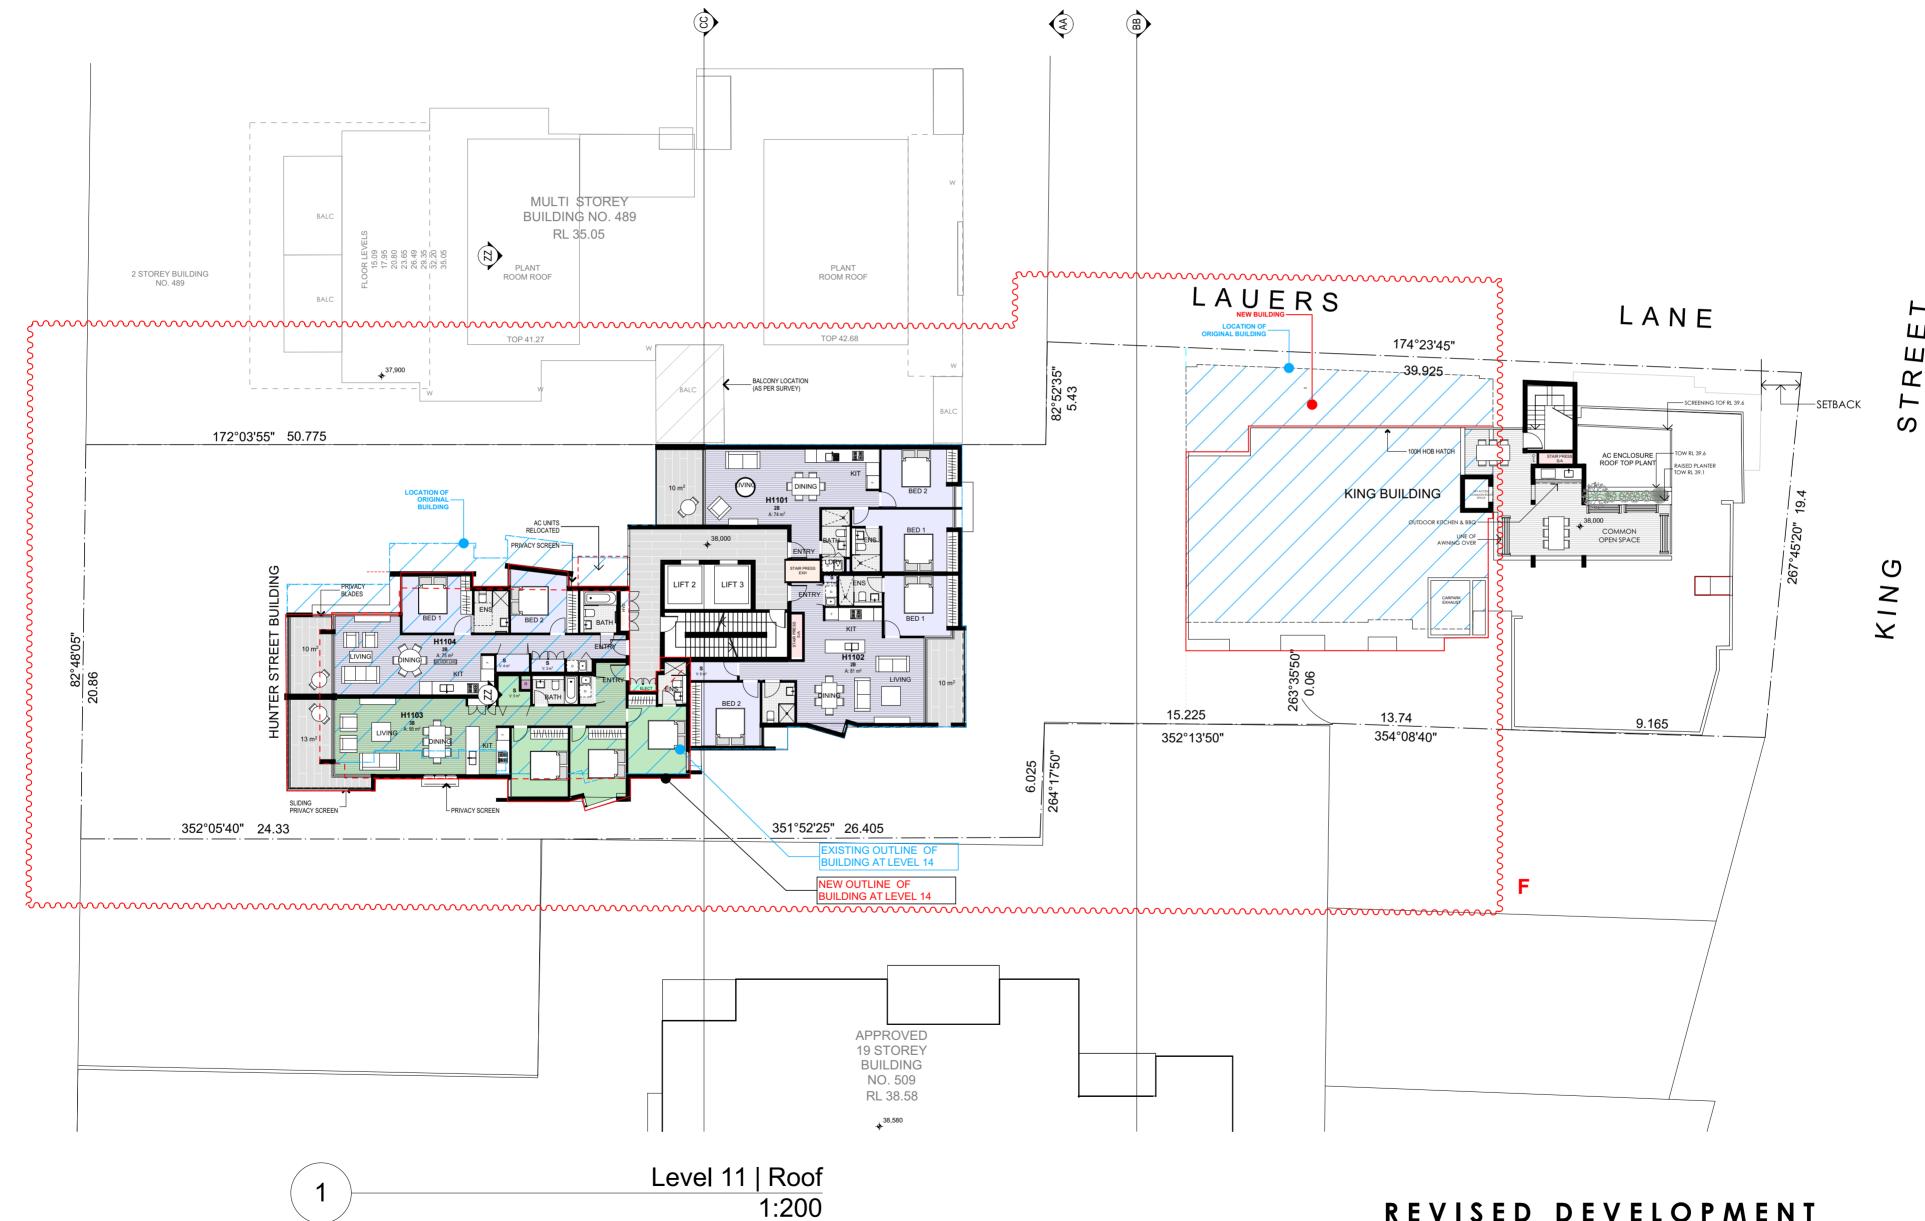

ш ш \mathcal{L} \vdash S \mathbf{r} Ш \vdash Ζ \supset Т

 \vdash





EXTENT OF NEW BUILDING

THE CONT FIGURED I COMMENC		SIONS ARE TO BE TAKEN IN
COMMENC	RACTO	D SCALED DIMENSIONS. OR IS TO CHECK AND VERIFY
THE	DIMENS	SIONS PRIOR TO ANY IT OF WORK ON SITE.
THE PROP	PERTY	S COPYRIGHT AND SHALL REMAIN OF WOLSKI COPPIN
ARCHITEC	TURE.	
REVISIONS		1
DATE	REV	
16.02.18	A	ADJOINING BALCONY POSITION NOTED (AS PER SURVEY).
25.05.18 28.05.18	B C	AC UNITS RELOCATED. SKYLIGHT ADDEDTO ROOF OVER
270618	D	TH902 Refer to attached Addendum Urban
		Design Statement - Revised Front Setback to
291118	E	- Revised Front Setback to King Street -Revised Roof
		-Revised Common Space on Street Edge
25 09 19	F	-Relocate Building H (from L3 to roof level) approximately
		1.5 m towards western boundary & delete one storey level.
		-Relocate eastern side of building K (from L3-to roof level - Lauers Lane
		Approx. 2.0m to the west .Relocate western side of
		building K approximately 1.488m towards the western
		boundary)
		2B
		3B
ARCHITECT		
		KI.COPPIN
LEVEL 1, 5	07 MILITAI	RY ROAD MOSMAN NSW 2088 E: info@wolskicoppin.com.au
		NSW ARB No. 5297
PROJECT T		
		DENTIAL FLAT
PE	• •	
RE	D	
	DDDC	ac.
RE PROJECT A		5-501 HUNTER
	495	5-501 HUNTER STREET
	495	5-501 HUNTER
PROJECT A	495	5-501 HUNTER STREET
	495 N	5-501 HUNTER STREET IEWCASTLE
PROJECT A	495 N	5-501 HUNTER STREET IEWCASTLE TERRELATE &
PROJECT A	495 N IN1	5-501 HUNTER STREET IEWCASTLE
PROJECT A	495 N IN1 [CC	5-501 HUNTER STREET IEWCASTLE IERRELATE & DOWLING
PROJECT A	495 N IN1 [CC	5-501 HUNTER STREET IEWCASTLE IERRELATE & DOWLING
PROJECT A	495 N IN1 [CC	5-501 HUNTER STREET IEWCASTLE IERRELATE & DOWLING
PROJECT A	495 N INT [CC	5-501 HUNTER STREET IEWCASTLE IERRELATE & DOWLING
PROJECT A	495 N INT CC TTTLE:	5-501 HUNTER STREET IEWCASTLE IERRELATE & DOWLING DMMERCIAL
PROJECT A CLIENT: DRAWING 1 LE' PROJECT N	495 N INT [CC TITLE: VEI	5-501 HUNTER STREET IEWCASTLE IERRELATE & DOWLING DMMERCIAL
CLIENT:	495 N INT [CC TITLE: VEI	5-501 HUNTER STREET IEWCASTLE IERRELATE & DOWLING DMMERCIAL
CLIENT: DRAWING T LEE PROJECT N 217	495 N INT [CC TITLE: VEI	5-501 HUNTER STREET IEWCASTLE TERRELATE & DOWLING DMMERCIAL
CLIENT: DRAWING T LEE PROJECT N 217	495 N INT [CC TITLE: VEI	5-501 HUNTER STREET IEWCASTLE TERRELATE & DOWLING DMMERCIAL
CLIENT: DRAWING T LEE PROJECT N 217	495 N INT [CC TITLE: VEI	5-501 HUNTER STREET IEWCASTLE TERRELATE & DOWLING DMMERCIAL
CLIENT: DRAWING T LEE PROJECT N 217	495 N INT [CC TITLE: VEI	5-501 HUNTER STREET IEWCASTLE TERRELATE & DOWLING DMMERCIAL
PROJECT A CLIENT: DRAWING T LEE' PROJECT N 217 REVISION: F SCALE:	495 N INT [CC TITLE: VEI	5-501 HUNTER STREET JEWCASTLE IERRELATE & DOWLING DMMERCIAL DRAWING NO: DA09 NORTH POINT: PLOT DATE:


BIM Server: BIMSRV01 - BIM Server 20/21706_495 Hunte St Newcastle Alt Scheme 200919

 \vdash

Ш

Ш

REVISED DEVELOPMENT APPLICATION OCT 2019

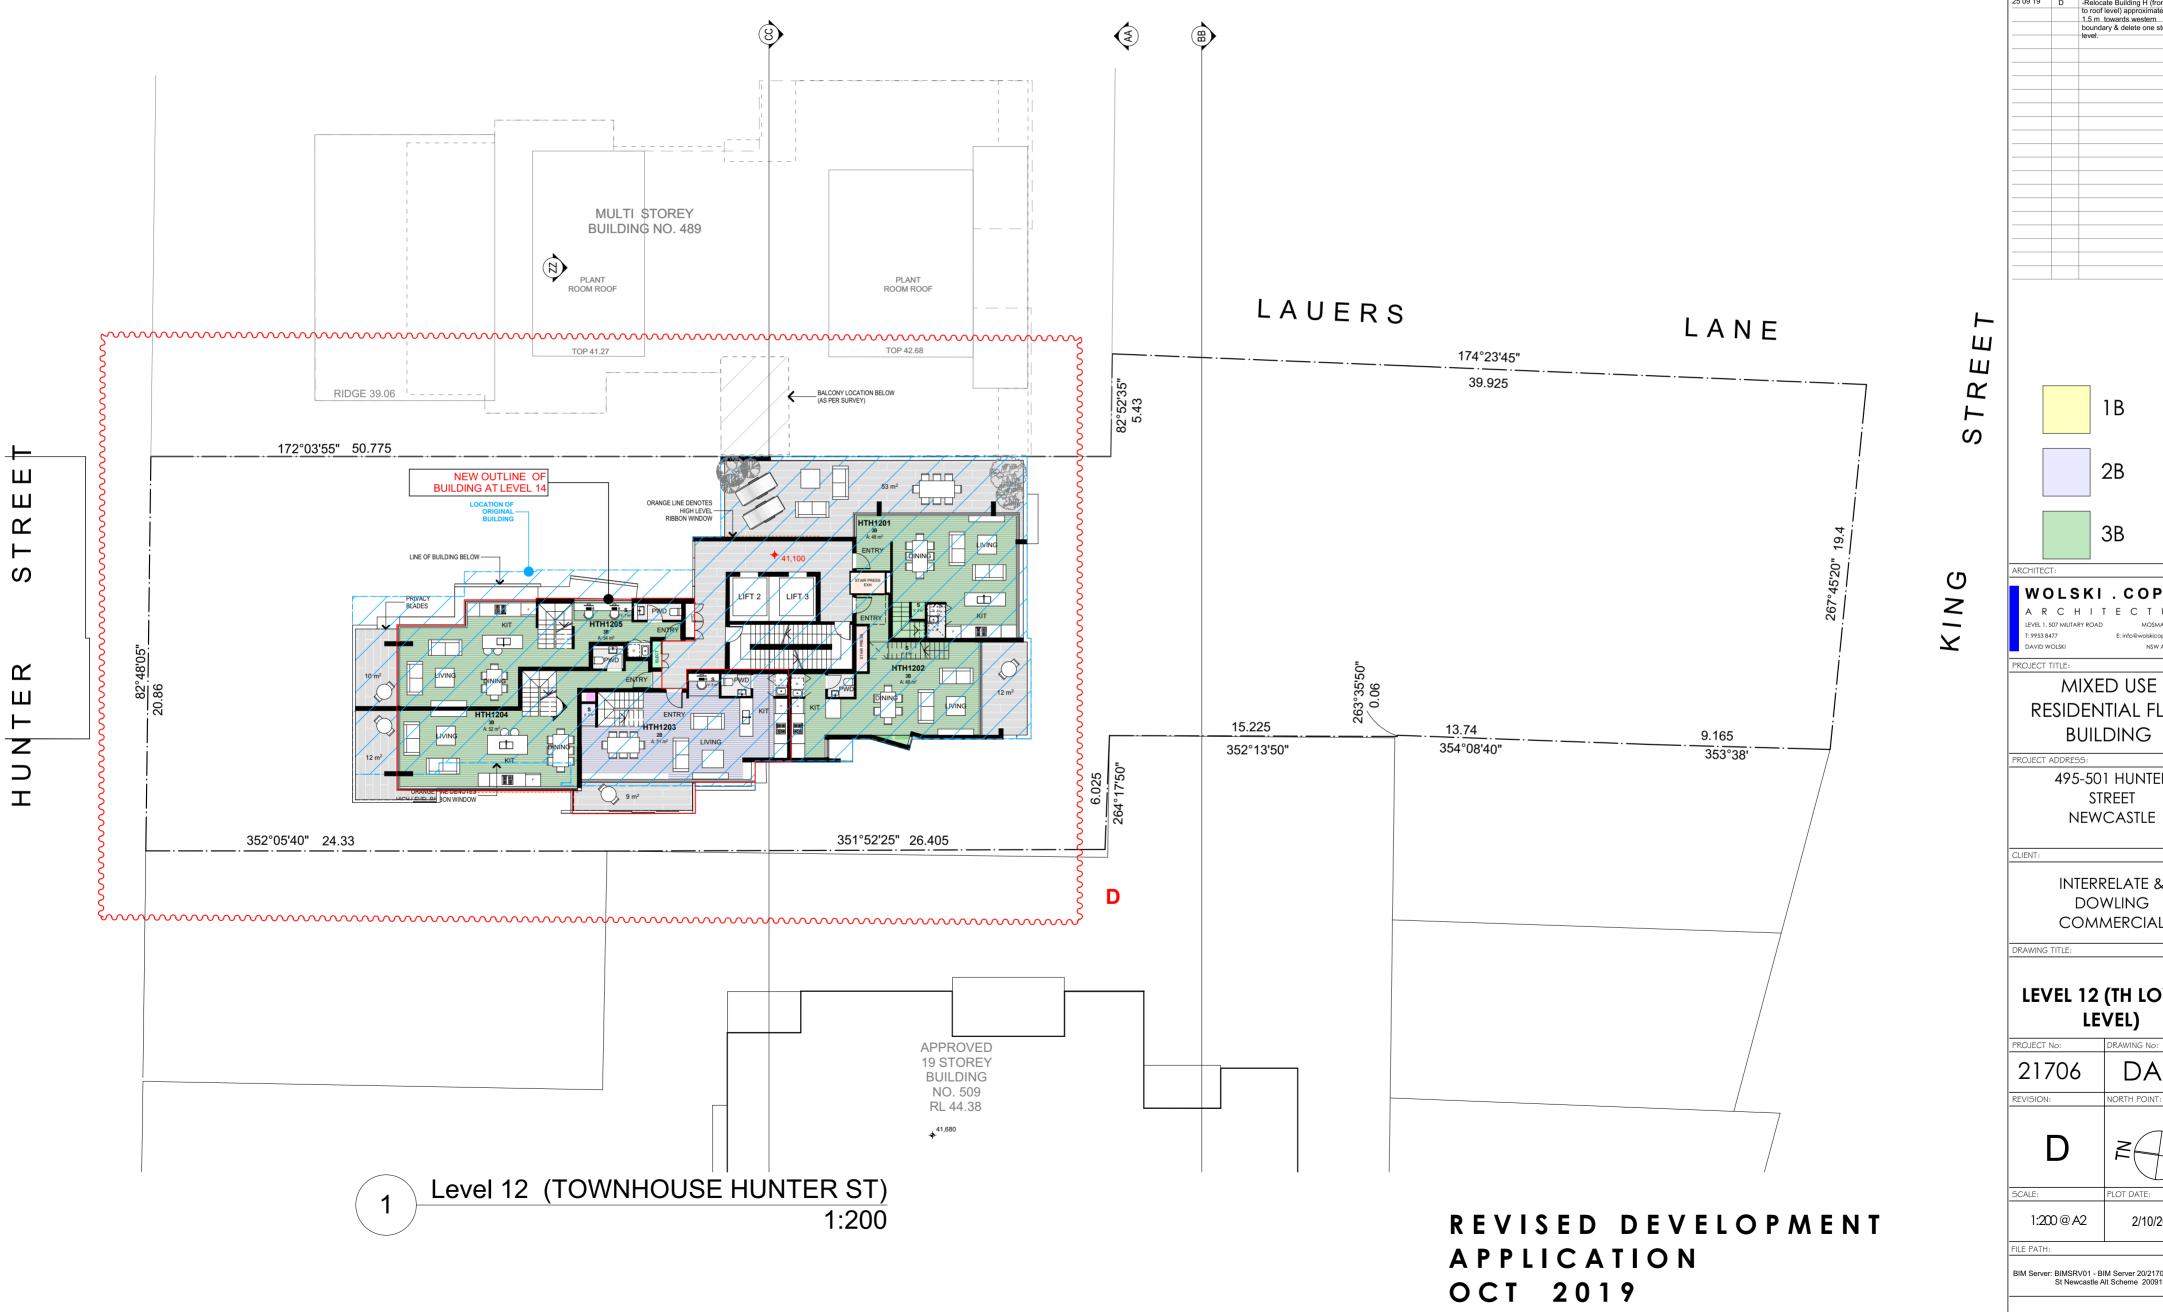






EXTENT OF NEW BUILDING

FIGURED	DIMEN	DR IS TO CHECK AND VERIFY SIONS PRIOR TO ANY T OF WORK ON SITE.
THIS DRA THE PROF ARCHITEC	PERTY	S Copyright and shall remain of Wolski Coppin
REVISIONS	:	
DATE	REV	
25.05.18	B	ADJOINING BALCONY POSITION NOTED (AS PER SURVEY). AC UNITS RELOCATED.
270618	С	Refer to attached Addendum Urban Design Statement
25 09 19	D	-Relocate Building H (from L3 to roof level) approximately 1.5 m towards western boundary & delete one storey
		level.
		10
		1B
		2B
		3B
		KI.COPPIN
A R	CH	HITECTURE RY ROAD MOSMAN NSW 2088
T: 9953 84 DAVID W	77	E: info@wolskicoppin.com.au NSW ARB No. 5297
PROJECT 1		IXED USE
RE		ENTIAL FLAT
	В	UILDING
PROJECT /		5-501 HUNTER
		STREET
	N	IEWCASTLE
CLIENT:		
		IERRELATE & DOWLING
	СС	OMMERCIAL
DRAWING	TITLE:	
LEV	ΈL	12 (TH LOWER LEVEL)
PROJECT N	10:	DRAWING No:
217	706	5 DA10
REVISION:		NORTH POINT:
I	C	Z
SCALE:		PLOT DATE:
		0
1:20	0@A	2 2/10/2019

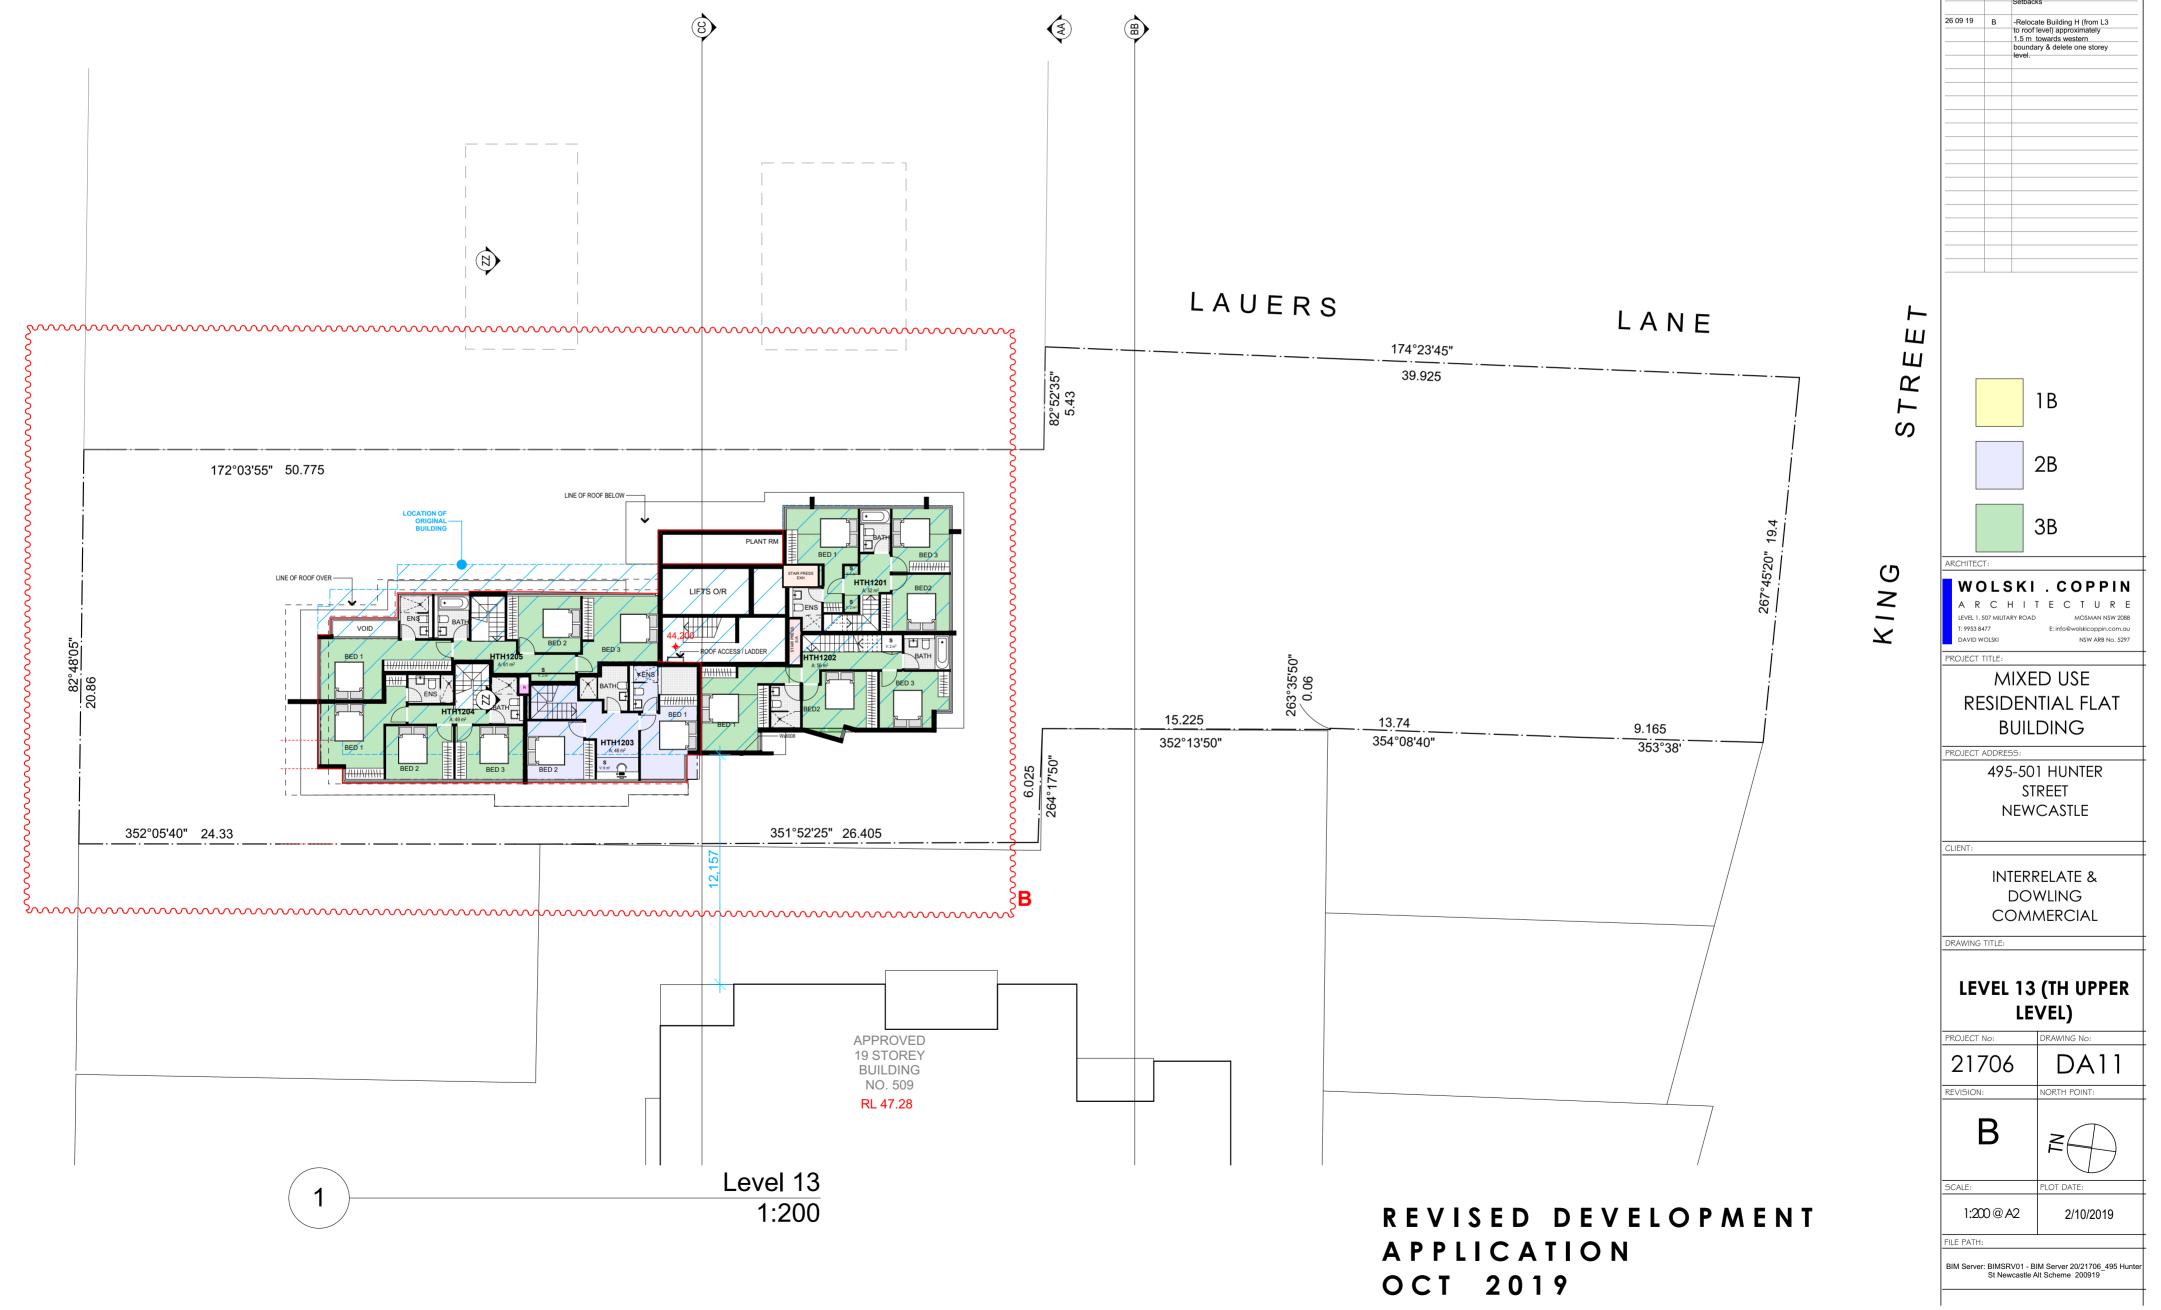

ш ш Ц \vdash S \mathcal{L} Ш \vdash Ζ \supset Т


 \vdash





EXTENT OF NEW BUILDING

FIGURED	DIMEN	O SCALED DIMENSIONS. OR IS TO CHECK AND VERIFY SIONS PRIOR TO ANY
THIS DR	AWING I	IT OF WORK ON SITE. S COPYRIGHT AND SHALL REMAII OF WOLSKI COPPIN
REVISION		
DATE	REV	DESCRIPTIO
25 09 19	А	-Relocate Building K (from L3 -roof level) 1.50m towards
		west boundary & delete one storey level.
		-Building H Relocate 1.02 m from Lauers Lane boundary.
		(from L4 - to roof level) -Added Setback dimensions
		(showing Original Da & new Setbacks
26 09 19	в	-Relocate Building H (from L3
		to roof level) approximately 1.5 m towards western boundary & delete one storey
		level.
		1B
		2B
-		
		ЗВ
		20
		50
ARCHITEC	 CT:	
wo	DLS	SKI . COPPIN
A R		SKI.COPPIN HITECTURE MOSMAN NSW 2088
W (A R	DLS CI 507 MILITA 3477	SKI.COPPIN HITECTURE
W C A R LEVEL 1, T: 9953 8	DLS CI 507 MILITA 3477 VOLSKI	SKI.COPPIN HITECTURE MOSMAN NSW 2088 E: Info@wolskicoppin.com.au
A R LEVEL 1, T: 99538 DAVID V	DLS CI 507 MILITA 5477 WOLSKI TITLE:	SKI.COPPIN HITECTURE MOSMAN NSW 2088 E: Info@wolskicoppin.com.au
CAR LEVEL 1, T: 9953 8 DAVID V	DLS CI 507 MILITA 5477 WOLSKI TITLE:	SKI.COPPIN HITECTURE NGSMAN NSW 2088 E: Info@wolskicoppin.com.au NSW ARB No. 5297
CAR LEVEL 1, T: 9953 8 DAVID V	DLS CI 507 MILITA 3477 WOLSKI TITLE: M ESID	SKI.COPPIN HITECTURE NGSMAN NSW 2088 E: Info@wolskicoppin.com.au NSW ARB No. 5297
CAR LEVEL 1, T: 9953 8 DAVID V	DLS CI 507 MILITA 3477 WOLSKI TITLE: M ESID	SKI.COPPIN HITECTURE NGSMAN NSW 2088 E: Info@wolskicoppin.com.au NSW ARB No. 5297
CAR LEVEL 1, T: 9953 8 DAVID V	DLS CL 507 MILTA 4477 VOLSKI TITLE: M ESIC B ADDRE	SKI.COPPIN HITECTURE MOSMAN NSV 2088 E: info®wokkcoppin.com.au NSW ARB No. 5297
RE	DLS CL 507 MILTA 4477 VOLSKI TITLE: M ESIC B ADDRE	SKI.COPPIN HITECTURE MOSMAN NSW 2088 E: Info@woldkicoppin.com.au NSW ARB NO. 5297 NIXED USE DENTIAL FLAT UILDING 55: 5-501 HUNTER
RE	DLS CI 507 MILITA 4477 VOLSKI TITLE: M ESIC B ADDRE: 495	SKI.COPPIN HITECTURE MOSMAN NSW 2088 E: Info@wolskicoppin.com.au NSW ARB No. 5297 NIXED USE DENTIAL FLAT UILDING 55: 5-501 HUNTER STREET
RE	DLS CI 507 MILITA 4477 VOLSKI TITLE: M ESIC B ADDRE: 495	SKI.COPPIN HITECTURE MOSMAN NSW 2088 E: Info@woldkicoppin.com.au NSW ARB NO. 5297 NIXED USE DENTIAL FLAT UILDING 55: 5-501 HUNTER
PROJECT	DLS CI 507 MILITA 4477 VOLSKI TITLE: M ESIC B ADDRE: 495	SKI.COPPIN HITECTURE MOSMAN NSW 2088 E: Info@wolskicoppin.com.au NSW ARB No. 5297 NIXED USE DENTIAL FLAT UILDING 55: 5-501 HUNTER STREET
RE PROJECT	DLS CI 507 MILITA 4477 VOLSKI TITLE: M ESIC B ADDRE: 495	SKI.COPPIN HITECTURE MOSMAN NSW 2088 E: Info@wolskicoppin.com.au NSW ARB No. 5297 NIXED USE DENTIAL FLAT UILDING 55: 5-501 HUNTER STREET
RE	DLS CI 507 MILITA 4477 WOLSKI TITLE: M ESIC B ADDRE: 495	SKI.COPPIN HITECTURE MOSMAN NSW 2088 E: Info@wolskicoppin.com.au NSW ARB No. 5297 NIXED USE DENTIAL FLAT UILDING 55: 5-501 HUNTER STREET
RE PROJECT	DLS CI 507 MILITA 507 MILITA 507 MILITA 4475 ADDRE 495 N	KI.COPPIN HITECTURE MOSMAN NSW 2088 E: info@woldkicoppin.com.au NSW ARB No. 5297 NIXED USE DENTIAL FLAT UILDING 55: 5-501 HUNTER STREET NEWCASTLE
PROJECT	DLS CI 507 MILITA 507 MILITA 507 MILITA WOLSKI TITTLE: M SSID B ADDRE: 495	SKI.COPPIN HITECTURE MOSMAN NSW 2088 E: Info@wolkicoppin.com.au NSW ARB No. 5297 NIXED USE DENTIAL FLAT UILDING 55: 5-501 HUNTER STREET NEWCASTLE
PROJECT	DLS CI 507 MILITA 1477 WOLSKI TITLE: M ESIC B ADDRE: 495	SKI.COPPIN HITECTURE MOSMAN NSW 2088 E: Info@wolkicoppin.com.cu NSW ARB NO. 5297 NIXED USE DENTIAL FLAT UILDING 55: 5-501 HUNTER STREET NEWCASTLE TERRELATE & DOWLING
PROJECT CLIENT:	DLS CI 507 MILITA 1477 WOLSKI TITLE: M ESIC B ADDRE: 495	SKI.COPPIN HITECTURE MOSMAN NSW 2088 E: Info@wolkicoppin.com.cu NSW ARB NO. 5297 NIXED USE DENTIAL FLAT UILDING 55: 5-501 HUNTER STREET NEWCASTLE TERRELATE & DOWLING
PROJECT CLIENT: DRAWING	DLS CI 507 MILITA 4477 WOLSKI TITLE: M SIC B ADDRE: 495 N IN CC	SKI.COPPIN HITECTURE MOSMAN NSW 2088 E: Info@wolkicoppin.com.au NSW ARB NO. 5297 NIXED USE DENTIAL FLAT UILDING 55: 5-501 HUNTER STREET NEWCASTLE TERRELATE & DOWLING DMMERCIAL
PROJECT CLIENT: DRAWING	DLS CI 507 MILITA 4477 WOLSKI TITLE: M SIC B ADDRE: 495 N IN CC	SKI.COPPIN HITECTURE MOSMAN NSW 2088 E: Info@wolkicoppin.com.cu NSW ARB NO. 5297 NIXED USE DENTIAL FLAT UILDING 55: 5-501 HUNTER STREET NEWCASTLE TERRELATE & DOWLING DMMERCIAL
PROJECT CLIENT: DRAWING	DLS CI 507 MILITA 4477 WOLSKI TITLE: M SIC B ADDRE: 495 N IN CC	SKI.COPPIN HITECTURE MOSMAN NSW 2088 E: Info@wolkicoppin.com.au NSW ARB NO. 5297 NIXED USE DENTIAL FLAT UILDING 55: 5-501 HUNTER STREET NEWCASTLE TERRELATE & DOWLING DMMERCIAL
PROJECT CLIENT: DRAWING	DLS CI 507 MILITA 4477 WOLSKI TITTLE: M ESIC B ADDRE: 495 N IN CC TITTLE:	SKI.COPPIN HITECTURE MOSMAN NSW 2088 E: Info@wolkicoppin.com.cu NSW ARB NO. 5297 NIXED USE DENTIAL FLAT UILDING 55: 5-501 HUNTER STREET NEWCASTLE TERRELATE & DOWLING DMMERCIAL
PROJECT CLIENT: DRAWING PROJECT	DLS CI 507 MILITA 1477 VOLSKI TITLE: M SSIC B ADDRE: 495 N IN CC TITLE: VEL	SKI.COPPIN HITECTURE MOSMAN NSW 2088 E:Info@volkicoppin.com.ou NSW ARB No. 5297 NIXED USE DENTIAL FLAT UILDING 55: 5-501 HUNTER STREET NEWCASTLE TERRELATE & DOWLING DMMERCIAL 13 (TH UPPER LEVEL) DRAWING No:
PROJECT CLIENT: DRAWING DRA	DLS CI 507 MILITA 4477 WOLSKI TITTLE: M SIC B ADDRE: 495 N IN CC TITTLE: VEL	SKI.COPPIN HITECTURE MOSMAN NSW 2088 E:Info@volkicoppin.com.ou NSW ARB No. 5297 NIXED USE DENTIAL FLAT UILDING 55: 5-501 HUNTER STREET NEWCASTLE TERRELATE & DOWLING DMMERCIAL 13 (TH UPPER LEVEL) DRAWING No:
PROJECT CLIENT: DRAWING PROJECT	DLS CI 507 MILITA 4477 WOLSKI TITTLE: M SIC B ADDRE: 495 N IN CC TITTLE: VEL	SKI.COPPIN HITECTURE MOSMAN NSW 2088 E:Info@volkicoppin.com.ou NSW ARB No. 5297 NIXED USE DENTIAL FLAT UILDING 55: 5-501 HUNTER STREET NEWCASTLE TERRELATE & DOWLING DMMERCIAL 13 (TH UPPER LEVEL) DRAWING No:
PROJECT CLIENT: DRAWING DRA	DLS CI 507 MILITA 4477 WOLSKI TITTLE: M SIC B ADDRE: 495 N IN CC TITTLE: VEL	SKI.COPPIN HITECTURE MOSMAN NSW 2088 E: Info@wolkicoppin.com.cu NSW ARB NO. 5297 NIXED USE DENTIAL FLAT UILDING 55: 5-501 HUNTER STREET JEWCASTLE TERRELATE & DOWLING DMMERCIAL 13 (TH UPPER LEVEL) DRAWING NO: 5 DA11
REVISION	DLS CI 507 MILITA 4477 WOLSKI TITTLE: M SIC B ADDRE: 495 N IN CC TITTLE: VEL	SKI.COPPIN HITECTURE MOSMAN NSW 2088 E: Info@wolkicoppin.com.com NSW ARB No. 5297 NIXED USE DENTIAL FLAT UILDING 55: 5-501 HUNTER STREET NEWCASTLE TERRELATE & DOWLING DMMERCIAL 13 (TH UPPER LEVEL) DRAWING No: 5 DA111 NORTH POINT:
PROJECT CLIENT: DRAWING DRA	DLS CI 507 MILITA 4477 WOLSKI TITTLE: M SIC B ADDRE: 495 N IN CC TITTLE: VEL	SKI.COPPIN HITECTURE MOSMAN NSW 2008 E: Info@wolkicoppin.com.cu NSW ARB NO. 5297 NIXED USE DENTIAL FLAT UILDING 55: 5-501 HUNTER STREET JEWCASTLE TERRELATE & DOWLING DMMERCIAL 13 (TH UPPER LEVEL) DRAWING NO: 5 DA11
PROJECT CLIENT: CLIENT: DRAWING CRAWING CREVISION REVISION	DLS CI 507 MILITA 4477 WOLSKI TITTLE: M SIC B ADDRE: 495 N IN CC TITTLE: VEL	SKI.COPPIN HITECTURE MOSMAN NSW 2088 E: Info@wolkidcoppin.com.ou NSW ARB No. 5297 NIXED USE DENTIAL FLAT UILDING 55: 5-501 HUNTER STREET NEWCASTLE TERRELATE & DOWLING DMMERCIAL III (TH UPPER LEVEL) DRAWING NO: 5 DA111 NORTH POINT:
PROJECT CLIENT: DRAWING DRAWING CLIENT: DRAWING CLIENT: PROJECT PROJECT CLIENT: DRAWING CLIENT: 1:21		SKI.COPPIN HITECTURE MOSMAN NSW 2088 E: Info@wolkicoppin.com.cu NSW ARB NO. 5277 NIXED USE DENTIAL FLAT UILDING 55: 5-501 HUNTER STREET NEWCASTLE TERRELATE & DOWLING DAMING NO: 13 (TH UPPER LEVEL) DRAWING NO: 5 DA111 NORTH POINT: PLOT DATE:
PROJECT CLIENT: DRAWING DRAWING CLIENT: DRAWING CLIENT: PROJECT PROJECT CLIENT: DRAWING CLIENT: 1:21		SKI.COPPIN HITECTURE MOSMAN NSW 2088 E: Info@wolkicoppin.com.cu NSW ARB NO. 5277 NIXED USE DENTIAL FLAT UILDING 55: 5-501 HUNTER STREET NEWCASTLE TERRELATE & DOWLING DAMING NO: 13 (TH UPPER LEVEL) DRAWING NO: 5 DA111 NORTH POINT: PLOT DATE:
PROJECT CLIENT: DRAWING CLIENT: CLIENT: DRAWING LEY PROJECT 21,7 REVISION SCALE: 1:22 FILE PATH		SKI.COPPIN HITECTURE MOSMAN NSW 2088 E: Info@wolkicoppin.com.cu NSW ARB NO. 5277 NIXED USE DENTIAL FLAT UILDING 55: 5-501 HUNTER STREET NEWCASTLE TERRELATE & DOWLING DAMING NO: 13 (TH UPPER LEVEL) DRAWING NO: 5 DA111 NORTH POINT: PLOT DATE:
PROJECT CLIENT: DRAWING CLIENT: DRAWING LEY PROJECT 217 REVISION SCALE: 1:22 FILE PATH		SKI.COPPIN HITECTURE NOSMAN NSW 2008 E: Info@wolkicoppin.com.ou NSW ARB NO. 5297 NIXED USE DENTIAL FLAT UILDING 55: 5-501 HUNTER STREET NEWCASTLE TERRELATE & DOWLING DMMERCIAL DRAWING NO: 5 DRAWING NO: 5 DRAWING NO: 5 DRAWING NO: 5 DRAUING NORTH POINT: PLOT DATE: 42 2/10/2019

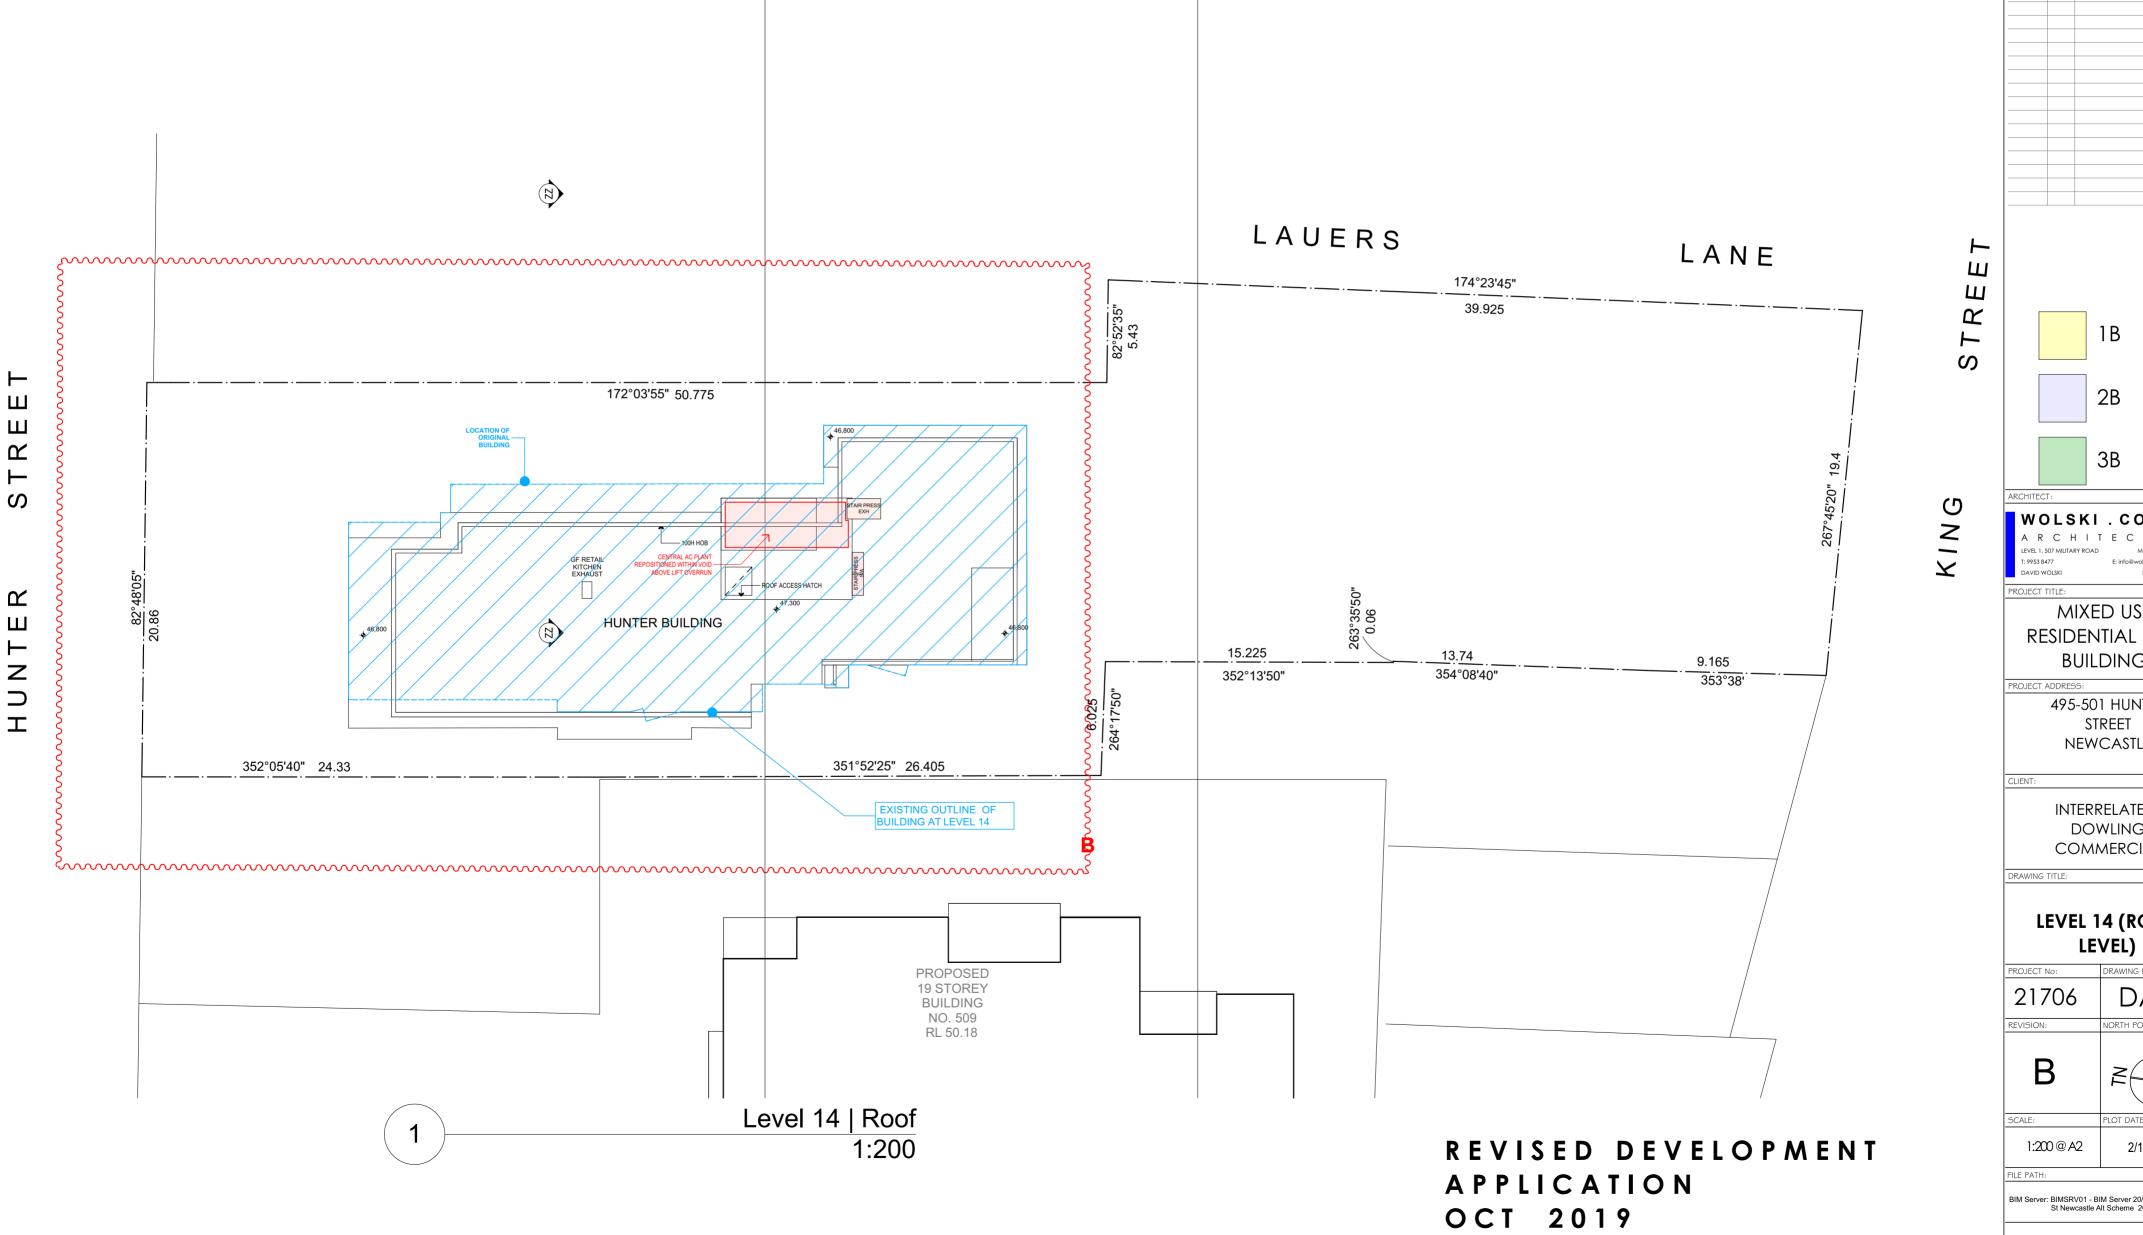


8







EXTENT OF NEW BUILDING

THE CON FIGUREE COMMEN THIS DRA	NTRACT D DIMEN NCEMEN AWING I OPERTY	D SCALED DIMENSIONS. OR IS TO CHECK AND VERIFY ISIONS PRIOR TO ANY IT OF WORK ON SITE. S COPYRIGHT AND SHALL REMAIN OF WOLSKI COPPIN .
VISION	5:	
DATE	REV	DESCRIPTION RLs added +Separation Distance at
5 09 19	В	45 M ht limit line
	В	-Relocate Building H (from L3 to roof level) approximately 1.5 m towards western
		boundary & delete one storey
		I
		1.5
		1B
L		
		2B
		20
		ЗВ
RCHITE	CT:	
		KI.COPPIN
	507 MILITA	H I T E C T U R E MCSMAN NSW 2088 E: info@wolskicoppin.com.au
DAVID		NSW ARB No. 5297
ROJECT		
RF		DENTIAL FLAT
		UILDING
ROJECT		
	493	5-501 HUNTER
		STREET VEWCASTLE
	Г	NEWCASILE
LIENT:		
	IN	TERRELATE &
		DOWLING
	C	OMMERCIAL
RAWING	; TITLE:	
	E\/	
		EL 14 (ROOF LEVEL)
ROJECT	No:	DRAWING No:
21	70/	5 DA12
		NORTH POINT:
F	3	2
L	ر	
CALE:		PLOT DATE:
	χ@/	
1:2	J) (~ '	
1:20		

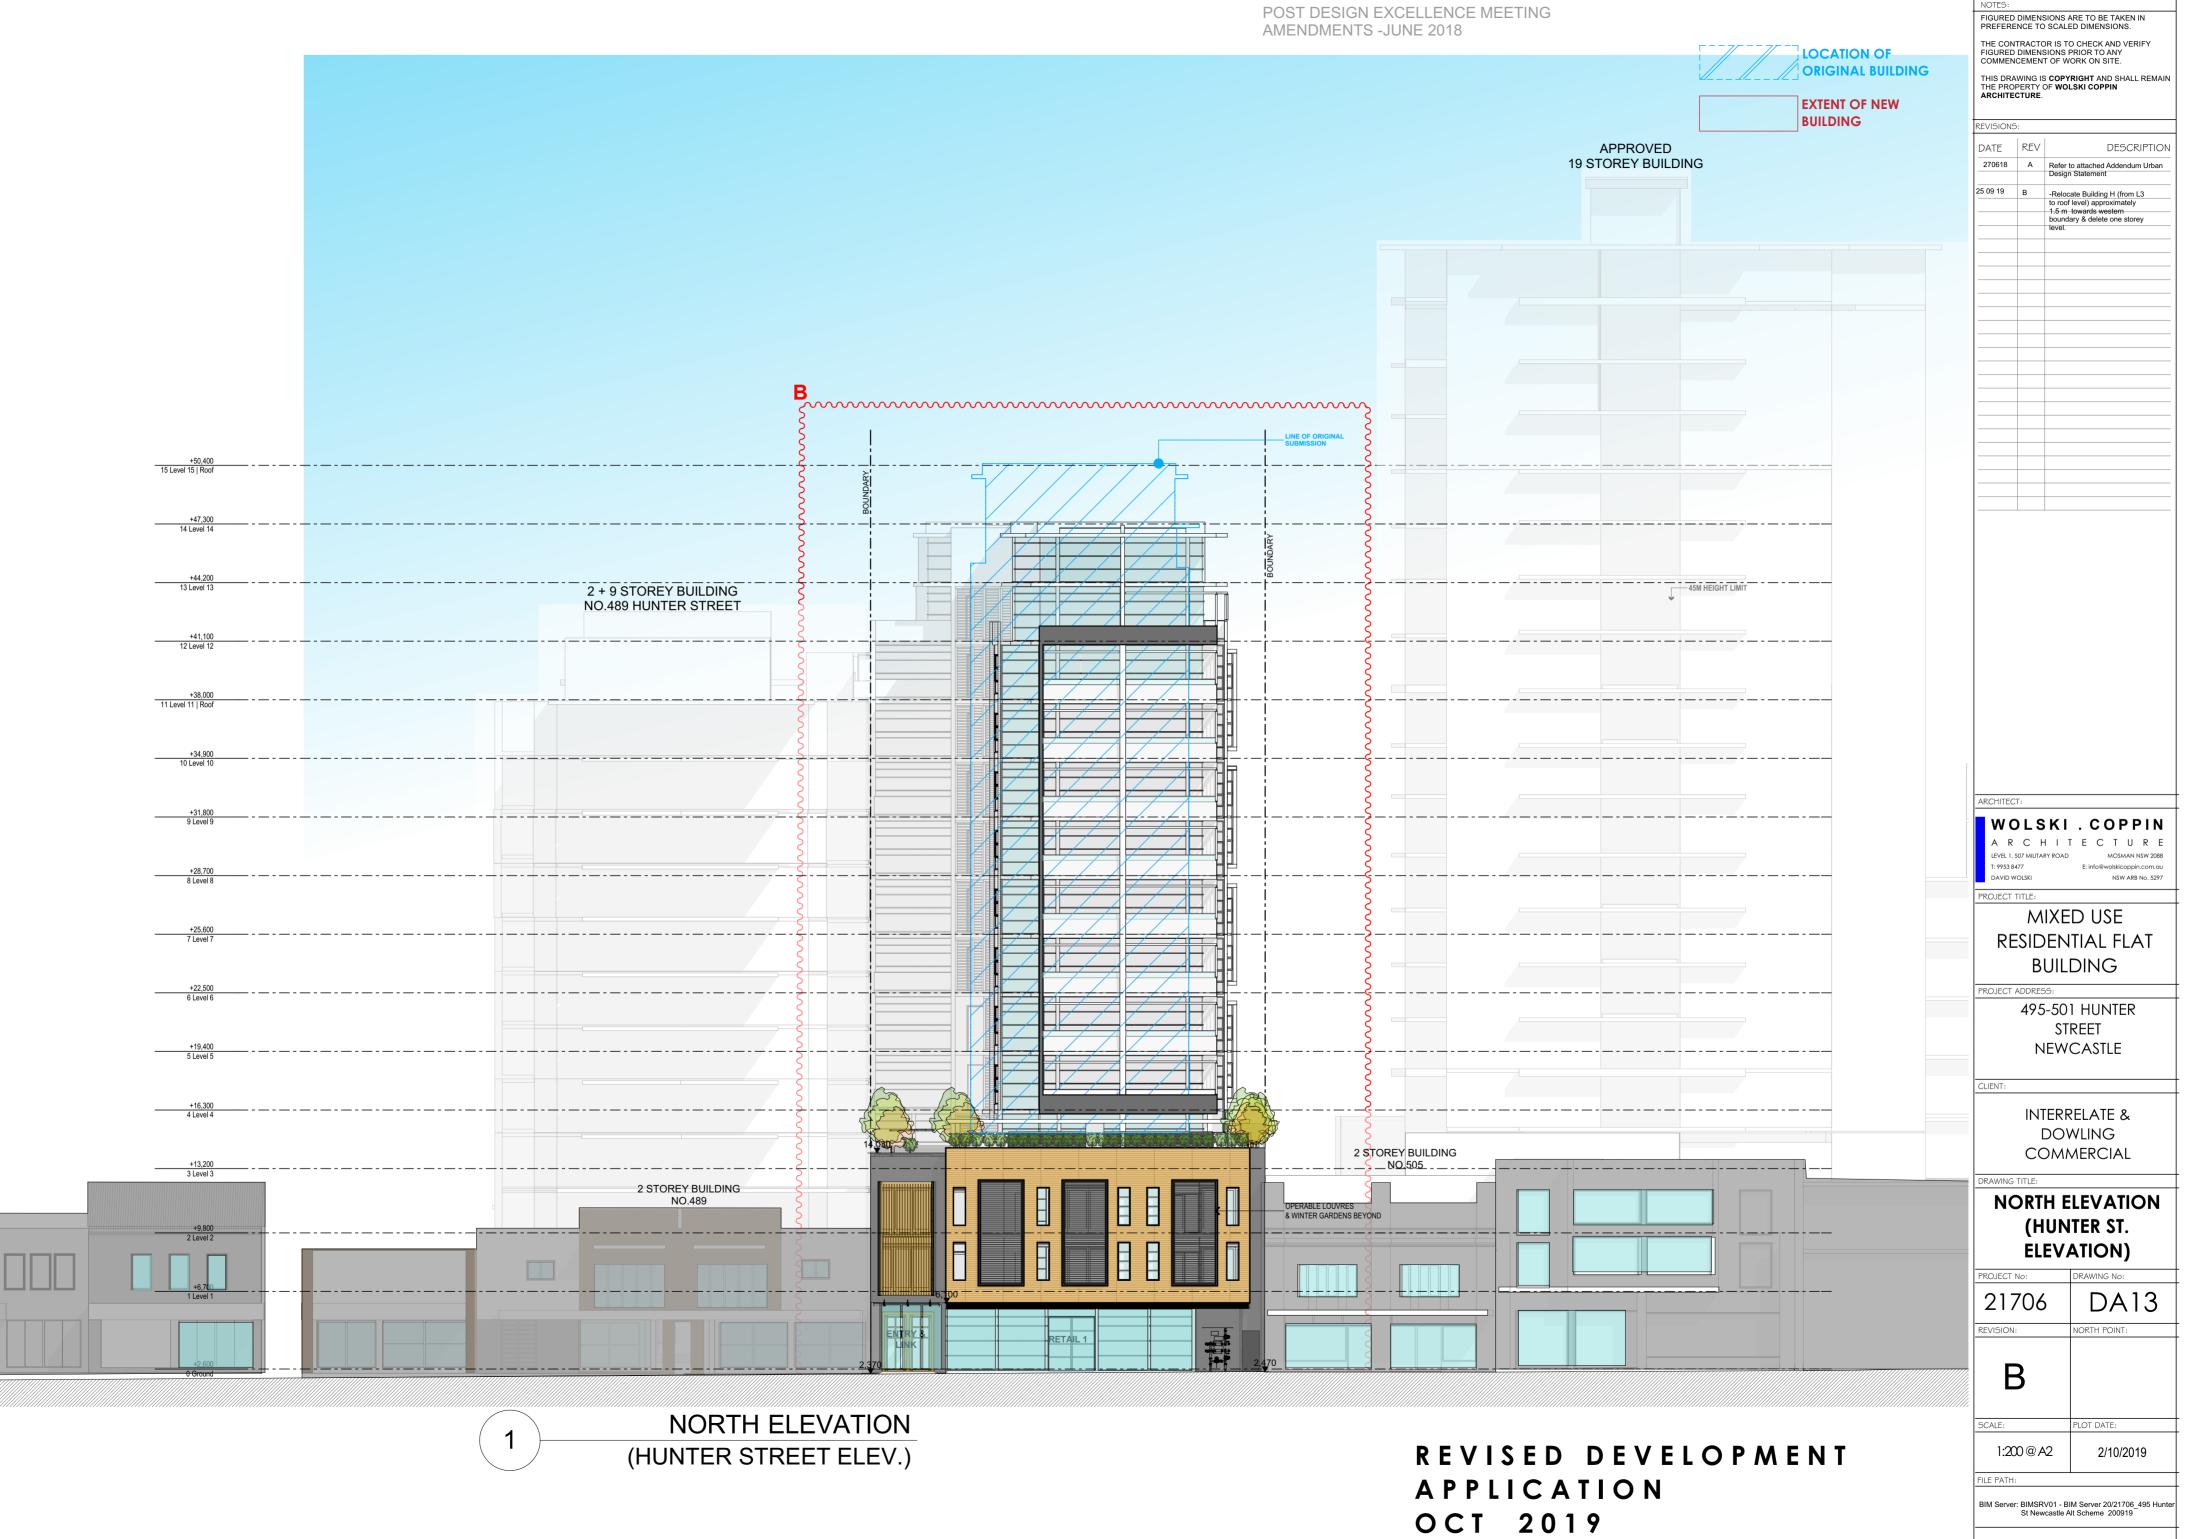

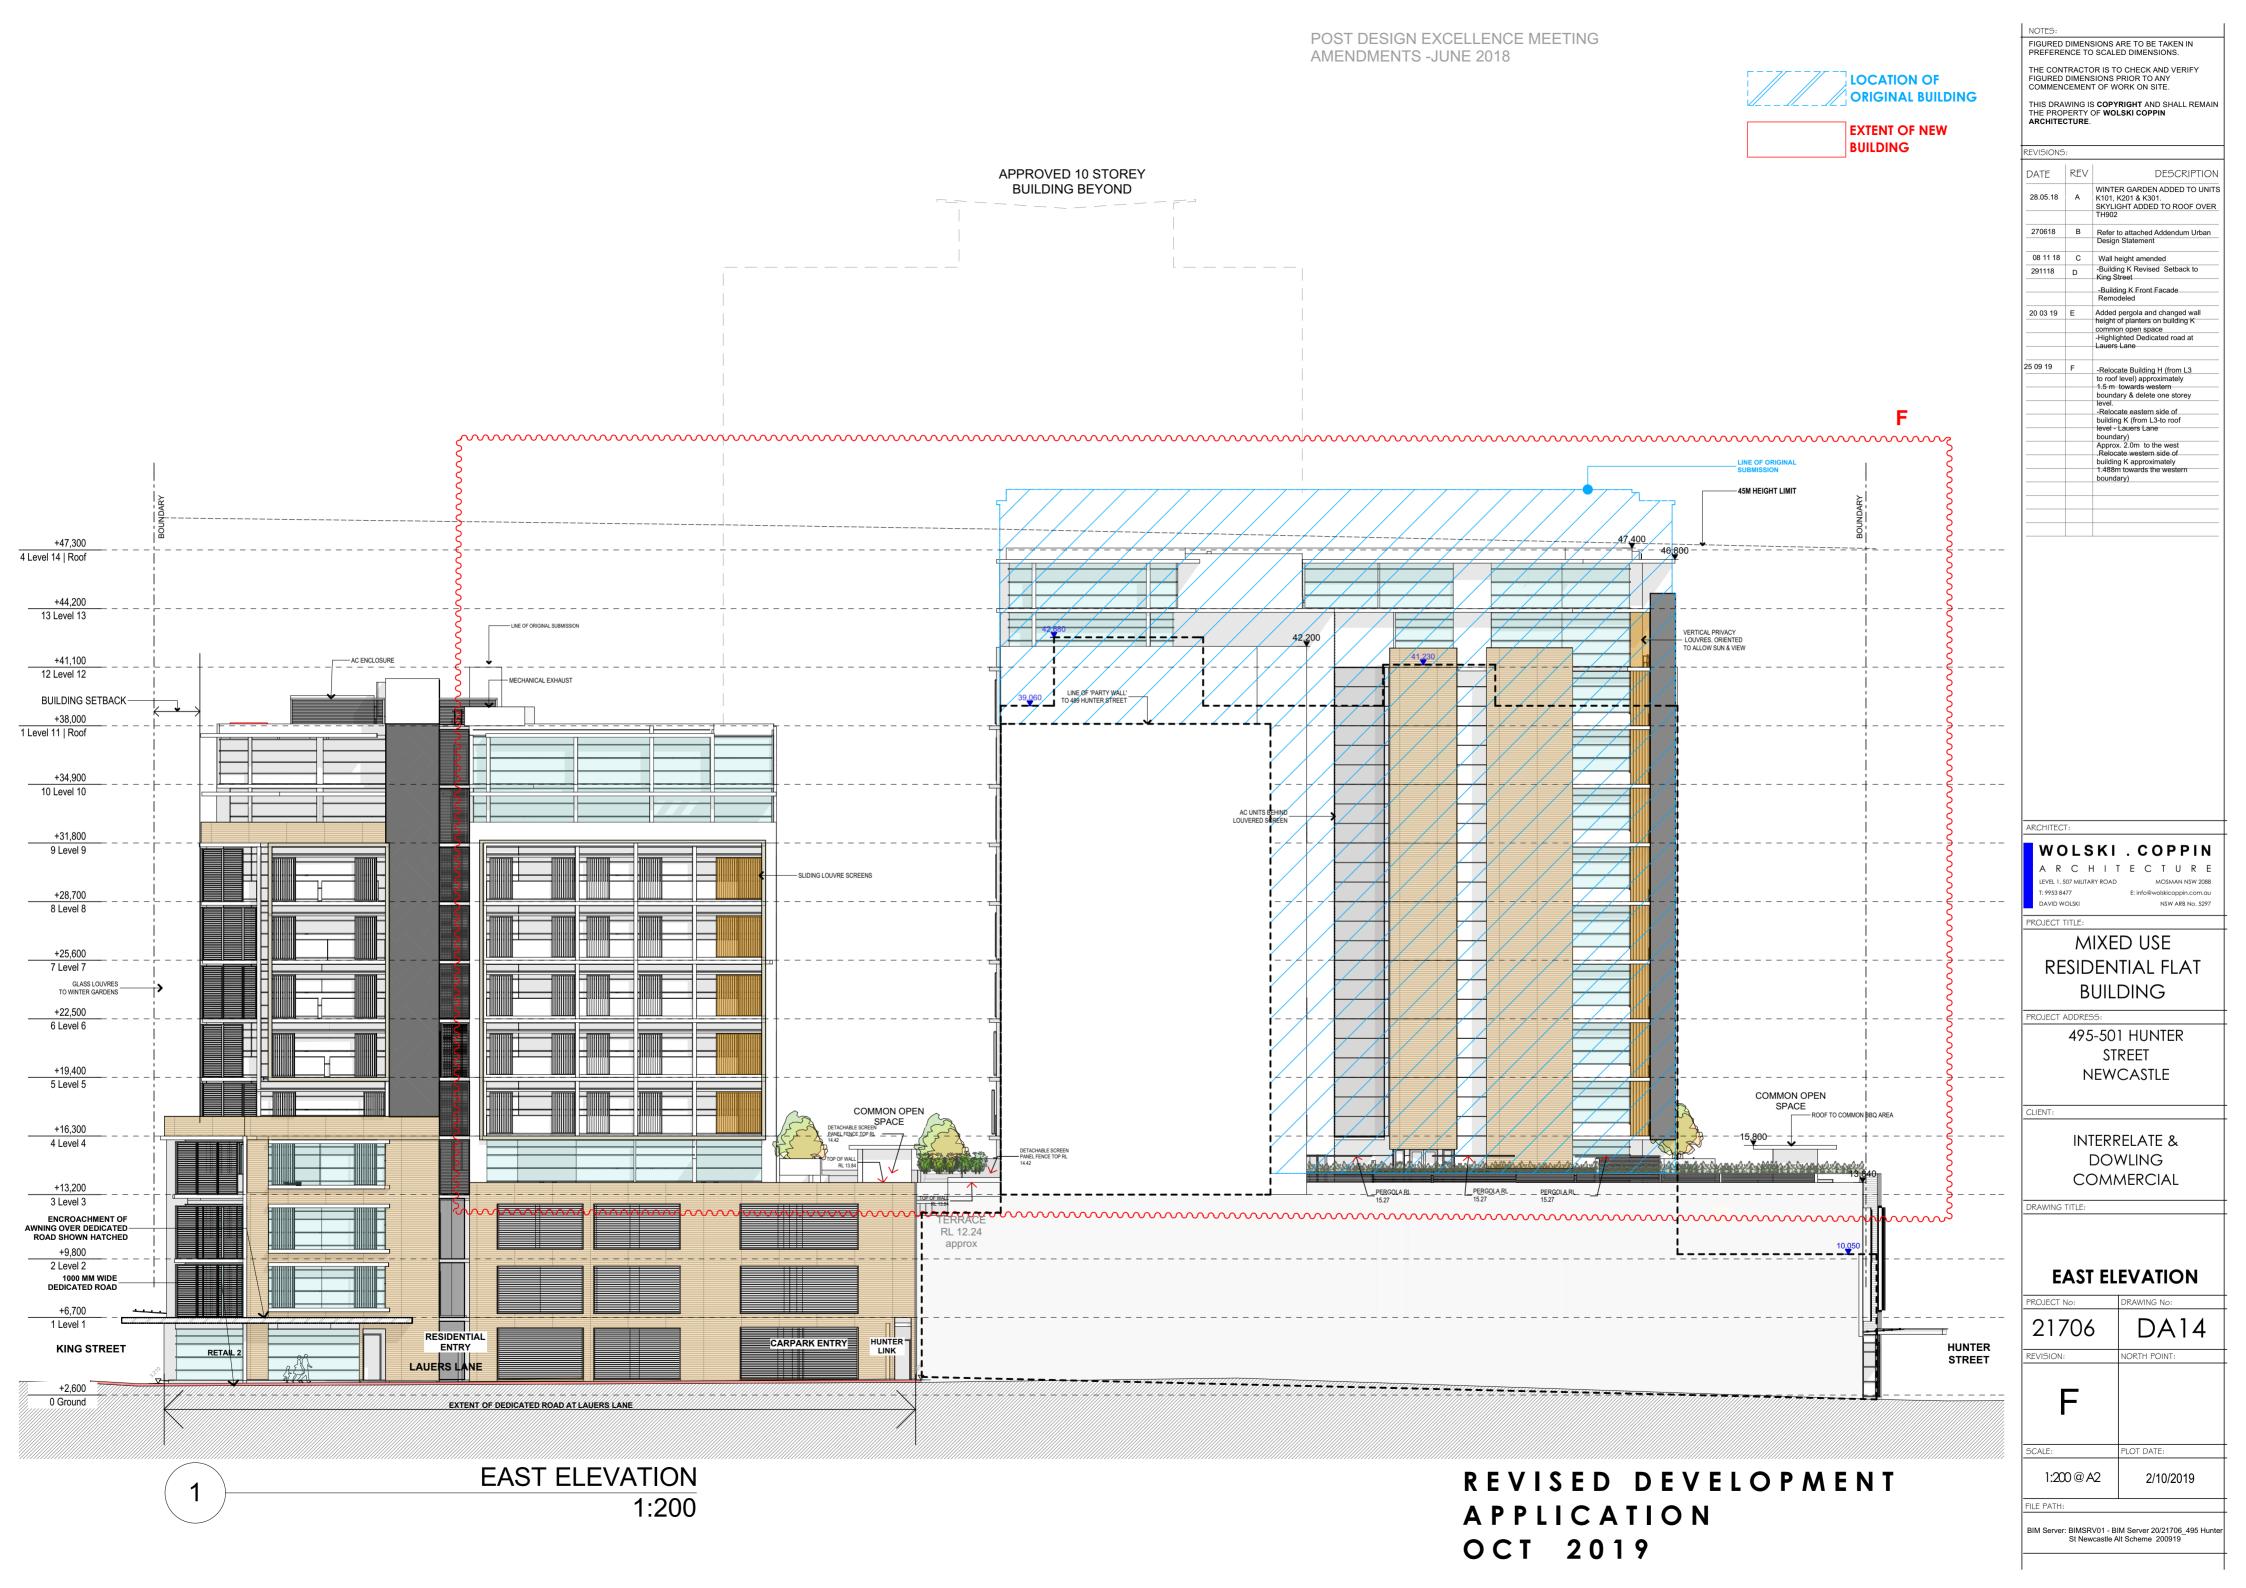

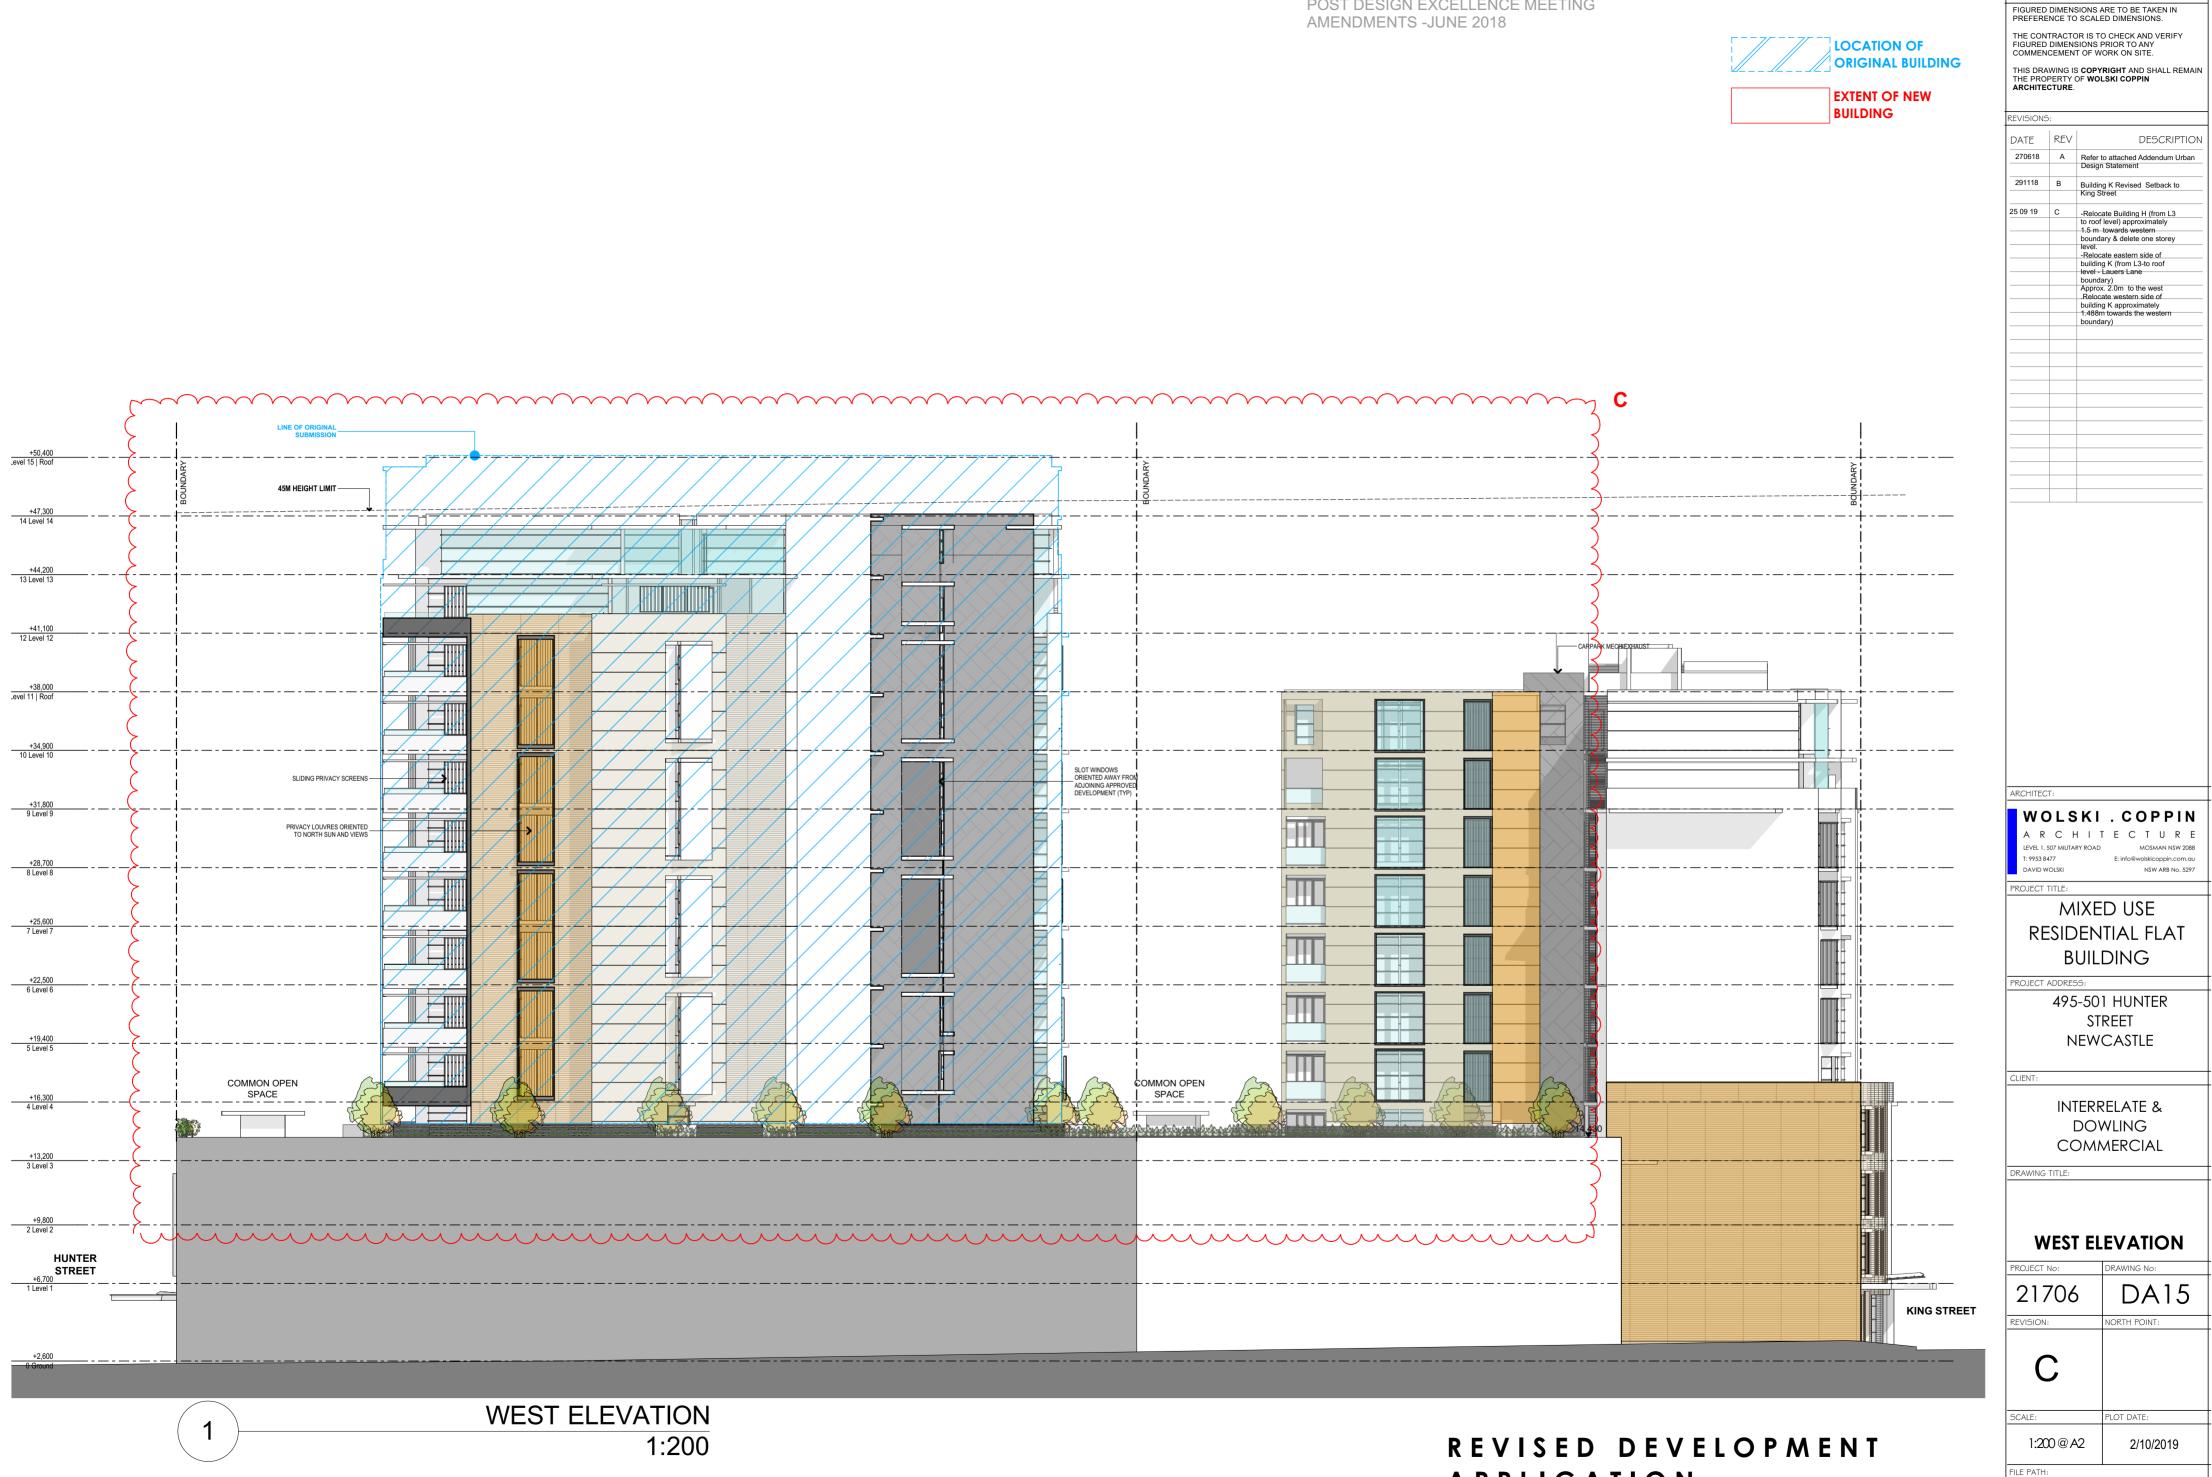

APPLICATION OCT 2019


POST DESIGN EXCELLENCE MEETING AMENDMENTS -JUNE 2018

NOTES

BIM Server: BIMSRV01 - BIM Server 20/21706_495 Hunt St Newcastle Alt Scheme 200919

APPROVED 19 STOREY BUILDING (BEYOND) H -----CARPARK MECH, EXHAUST ______ E Ц + R F 14,500 V 1 11,040 2 STOREY BUILDING No. 368 3 STOREY BUILDING No. 375 SOUTH ELEVATION 1 (KING STREET ELEV.)

REVISED DEVELOPMENT APPLICATION OCT 2019

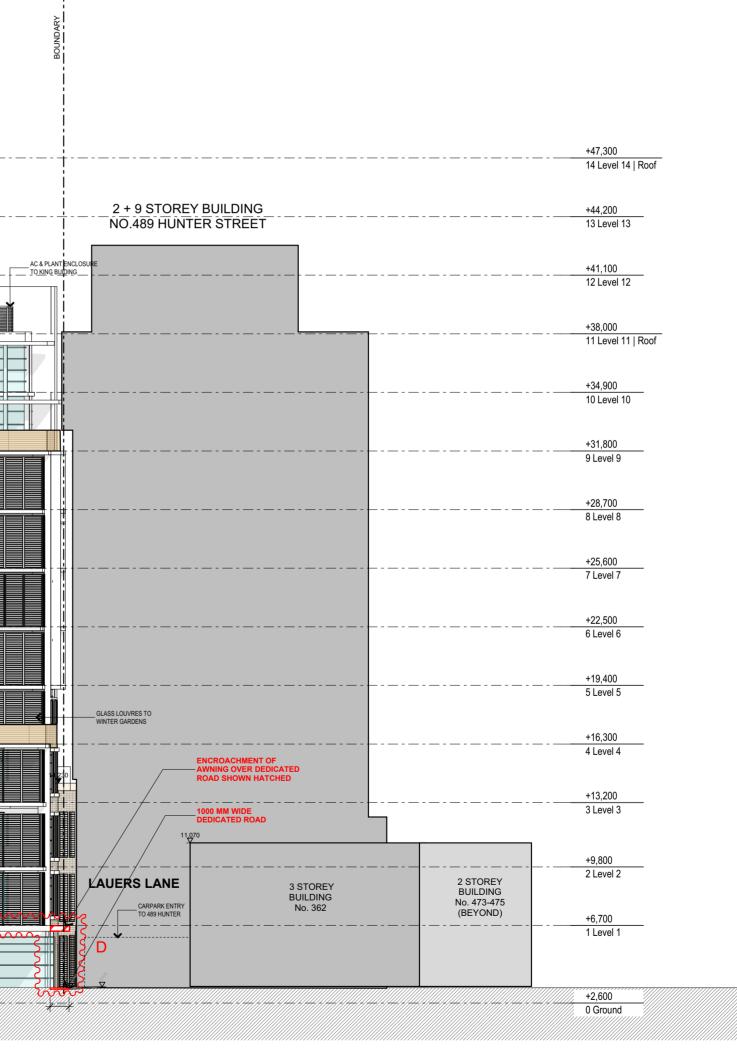

ARCHITE		
REVISIONS	:	
DATE	REV	DESCRIPTION
28.05.18	A	WINTER GARDEN ADDED TO UNITS K101, K201 & K301
270618	в	Refer to attached Addendum Urban Design Statement
291118	с	Building K Front Facade Remodel
20.03.19	D	-Awning Extended -Highlighted Dedicated Road at Lauers Lane
ARCHITEC	T:	
wc	DLS	SKI.COPPIN
A R		HITECTURE RY ROAD MOSMAN NSW 2088
W C A R	DLS CH 507 MILITA 477	HITECTURE
W C A R LEVEL 1, 5 T: 9953 84 DAVID W	DLS CH 507 MILITA 477 YOLSKI TITLE :	H I T E C T U R E MOSMAN NSW 2088 E: info@wolskicoppin.com.cu NSW ARB No. 5297
W C A R LEVEL 1, 5 T: 9953 84 DAVID W	DLS CH 507 MILITA 477 YOLSKI TITLE :	H I T E C T U R E RY ROAD MOSMAN NSW 2088 E: info@wolskicoppin.com.au
A R LEVEL 1, 5 T: 9953 84 DAVID W	DLS CH 507 MILITA 477 OLSKI TITLE:	H I T E C T U R E MOSMAN NSW 2088 E: info@wolskicoppin.com.cu NSW ARB No. 5297
A R LEVEL 1, 5 T: 9953 84 DAVID W	DLS CH 507 MILITA 477 OLSKI TITLE: M SID	HITECTURE RYROAD MOSMAN NSW 2088 E: info@wolskicoppin.com.au NSW ARB No. 5297
RE	DLS CH 507 MILITA 177 OLSKI TITLE: M SID B	HITECTURE MOSMAN NSW 2088 E: info@wolkicoppin.com.au NSW ARB NO. 5297
RE	DLS CH 507 MILITA 177 OLSKI TITLE: M SID B ADDRES	HITECTURE MOSMAN NSW 2088 E: info@iwolskicoppin.com.au NSW ARB NO. 5297 NXED USE DENTIAL FLAT UILDING
RE	DLS CH 507 MILITA 177 OLSKI TITLE: M SID B ADDRES	HITECTURE MOSMAN NSW 2088 E: info@wolkicoppin.com.au NSW ARB NO. 5297
RE	DLS CH 507 MILITA 177 OLSKI TITLE: M SID B ADDRES 495	HITECTURE MOSMAN NSW 2088 E: Info@wolskicoppin.com.au NSW ARB No. 3297 NIXED USE DENTIAL FLAT UILDING 55: 5-501 HUNTER
RE	DLS CH 507 MILITA 177 OLSKI TITLE: M SID B ADDRES 495	HITECTURE MOSMAN NSW 2088 E: Info@Wolklcoppin.com.au NSW ARB NO. 5297 NIXED USE DENTIAL FLAT UILDING 55: 5-501 HUNTER STREET
ROJECT /	DLS CH 507 MILITA 177 OLSKI TITLE: M SID B ADDRES 495	HITECTURE MOSMAN NSW 2088 E: Info@Wolklcoppin.com.au NSW ARB NO. 5297 NIXED USE DENTIAL FLAT UILDING 55: 5-501 HUNTER STREET
ROJECT /	C H 507 MILITA 177 OLSKI TITLE: M SSID B SSID B ADDREE 495	ALLE C T U R E MOSMAN NSW 2088 E: Info@Wolklcoppin.com.au NSW ARB NO. 3297
ROJECT /	C H S C H SOV MILITA SOV MILITA ITTLE: M SSID B SSID B ADDRES 495 N N	HITECTURE MOSMAN NSW 2088 E: Info@Wolklcoppin.com.au NSW ARB NO. 5297 NIXED USE DENTIAL FLAT UILDING 55: 5-501 HUNTER STREET
ROJECT /	C H SOT MILITA STITULE: M SSID B ADDRES 4955 N	A I T E C T U R E MOSMAN NSW 2088 E: Info@Wolkicoppin.com.au NSW ARB No. 5297
ROJECT /	CC	A I T E C T U R E MOSMAN NSW 2088 E: Info@Wolkicoppin.com.au NSW ARB No. 3297
A R LEVEL 1, 5 T: 9953 84 DAVID W	CC	A I T E C T U R E MOSMAN NSW 2088 E: Info@Wolkicoppin.com.au NSW ARB No. 3297
ROJECT /	INTILE:	A I T E C T U R E MOSMAN NSW 2088 E: Info@Wolklcoppin.com.au NSW ARB NO. 3297
RE CLIENT: DRAWING	DLS CH SOT MILITA STIC STIC B STIC B STIC B ADDRES ADDRES ADDRES N IN IN IN IN IN IN IN IN	HITECTURE MOSMAN NSW 2088 E: Info@Wolkicoppin.com.au NSW ARB No. 3297
ROJECT / CLIENT:	DLS CH SOT MILITA STIC STIC B STIC B STIC B ADDRES ADDRES ADDRES N IN IN IN IN IN IN IN IN	HITECTURE MOSMAN NSW 2088 E: Info@Wolkicoppin.com.au NSW ARB No. 3297
ROJECT / REPROJECT / CLIENT: DRAWING	IN ITTLE:	A I T E C T U R E MOSMAN NSW 2088 E: Info@Wolklcoppin.com.au NSW ARB NO. 3297
ROJECT / CLIENT: DRAWING	DLS C H SOT MILITA STOLEN TITTLE: M SSID SSID SSID SSID SSID SSID SSID SS	HITECTURE MOSMAN ISW 2088 E: Info@Wolkicoppin.com.au ISW ARB NO. 5297 IXED USE DENTIAL FLAT UILDING DENTIAL FLAT UILDING DES: 5-501 HUNTER STREET IEWCASTLE IERRELATE & DOWLING DMMERCIAL HELEVATION ST. ELEVATION ST. ELEVATION
ROJECT / REPROJECT / CLIENT: DRAWING	DLS C H SOT MILITA STOLEN TITTLE: M SSID SSID SSID SSID SSID SSID SSID SS	HITECTURE MOSMAN ISW 2088 E-Info@Wolkicoppin.com.au ISW ARB NO. 5297 IXED USE DENTIAL FLAT UILDING BS: 5-501 HUNTER STREET IEWCASTLE IERRELATE & DOWLING DMMERCIAL HELEVATION ST. ELEVATION ST. ELEVATION
ROJECT 7 REPROJECT 7 REPROJECT 7 REPROJECT 7 CLIENT: CLIENT: DRAWING SCC (KIN 2177		HITECTURE MOSMAN ISW 2088 E: Info@Wolkicoppin.com.au ISW ARB NO. 5297 IXED USE DENTIAL FLAT UILDING DENTIAL FLAT UILDING DES: 5-501 HUNTER STREET IEWCASTLE IERRELATE & DOWLING DMMERCIAL HELEVATION ST. ELEVATION ST. ELEVATION
ROJECT 7 REPROJECT 7 REPROJECT 7 REPROJECT 7 CLIENT: CLIENT: DRAWING SCC (KIN 2177		HITECTURE MOSMAN ISSU 2088 E: Info@Wolklcoppin.com.au ISW ARB NO. 3297 IXED USE DENTIAL FLAT UILDING 35: 5-501 HUNTER STREET IEWCASTLE TERRELATE & DOWLING DMMERCIAL HELEVATION ST. ELEVATION ST. ELEVATION ST. ELEVATION ST. ELEVATION
RE RE RE RE RE RE RE RE RE RE		HITECTURE MOSMAN ISW 2088 E: Info@Wolklcoppin.com.au ISW ARB NO. 3297 IXED USE DENTIAL FLAT UILDING 35: 5-501 HUNTER STREET IEWCASTLE TERRELATE & DOWLING DMMERCIAL HELEVATION ST. ELEVATION ST. ELEVATION DA16 NORTH POINT:
RE RE RE RE RE RE RE RE RE RE		HITECTURE MOSMAN ISSU 2088 E: Info@Wolklcoppin.com.au ISW ARB NO. 3297 IXED USE DENTIAL FLAT UILDING 35: 5-501 HUNTER STREET IEWCASTLE TERRELATE & DOWLING DMMERCIAL HELEVATION ST. ELEVATION ST. ELEVATION ST. ELEVATION ST. ELEVATION
ROJECT / RE CLIENT: CLIENT: CRAWING CROJECT / REVISION: REVISION: CROJECT /		HITECTURE MOSMAN ISW 2008 E: Info@Wolkicoppin.com.au ISW ARB NO. 5297 IXED USE DENTIAL FLAT UILDING DENTIAL FLAT UILDING DS-501 HUNTER STREET IEWCASTLE IERRELATE & DOWLING DMMERCIAL BRAWING NO: DRAWING NO: DRAWING NO: DRAWING NO: DRATH POINT:
ROJECT / RE CLIENT: CLIENT: CRAWING CROJECT / REVISION: REVISION: CROJECT /		HITECTURE MOSMAN ISW 2008 E-Info@Wolkicoppin.com.au INSW ARB NO. 5297 INTED USE DENTIAL FLAT UILDING DENTIAL FLAT UILDING DENTIAL FLAT STREET IEWCASTLE IERRELATE & DOWLING DMMERCIAL DRAWING NO: DRAWING NO: DRAWING NO: DRAMING NO: DRAMING NO: DRATH POINT: PLOT DATE:




EXTENT OF NEW BUILDING NOTES


FIGURED DIMENSIONS ARE TO BE TAKEN IN PREFERENCE TO SCALED DIMENSIONS.

								APPROVE BUILDIN	D 19 STOREY IG BEYOND	
										L
	BOUNDARY		~~~	مممممممممم	مممممممممم		~~~~~~~~~~~~~~~~~~~~~~~~~~~~~~~~~~~~~~~		0000000000	000
			Ş							
			Ş					\	,,,-	
	 		<u>}</u>	45M HEIGHT LIM	IIT 	 				
+47,300	-							47,300		
			3							1
+44,200 13 Level 13						. 				
+41,100	BUILDI	NG SETBACK	Ę							
12 Level 12			п П	CARPARK MECH EXHAUST		, <u> </u>				Ŕ
+38,000		38,000			38,000) _				
Level 11 Roof										
+34,900 10 Level 10										
			LOSSY							
+31,800 9 Level 9	╴╵╴╴╴╴ <mark>╽┶<u>┣</u>╼┙╺┷ ╎╴╶╤<mark>╴</mark></mark>									
+28,700		-								
8 Level 8		h						480		K
+25,600		-						47,4		
7 Level 7										
+22,500 6 Level 6					+ $+$ $+$					
+19,400	- <mark></mark>			L						
+16,300		-					COMMON OPEN SPACE			
4 Level 4										
+13,200 3 Level 3							PLANTER			
		1	н Суулаан Саран Саран Саран Саран Сар		~~~~~~~~~~~~~~~~~~~~~~~~~~~~~~~~~~~~~~	~~~~~~~~~~~~~~~~~~~~~~~~~~~~~~~~~~~~~~~	~~~~~~~~~~~~~~~~~~~~~~~~~~~~~~~~~~~~~~~	h	CARPARK	$\frac{1}{1}$
+9,800		┠┼┼	<mark>┤──<mark>╢</mark>───┓</mark>				k_			╇┻
				CARPARK				c	CARPARK	
+6,700 1 Level 1 EXIST NGL							<u></u>	_		┼┝╌╬
		RETAIL 2		CARPARK			C/	ARPARK	EXIST GL FROM SECTION	Н
+2,600 0 Ground								2 X		

APPLICATION OCT 2019

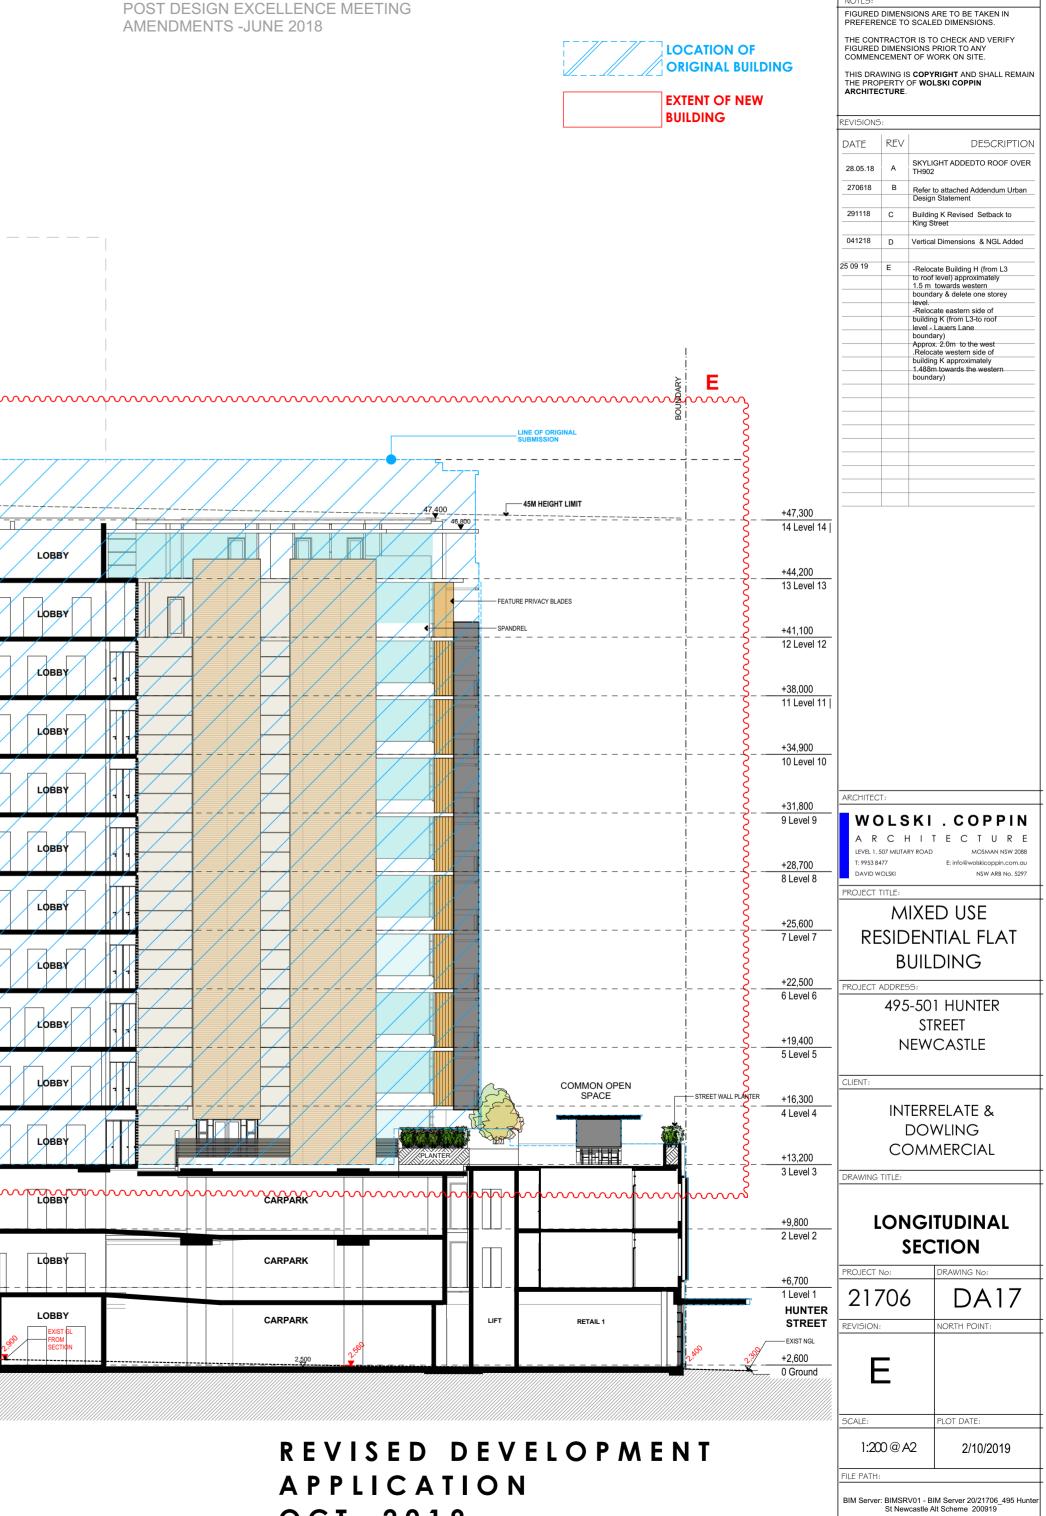


NOTES

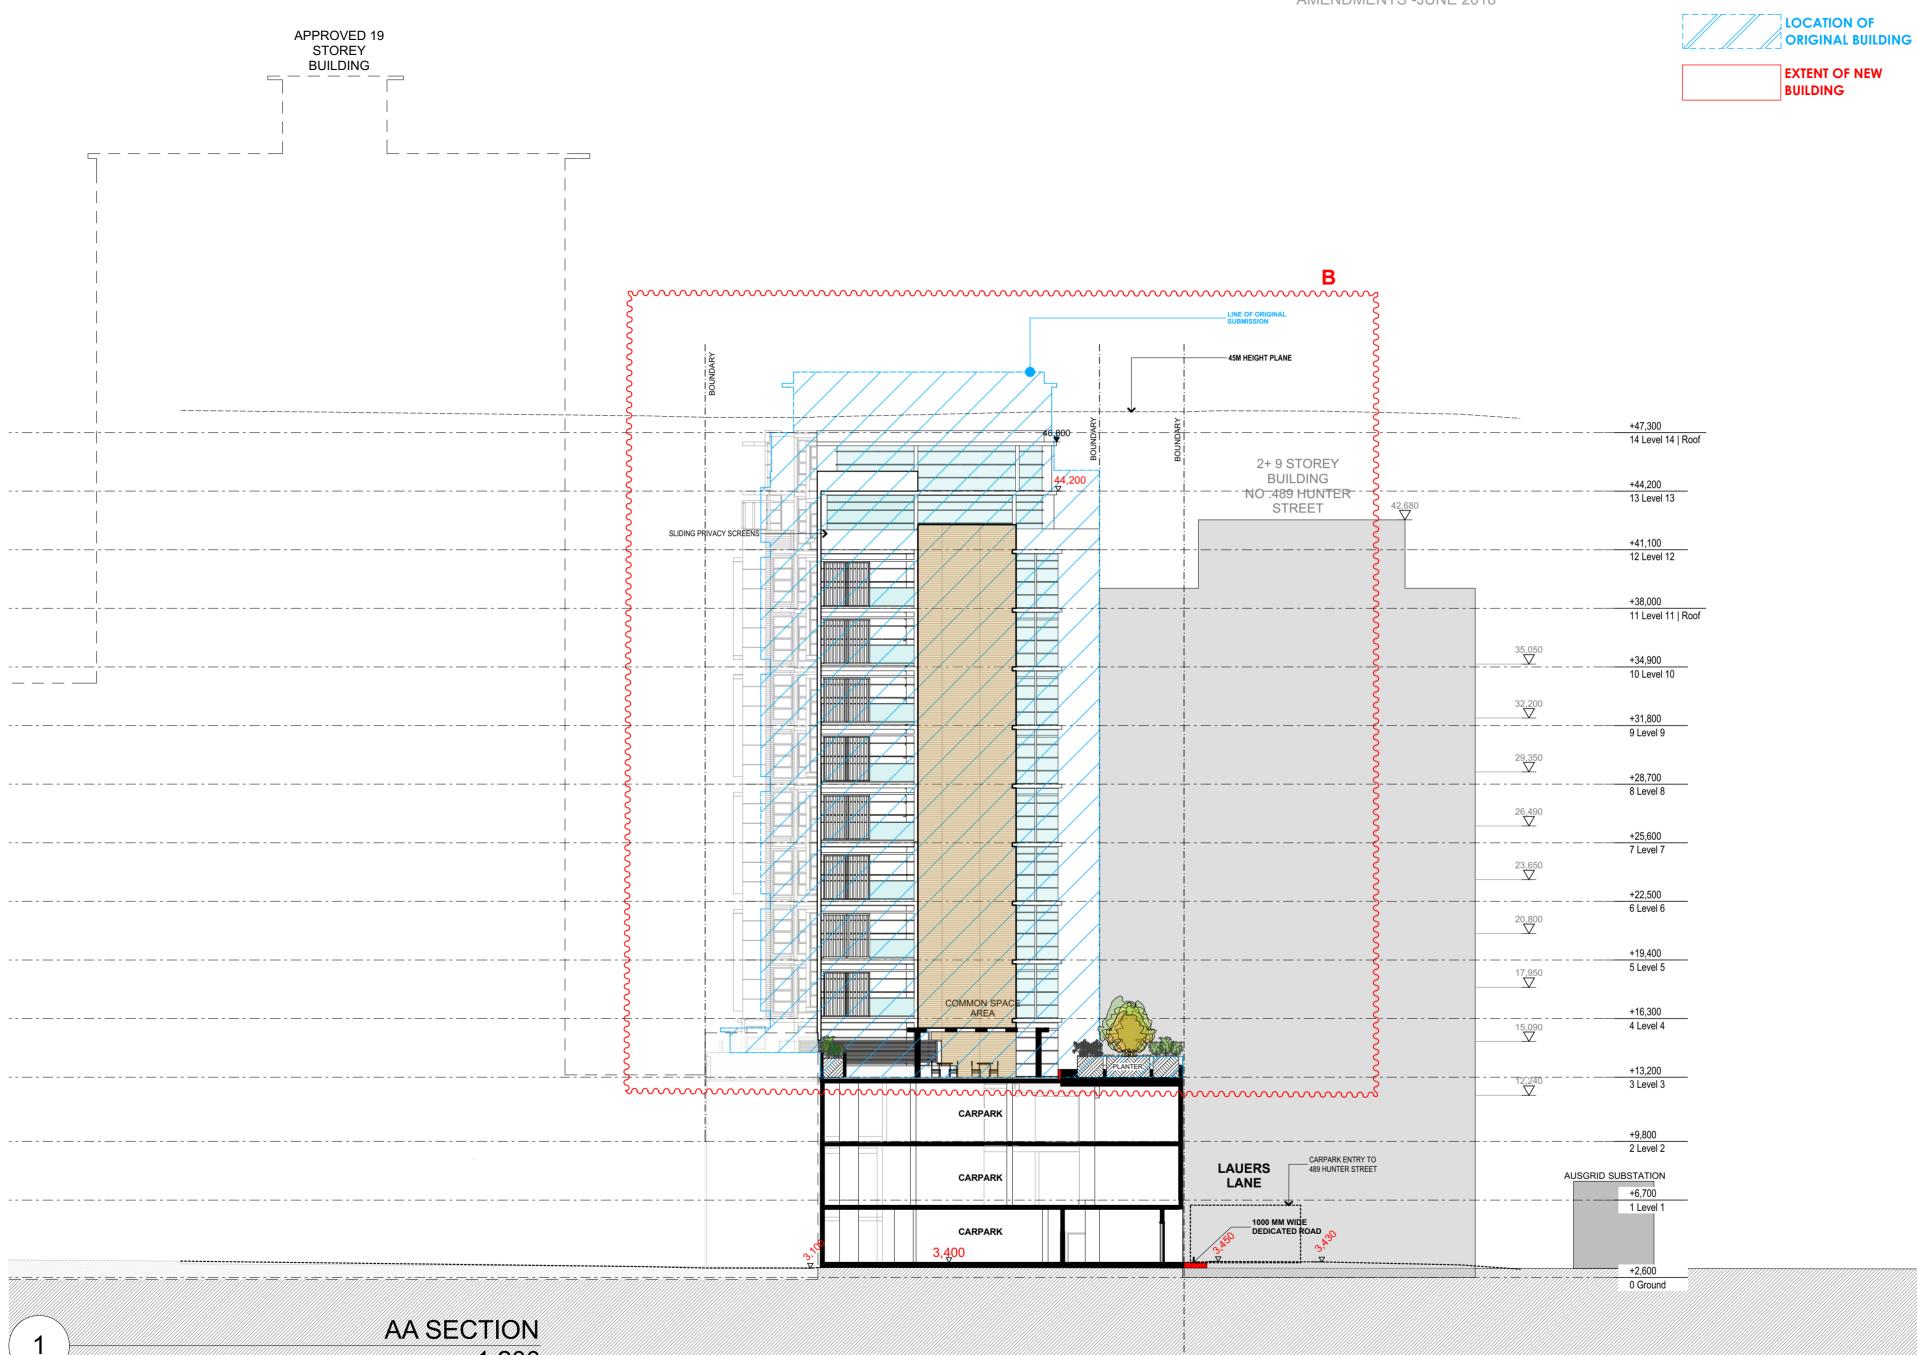

1:200

REVISED DEVELOPMENT APPLICATION OCT 2019

THIS DRA THE PRO ARCHITE		
	REV	
DATE 041218	A	DESCRIPTION New RLs & NGL Added
20 03 19	В	Dedicated Road Added at Lauers Lane
5 09 19	с	-Relocate Building H (from L3 to roof level) approximately
		1.5 m towards western boundary & delete one storey level.
		-Relocate eastern side of building K (from L3-to roof level - Lauers Lane
		boundary) Approx. 2.0m to the west .Relocate western side of
		building K approximately 1.488m towards the western boundary)
RE	DLS CH 507 MILITA 477 /OLSKI TITTLE: M SSID B ADDRES	E: Info@wolskicoppin.com.au NSW ARB No. 5297
RE	DLS CH 507 MILITA 477 70LSKI TITLE: M SID B ADDRES 495	I T E C T U R E MOSMAN NSW 2088 E: Info@Wolskicoppin.com.au NSW ARB No. 5297 IXED USE DENTIAL FLAT UILDING 55: 5-501 HUNTER STREET
RE	DLS CH 507 MILITA 477 70LSKI TITLE: M SID B ADDRES 495	A I T E C T U R E MOSMAN NSW 2088 E: Info@wolkicoppin.com.au NSW ARB No. 5297 IXED USE DENTIAL FLAT UILDING
ROJECT	DLS CH 507 MILITA 477 70LSKI TITLE: M SID B ADDRES 495	I T E C T U R E MOSMAN NSW 2088 E: Info@Wolskicoppin.com.au NSW ARB No. 5297 IXED USE DENTIAL FLAT UILDING 55: 5-501 HUNTER STREET
ROJECT	C H S07 MILIA 477 VOLSKI TITLE: M ESID B ADDRES 495	I T E C T U R E MOSMAN NSW 2088 E: Info@Wolskicoppin.com.au NSW ARB No. 5297 IXED USE DENTIAL FLAT UILDING 55: 5-501 HUNTER STREET
ROJECT	SOT MULTA SOT MULTA ATT COLSKI TITTLE: M ESID B ADDRES 495 N IN	A I T E C T U R E MOSMAN NSW 2088 E: Info@Wolkicoppin.com.au NSW ARB No. 5297 IXED USE DENTIAL FLAT UILDING 35: 5-501 HUNTER STREET IEWCASTLE IERRELATE & DOWLING
ROJECT	SOT MULTA SOT MULTA ATT COLSKI TITTLE: M ESID B ADDRES 495 N IN	A I T E C T U R E MOSMAN NSW 2088 E: Info®wolkicoppin.com.au NSW ARB No. 5297 IXED USE DENTIAL FLAT UILDING 35: 5-501 HUNTER STREET IEWCASTLE
ROJECT	C F SOT MILITA ATT VOLSKI TITTLE: M ESID B ESID B ADDRES 495 N IN IN	A I T E C T U R E MOSMAN NSW 2088 E: Info@Wolkicoppin.com.au NSW ARB No. 5297 IXED USE DENTIAL FLAT UILDING 35: 5-501 HUNTER STREET IEWCASTLE IERRELATE & DOWLING
ROJECT	SOT MULTA STTICLE: MADDRESS ADDRESS	A I T E C T U R E MOSMAN NSW 2088 E: Info@Wolkicoppin.com.au NSW ARB No. 5297 IXED USE DENTIAL FLAT UILDING 35: 5-501 HUNTER STREET IEWCASTLE IERRELATE & DOWLING
ROJECT CLIENT:	INTILE:	A I T E C T U R E MOSMAN NSW 2088 E: Info@Wolkicoppin.com.au NSW ARB No. 5297 IXED USE DENTIAL FLAT UILDING 35: 5-501 HUNTER STREET IEWCASTLE IERRELATE & DOWLING DMMERCIAL
ROJECT CLIENT:	DLS CH S07 MILITA 477 FOLSKI TITLE: M SSID SSID SSID SSID SSID SSID SSID SS	A I T E C T U R E MOSMAN NSW 2088 E: Info@Wolskicoppin.com.au NSW ARB No. 5297 IXED USE DENTIAL FLAT UILDING 35: 5-501 HUNTER STREET IEWCASTLE IERRELATE & DOWLING DMMERCIAL DOMMERCIAL DN AA (CROSS ECTION)
RE PROJECT CLIENT: CLIENT: CRE PROJECT CLIENT: CLIENT	SUP AND A CONTRACT OF A CONTRACT ON A CONTRACT OF A CONTRACT ON TANTACT OF A CONTRACT ON TANTACT OF A CONTRACT ON TANTACT OF A CONTRACT OF A C	A I T E C T U R E MOSMAN NSW 2088 E-Info®Wolkicoppin.com.au NSW ARB No. 5297 IXED USE DENTIAL FLAT UILDING DS-501 HUNTER STREET IEWCASTLE IERRELATE & DOWLING DMMERCIAL DOMMERCIAL
A R LEVEL 1, T: 9538 DAVID W PROJECT CLIENT: CLIENT: DRAWING SEC	SUP AND A CONTRACT OF A CONTRACT ON A CONTRACT OF A CONTRACT ON TANTACT OF A CONTRACT ON TANTACT OF A CONTRACT ON TANTACT OF A CONTRACT OF A C	A LITE CTURE MOSMAN NSW 2088 E: Info@Wolkicoppin.com.au NSW ARB No. 5297 IXED USE DENTIAL FLAT UILDING 35: 5-501 HUNTER STREET IEWCASTLE IERRELATE & DOWLING DMMERCIAL DAAA (CROSS ECTION) DRAWING No: 5 DA18
RE PROJECT CLIENT: CLIENT: CRE PROJECT CLIENT: CLIENT	SUP AND A CONTRACT OF A CONTRACT ON A CONTRACT OF A CONTRACT ON TANTACT OF A CONTRACT ON TANTACT OF A CONTRACT ON TANTACT OF A CONTRACT OF A C	A LITE CTURE MOSMAN NSW 2088 E: Info@Wolkicoppin.com.au NSW ARB No. 5297 IXED USE DENTIAL FLAT UILDING 35: 5-501 HUNTER STREET IEWCASTLE IERRELATE & DOWLING DMMERCIAL DAAA (CROSS ECTION) DRAWING No: 5 DA18
ROJECT CLIENT: CRAWING SEC	SUP AND A CONTRACT OF A CONTRACT ON A CONTRACT OF A CONTRACT ON TANTACT OF A CONTRACT ON TANTACT OF A CONTRACT ON TANTACT OF A CONTRACT OF A C	A I T E C T U R E MOSMAN NSW 2088 E: Info@Wolskicoppin.com.au NSW ARB No. 5297 IXED USE DENTIAL FLAT UILDING 35: 5-501 HUNTER STREET IEWCASTLE IERRELATE & DOWLING DMMERCIAL DOWLING DMMERCIAL DRAWING No: DRAWING No: DRAWING No: DRAMING No: DRAWING NO: DRAWIN

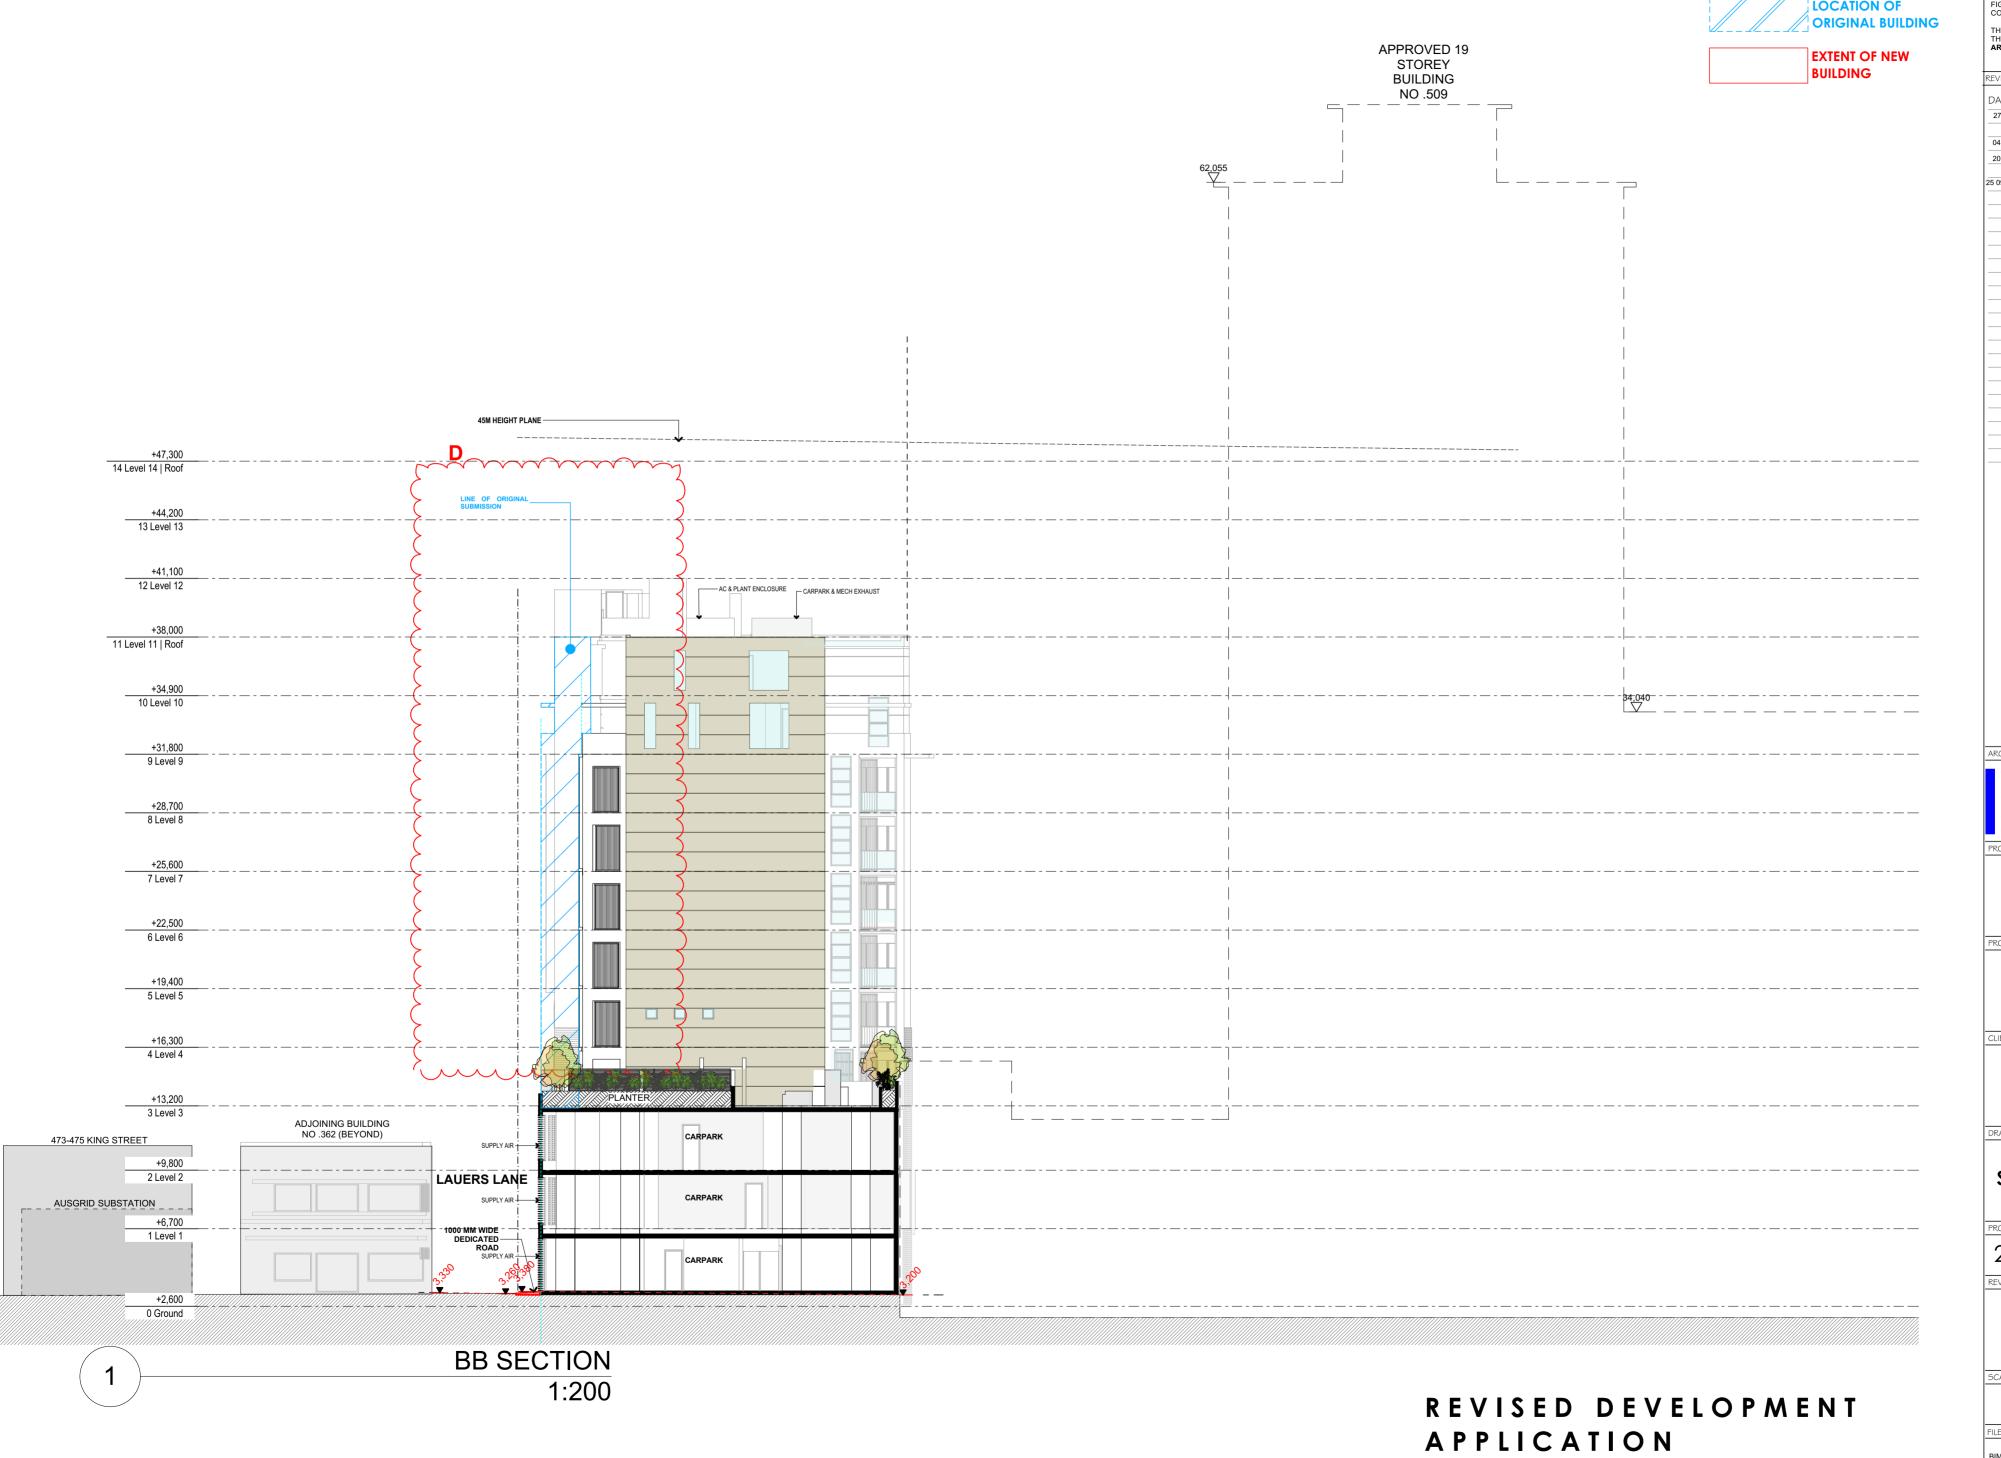


POST DESIGN EXCELLENCE MEETING AMENDMENTS -JUNE 2018

OCT 2019



	PERTY (COPYRIGHT AND SHALL R F WOLSKI COPPIN	EMAIN
REVISIONS	ò:		
DATE	REV	DESCRIF	PTION
270618	A	Refer to attached Addendum L Design Statement	Jrban
041218	В	NGL Added & 45 m ht line	
20 03 19	с	Highlighted Dedicated Road at Lauers Lane	
25 09 19	D	-Relocate Building H (from L3	
		to roof level) approximately 1.5 m towards western	
		boundary & delete one storey level.	
		-Relocate eastern side of building K (from L3-to roof level - Lauers Lane	
		boundary) Approx. 2.0m to the west	
		.Relocate western side of building K approximately 1.488m towards the western	
		boundary)	
A R LEVEL 1, . T: 9953 8 DAVID W PROJECT	DLS CH 507 MILITAF 477 7015KI TIITLE: M SID BI ADDRES 495	XED USE ENTIAL FLA JILDING 5: -501 HUNTER STREET	R E w 2088 om.au o. 5297
RE	DLS CH 507 MILITAF 477 7015KI TIITLE: M SID BI ADDRES 495	I T E C T U R MOSMAN NSV E: info@wolskicoppin.cr NSW ARB NC IXED USE ENTIAL FLA JILDING 5: -501 HUNTER	R E w 2088 om.au o. 5297
REPROJECT	DLS CH 507 MILITAF 477 7015KI TIITLE: M SID BI ADDRES 4955 N INT [CCC	I T E C T U R MOSMAN NSV E: info@wolskicoppin.cr NSW ARB NC IXED USE ENTIAL FLA JILDING 5: -501 HUNTER STREET	R E w 2088 om.au o. 5297
RE PROJECT CLIENT: DRAWING	DLS CH 507 MILITAF 477 7015KI TITTLE: M SID BI ADDRES 495 N INT CCC TITTLE: S	I T E C T U R MOSMAN NSV E: info@wolskicoppin.cr NSW ARB NC NSW ARB NC NSW ARB NC NSW ARB NC NSW ARB NC NSW ARB NC NBB (CRO ECTION)	R E w 2088 om.au p. 5297
CLIENT: DRAWING CREWING CREWING CREWING CREWING CREWING CREWING CREWING CREWING CREWING	DLS CH 507 MILITAF 477 7015KI TITLE: M SID BI ADDRES 495 N INT CCC TITLE: CCC S No:	I T E C T U R MOSMAN NSV E: info@wolskicoppin.cr NSW ARB NC IXED USE ENTIAL FLA JILDING 5: -501 HUNTER STREET EWCASTLE ERRELATE & OWLING DMMERCIAL	R E V 2088 om.au D. 5297 T SSS
RE PROJECT CLIENT: DRAWING	DLS CH 507 MILITAF 477 7015KI TITTLE: M SID BI ADDRES 495 N INT CCC TITTLE: S S NO: 706	I T E C T U R MOSMAN NSV E: info@wolskicoppin.cr NSW ARB NC IXED USE ENTIAL FLA JILDING 5: -501 HUNTER STREET EWCASTLE ERRELATE & OWLING DMMERCIAL	R E V 2088 om.au D. 5297 T SSS
RE PROJECT CLIENT: DRAWING REC PROJECT	DLS CH 507 MILITAF 477 7015KI TITTLE: M SID BI ADDRES 495 N INT CCC TITTLE: S S NO: 706	I T E C T U R MOSMAN NSV E: Info@Woldkicoppin.cr NSW ARB NC NSW ARB NC NSW ARB NC NSW ARB NC NSW ARB NC NSW ARB NC NBB (CRO ECTION) DRAWING NC: DA1	R E V 2088 om.au D. 5297 T SSS
RE PROJECT CLIENT: CLIENT: CRE PROJECT CLIENT: CRE PROJECT CLIENT: CRE CLIENT: CRE CLIENT: CRE CLIENT: CRE CLIENT: CRE CLIENT: CRE CLIENT: CRE CLIENT: CRE CRE CRE CRE CRE CRE CRE CRE CRE CRE	DLS CH 507 MILITAF 477 7015KI TITTLE: M SID BI ADDRES 495 N INT CCC TITTLE: S S NO: 706	I T E C T U R MOSMAN ISV E: Info@Woldkicoppin.cr IXED USE ENTIAL FLA JILDING 5: -501 HUNTER STREET EWCASTLE ERRELATE & DOWLING DMMERCIAL DN BB (CRO ECTION) DRAWING NO: DA 10 NORTH POINT:	R E V 2088 om.au D. 5297 T SSS
RE PROJECT CLIENT: DRAWING SEC	DLS CH 507 MILITAF 477 7015KI TITTLE: M SID BI ADDRES 495 N INT CCC TITTLE: S S NO: 706	I T E C T U R MOSMAN NSV E: Info@Woldkicoppin.cr NSW ARB NC NSW ARB NC NSW ARB NC NSW ARB NC NSW ARB NC NSW ARB NC NBB (CRO ECTION) DRAWING NC: DA1	R E V 2088 om.au D. 5297 T SSS

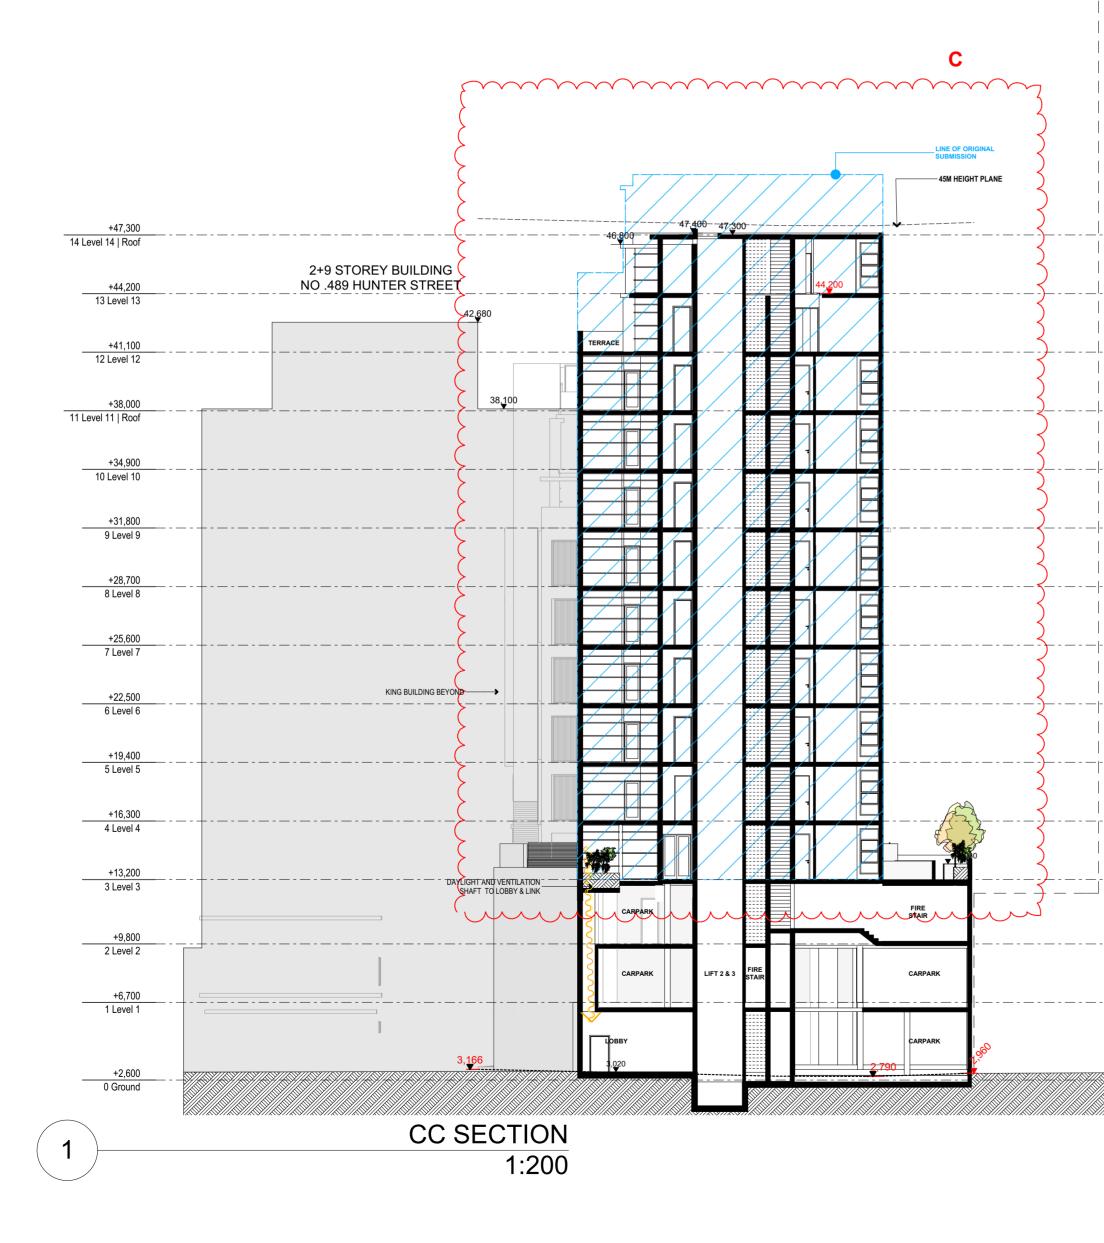

REVIS	SED DEVELOPMENT
APPL	ICATION
OCT	2019


				SIONS ARE TO BE TAKEN IN
		THE CON	TRACTO	D SCALED DIMENSIONS.
	LOCATION OF ORIGINAL BUILDING	COMMEN	CEMENT	SIONS PRIOR TO ANY T OF WORK ON SITE.
			PERTY C	S Copyright and shall remain of Wolski Coppin
	BUILDING	REVISIONS	:	
		DATE	REV	DESCRIPTION
		08 11 18 041218	A B	Wall height amended NGL Added & 45 m ht line
		25 09 19	C	-Relocate Building H (from L3 to roof level) approximately 1.5 m towards western boundary & delete one storey level.
		-	1	1
		-		
		-		
		_		
		_		
		_		
				KI.COPPIN
		A R	C H	HITECTURE
		PROJECT		NSW ARB No. 5297
				IXED USE
		RE		ENTIAL FLAT UILDING
		PROJECT /	ADDRES	
				STREET
		_	N	IEWCASTLE
		CLIENT:		IERRELATE &
			۵	DOWLING
		_		DMMERCIAL
		DRAWING	TITLE:	
		SEC		ON CC (CROSS ECTION)
		217 REVISION		DA20
	ST/ST/ST/ST/ST/S		`	
		= (ر	
		SCALE:		PLOT DATE:
D P M E	F N T	1:20	0@A	2 2/10/2019
	- 14 1	FILE PATH:		V01 - BIM Server 20/21706 405 Live
	- 14 1		: BIMSR\	V01 - BIM Server 20/21706_495 Hu /castle Alt Scheme 200919


_


_ - _

_ - _ - _ -

APPROVED 19 STOREY BUILDING ____NO .509____

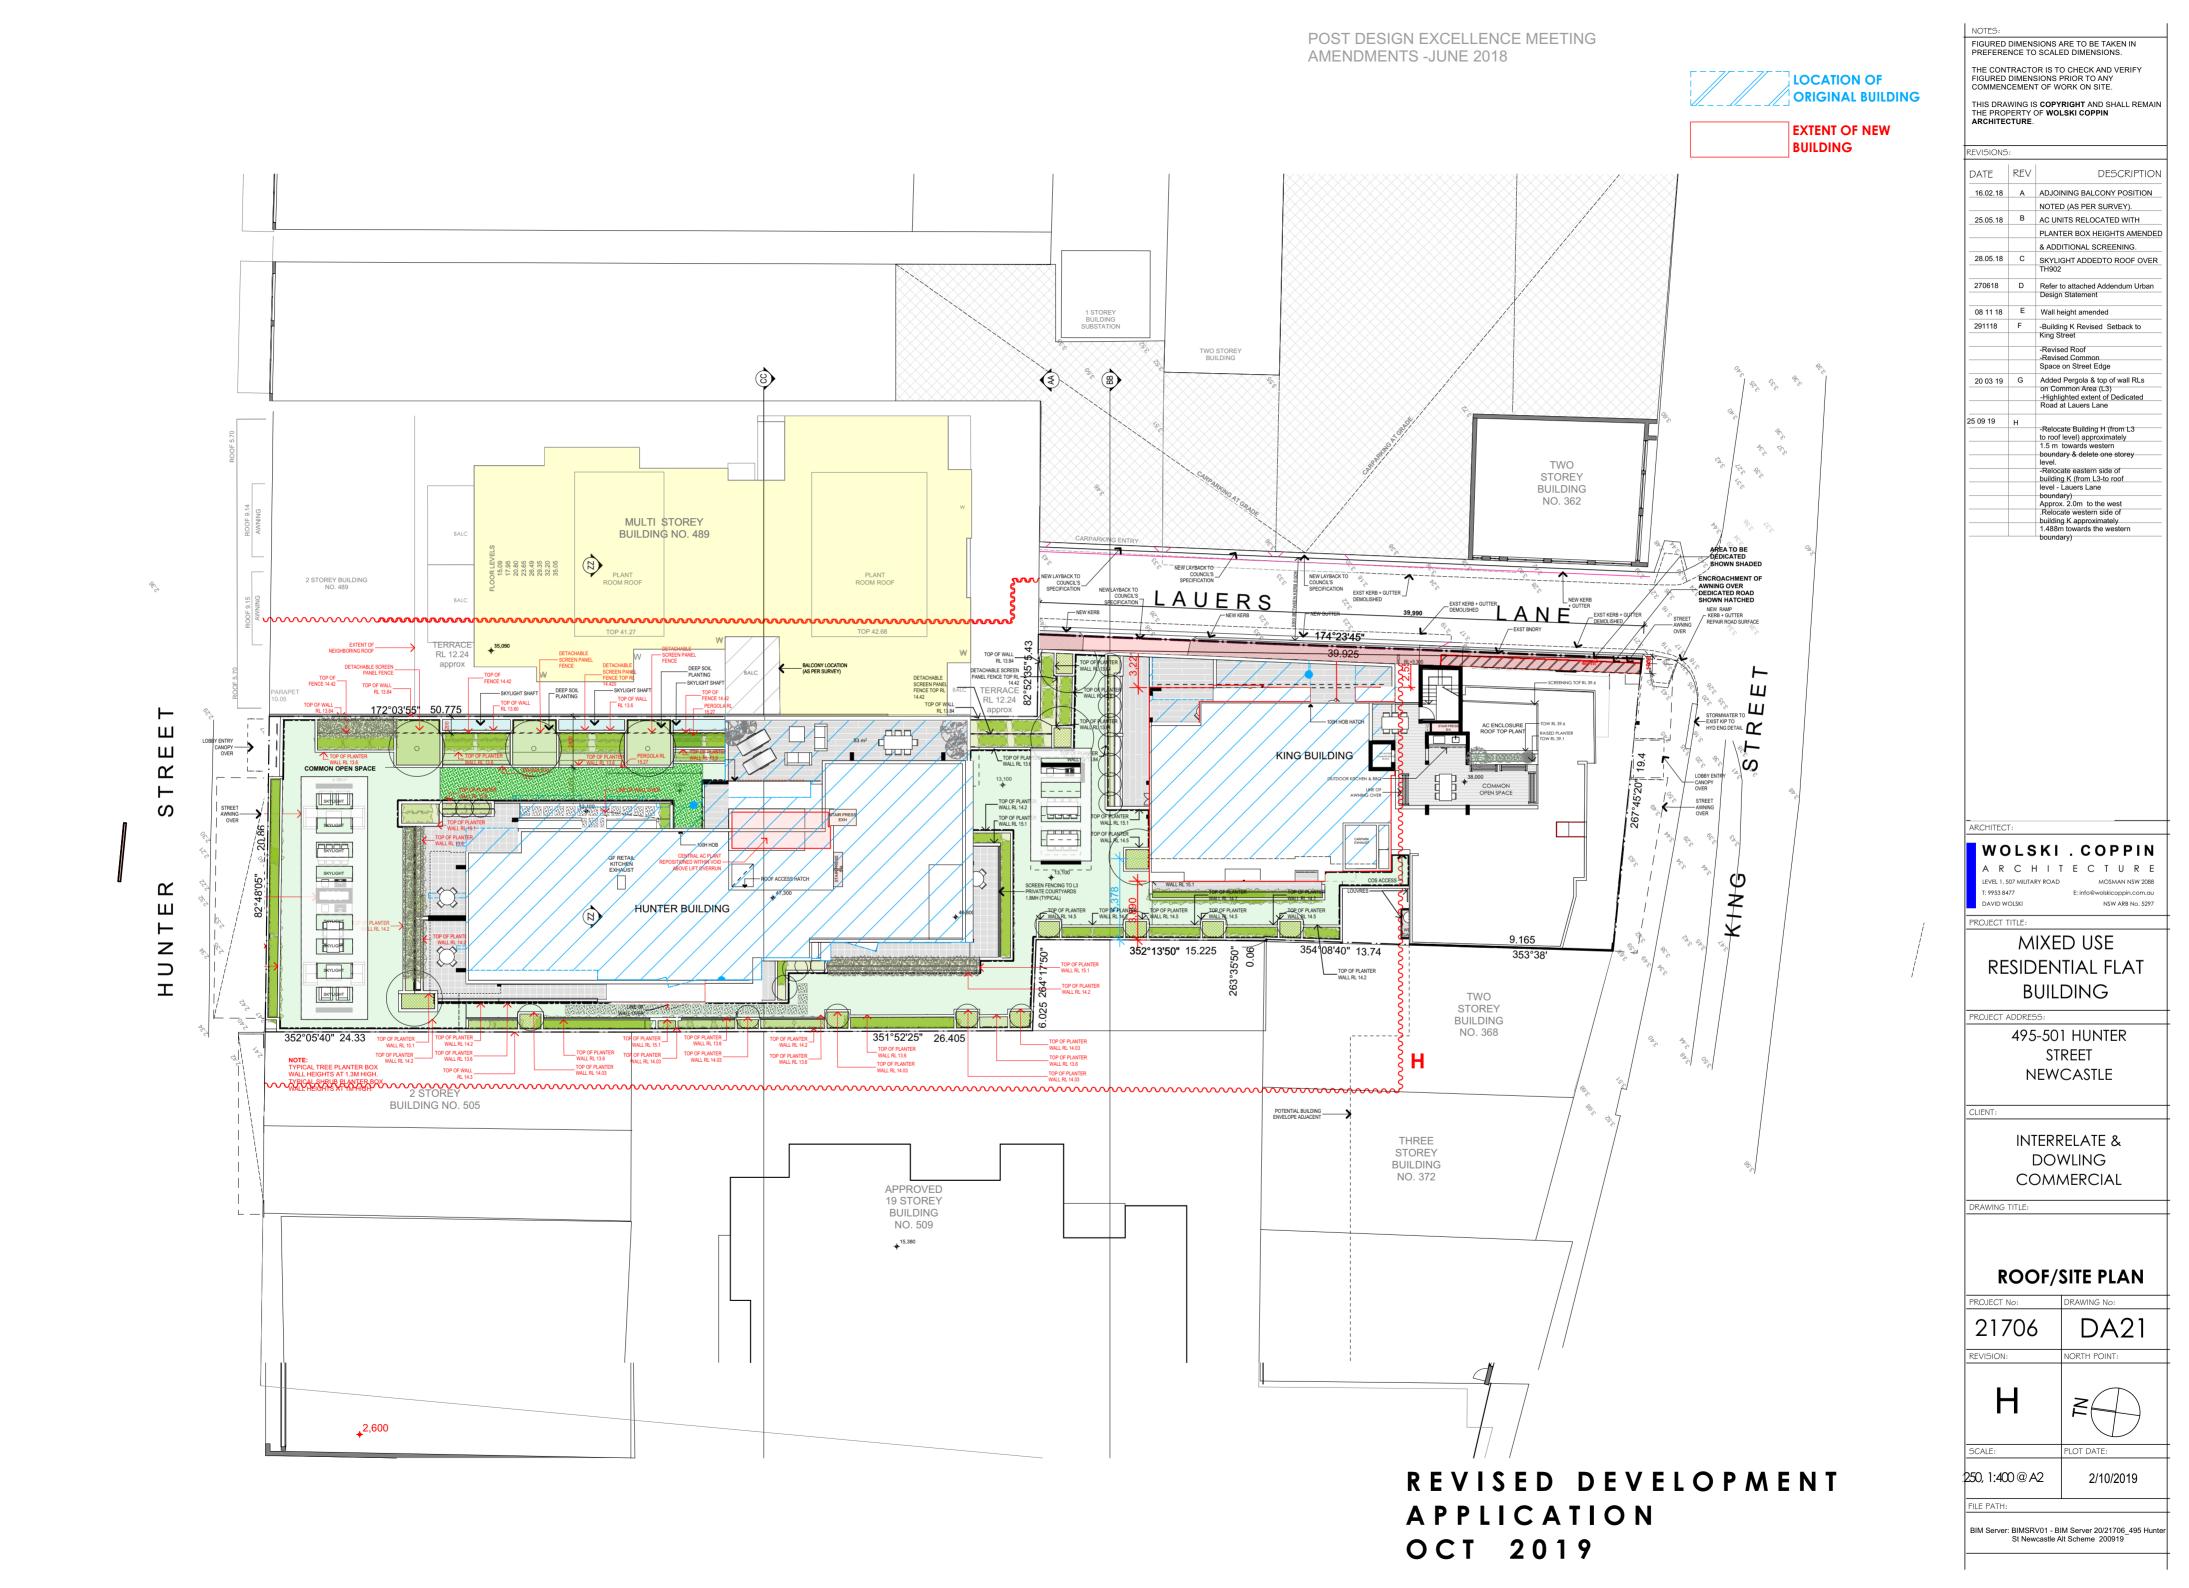

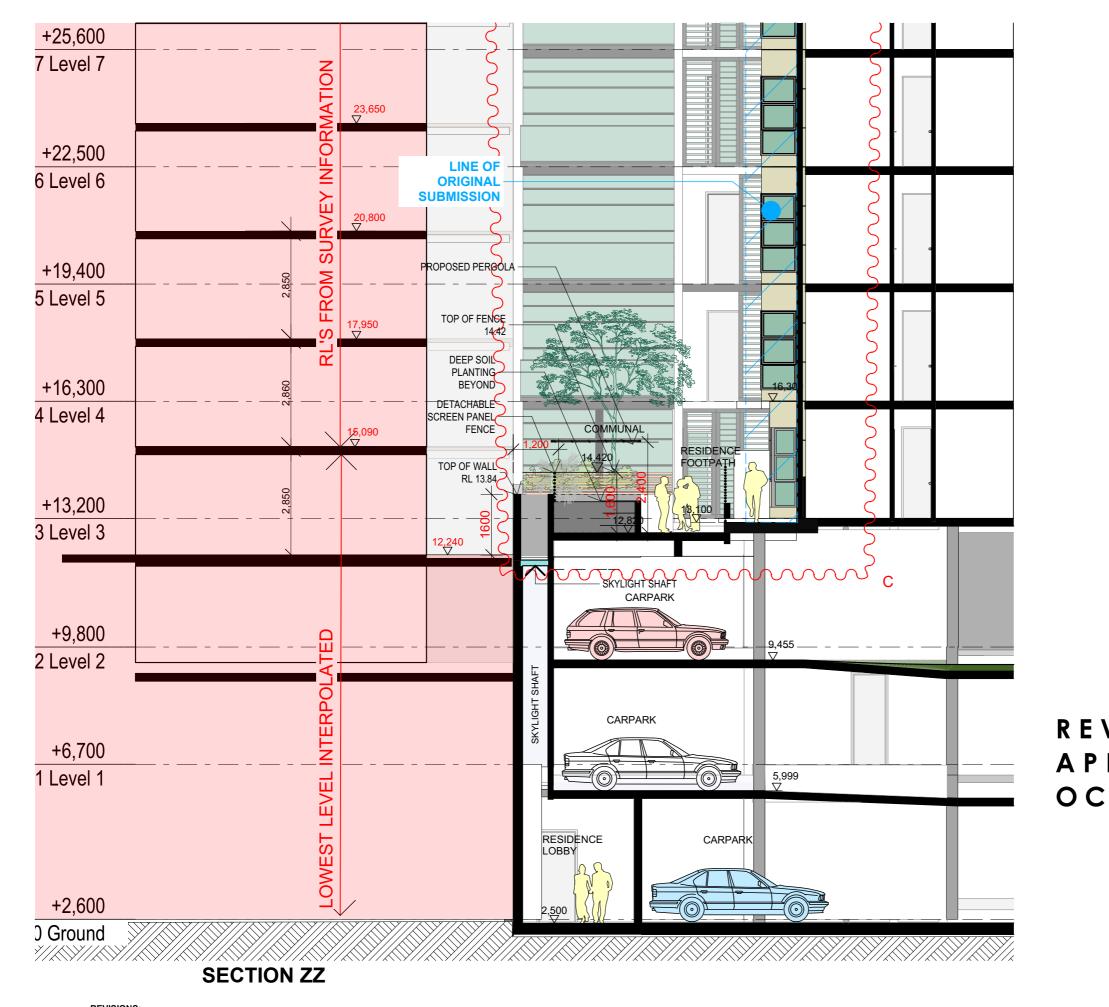

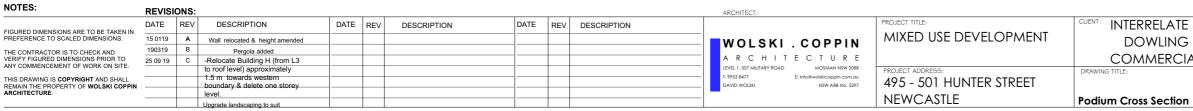

REVISED DEVELOPMENT APPLICATION OCT 2019

&	PROJECT No:	DRAWING No:	REVISION:	NORTH POINT:
۹L	21706	S05	C PLOT DATE:	z
	1:100@A3		2/10/2019	



COMMON SPACE CALCULATIONS


SITE AREA			1827 M ²
COMMUNAL OPEN	L3	=647 M ²	=691 M ²
SPACE	L11 (ROOF BUILDING K)	= 44	(0.378:1)
PRIVATE COURTYARD			


LANDSAPE CALCULATIONS

SITE AREA		1827 M ²
LANDCAPE AREA TO	L3	=186 M2
COMMUNAL SPACE	L11 (ROOF BLDG K)	=2 M2
LANDCAPE AREA TO PRIVATE COURYARD	L3	=20M2
	TOTAL LANDSCAPE AREA	=208 M2

R	Е	۷	I	S	Е
Α	P	Ρ	L	I	С
C	0) T	•		2

NOTES:	REVISI	ONS:								ARCHITECT:			
FIGURED DIMENSIONS ARE TO BE TAKEN IN	DATE	REV	DESCRIPTION	DATE	REV	DESCRIPTION	DATE	REV	DESCRIPTION			PROJECT TITLE:	CLIENT: INTERRELATE &
PREFERENCE TO SCALED DIMENSIONS.	20 03 19		COMMON SPACE / LANDSCAPE CALCULATIONS REVISED	25 09 1	9 B	-Relocate Building H (from L3 to roof level) approxima western boundary & delete one storey level.	-	-		WOLSKI	. COPPIN	MIXED USE DEVELOPMENT	DOWLING
THE CONTRACTOR IS TO CHECK AND VERIFY FIGURED DIMENSIONS PRIOR TO ANY COMMENCEMENT OF WORK ON SITE.						-Relocate eastern side of building K (from L3-to roof le boundary) Approx. 2.0m to the west .Relocate western side of building K		ne			ECTURE		COMMERCIAL
THIS DRAWING IS COPYRIGHT AND SHALL						approximately 1.488m towards the western boundary) Common space. Lanscaped calculatione revised				LEVEL 1, 507 MILITARY ROAD T: 9953 8477	MOSMAN NSW 2088 E: info@wolskicoppin.com.au	PROJECT ADDRESS: 495 - 501 HUNTER STREET	DRAWING TITLE:
REMAIN THE PROPERTY OF WOLSKI COPPIN ARCHITECTURE.						Common space, Lanscaped calculatione revised				DAVID WOLSKI	NSW ARB No. 5297		COMMON SPACE/ LANE
												NEWCASTLE	CALCULATIONS

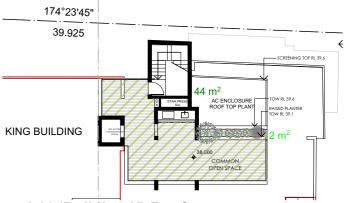

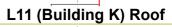

D DEVELOPMENT CATION 2019






LOCATION OF ORIGINAL BUILDING


EXTENT OF NEW BUILDING


NOTES:

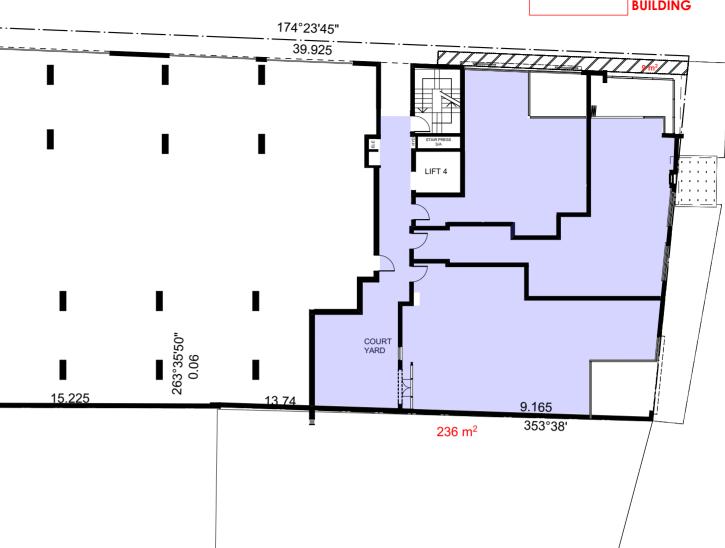

REVISED DEVELOPMENT APPLICATION OCT 2019

THE CON FIGURED COMMEN THIS DRA	NCE TO S TRACTOF DIMENSI CEMENT WING IS PERTY OI CTURE.	SCALED DIMENSIONS. R IS TO CHECK AND VERIFY ONS PRIOR TO ANY OF WORK ON SITE. COPYRIGHT AND SHALL REMAIN F WOLSKI COPPIN
DATE	REV	DESCRIPTION
26 03 19	A	Residential / Commercial GFA Revised
ARCHITEC	Τ:	
		KI. COPPIN
wc	LS	KI.COPPIN
A R) L S С Н	I T E C T U R E
W C A R	DLS CH 507 MILITARY	ITECTURE
W C A R LEVEL 1, 5 T: 9953 84	C H C H 507 MILITARY 015KI	I T E C T U R E (ROAD MOSMAN NSW 2088 E: info@wolskicoppin.com.au
W C A R LEVEL 1, 5 T: 9953 84 DAVID W	DLS CH 507 MILITARY 177 OLSKI TITLE :	I T E C T U R E (ROAD MOSMAN NSW 2088 E: info@wolskicoppin.com.au
A R LEVEL 1, 5 T: 9953 84 DAVID W PROJECT	DLS CH 507 MILITARY 015KI TITLE:	ITECTURE (ROAD MOSMAN NSW 2088 E: Info@wolskicoppin.com.au NSW ARB No. 5297
A R LEVEL 1, 5 T: 9953 84 DAVID W PROJECT T	C H C H 107 MILITARY 177 OLSKI TITLE: MI SIDI	I T E C T U R E MOSMAN NSW 2088 E: Info@wolskicoppin.com.au NSW ARB No. 5297
A R LEVEL 1, 5 T: 9953 84 DAVID W PROJECT T	C H C H 107 MILITARY 177 OLSKI TITLE: MI SIDI	ITECTURE (ROAD MOSMAN NSW 2088 E: Info@wolskicoppin.com.au NSW ARB No. 5297
A R LEVEL 1, 5 T: 9953 84 DAVID W PROJECT T	C H S07 MILITARY 777 OLSKI TITLE: MI SIDI BL	ITECTURE (ROAD MOSMAN NSW 2088 E: Info@wolskicoppin.com.au NSW ARB No. 5227 XED USE ENTIAL FLAT JILDING
PROJECT 1	DLS CH 107 MILITARY 177 OLSKI TITLE: MI SIDI BL	ITECTURE (ROAD MOSMAN NSW 2088 E: Info@wolskicoppin.com.au NSW ARB No. 5227 XED USE ENTIAL FLAT JILDING
PROJECT 1	C H 507 MILITARY 177 OLSKI TITLE: MI SIDI BL ADDRESS 495-	I T E C T U R E MOSMAN NSW 2088 E: Info@wolskicoppin.com.au NSW ARB No. 5297 XED USE ENTIAL FLAT JILDING
PROJECT 1	DLS CH 507 MILITARY 777 OLSKI TITLE: MI SIDI BL ADDRESS 495-	I T E C T U R E MOSMAN NSW 2088 E: Info@wolddooppin.com.au NSW ARB No. 5297 XED USE ENTIAL FLAT JILDING
PROJECT 1	DLS CH 507 MILITARY 777 OLSKI TITLE: MI SIDI BL ADDRESS 495-	I T E C T U R E MOSMAN NSW 2088 E: Info@woldkicoppin.com.au NSW ARB No. 5277 XED USE ENTIAL FLAT JILDING 5: -501 HUNTER STREET
PROJECT 1	DLS CH 507 MILITARY 777 OLSKI TITLE: MI SIDI BL ADDRESS 495-	I T E C T U R E MOSMAN NSW 2088 E: Info@woldkicoppin.com.au NSW ARB No. 5277 XED USE ENTIAL FLAT JILDING 5: -501 HUNTER STREET
PROJECT /	DLS CH 507 MILITARY 177 OLSKI TITLE: MI SIDI BU ADDRESS 495-	LTECTURE MOSMAN NSW 2088 E: Info@wolddooppin.com.au NSW ARB No. 5297 XED USE ENTIAL FLAT JILDING 5: -501 HUNTER STREET EWCASTLE
PROJECT /	DLS CH SOT MILITARY TTTLE: MI SIDI BL ADDRESS 495- NE	A T E C T U R E MOSMAN NSW 2088 E: Info@woldcoppin.com.au NSW ARB No. 5297 XED USE ENTIAL FLAT JILDING 5: -501 HUNTER STREET EWCASTLE ERRELATE &
PROJECT /	DLS CH 507 MILITARY 177 OLSKI TITLE: MI SIDI BU ADDRESS 495- NE	I T E C T U R E MOSMAN NSW 2088 E: Info@wolddooppin.com.au NSW ARB No. 5297 XED USE ENTIAL FLAT JILDING 5: -501 HUNTER STREET EWCASTLE ERRELATE & DOWLING
PROJECT /	DLS CH 507 MILITARY 177 OLSKI TITLE: MI SIDI BU ADDRESS 495- NE	A T E C T U R E MOSMAN NSW 2088 E: Info@woldcoppin.com.au NSW ARB No. 5297 XED USE ENTIAL FLAT JILDING 5: -501 HUNTER STREET EWCASTLE ERRELATE &
PROJECT /	DLS CH 307 MILITARY 177 OLSKI TITLE: MI SIDI BU ADDRESS 495- NE INTE CO	I T E C T U R E MOSMAN NSW 2088 E: Info@wolddooppin.com.au NSW ARB No. 5297 XED USE ENTIAL FLAT JILDING 5: -501 HUNTER STREET EWCASTLE ERRELATE & DOWLING
PROJECT 7	DLS CH 307 MILITARY 177 OLSKI TITLE: MI SIDI BU ADDRESS 495- NE INTE CO	I T E C T U R E MOSMAN NSW 2088 E: Info@wolddooppin.com.au NSW ARB No. 5297 XED USE ENTIAL FLAT JILDING 5: -501 HUNTER STREET EWCASTLE ERRELATE & DOWLING
PROJECT 7 CLIENT:	DLS CH S07 MILITARY 177 OLSKI TITLE: MI SIDI BU ADDRESS 495- NE INTE CO	I T E C T U R E MOSMAN NSW 2088 E: Info@wolddooppin.com.au NSW ARB No. 5297 XED USE ENTIAL FLAT JILDING 5: -501 HUNTER STREET EWCASTLE ERRELATE & DOWLING
PROJECT 7 CLIENT:	DLS CH S07 MILITARY 177 OLSKI TITLE: MI SIDI BU ADDRESS 495- NE INTE CO	ALCULATIONS
RE PROJECT 7 CLIENT: DRAWING	ACC	I T E C T U R E MOSMAN NSW 2088 E: Info@wolddooppin.com.du NSW ARB No. 5297 XED USE ENTIAL FLAT JILDING 3: 501 HUNTER STREET EWCASTLE ERRELATE & OWLING MMERCIAL
PROJECT / CLIENT: DRAWING PROJECT /	NE NOT	ALCULATIONS DRAWING No:
RE PROJECT 7 CLIENT: DRAWING	NE NOT	I T E C T U R E MOSMAN NSW 2088 E: Info@wolddooppin.com.du NSW ARB No. 5297 XED USE ENTIAL FLAT JILDING 3: 501 HUNTER STREET EWCASTLE ERRELATE & OWLING MMERCIAL
PROJECT / CLIENT: DRAWING PROJECT /	DLS CH S77 OLSKI TITLE: MI SIDI BL ADDRESS 495- NE INTE CO TITLE: ACC	ALCULATIONS DRAWING No: CFACULATIONS DRAWING No: CFACULATIONS
PROJECT 7 CLIENT: DRAWING PROJECT 7 RE PROJECT 7 CLIENT: DRAWING PROJECT 1 PROJECT 1 PROJECT 1	DLS CH S77 OLSKI TITLE: MI SIDI BL ADDRESS 495- NE INTE CO TITLE: ACC	ALCULATIONS DRAWING No:
PROJECT 7 CLIENT: DRAWING PROJECT 7 RE PROJECT 7 CLIENT: DRAWING PROJECT 1 PROJECT 1 PROJECT 1	DLS CH S77 OLSKI TITLE: MI SIDI BL ADDRESS 495- NE INTE CO TITLE: ACC	ALCULATIONS DRAWING No: CFACULATIONS DRAWING No: CFACULATIONS
PROJECT 7 CLIENT: DRAWING CLIENT: CLIENT: DRAWING CLIENT: DRAWING CLIENT: C	ADDRESS ADDRES	ALCULATIONS DRAWING No: CONTH POINT: CONTH POINT: CONT
PROJECT 7 CLIENT: DRAWING CLIENT: CLIENT: DRAWING CLIENT: DRAWING CLIENT: C	DLS CH S77 OLSKI TITLE: MI SIDI BL ADDRESS 495- NE INTE CO TITLE: ACC	ALCULATIONS DRAWING NO: CONTH POINT: CALCULATE: CONTH POINT: CALCULATE: CALCULATE: CONTH POINT: CALCULATE:
RE PROJECT 7 CLIENT: CLIENT: DRAWING CLIENT: PROJECT 7 PROJECT 7 REVISION: REVISION: CLIENT:	ADDRESS ADDRES	ALCULATIONS DRAWING No: CONTH POINT: CONTH POINT: CONT
REVISION: CLIENT: C	D L S C H 307 MILITARY 777 015KI TITLE: MI SIDI BL ADDRESS 495- NE 1NTE CO TITLE: NO: 706 0@A2	ALCULATIONS DRAWING NO: CALCULATIONS DRAWING NO: CFAO1 NORTH POINT: PLOT DATE: 2 2 2 2 2 2 2 2 2 2 2 2 2
PROJECT 7 CLIENT: C	D L S C H 507 MILITARY 7015KI TITLE: MI SIDI BL ADDRESS 495- NE INTE CO TITLE: A C/ 106 107 106 107 106 107 107 107 107 107 107 107 107	ALCULATIONS DRAWING No: CONTH POINT: CONTH POINT: CONT

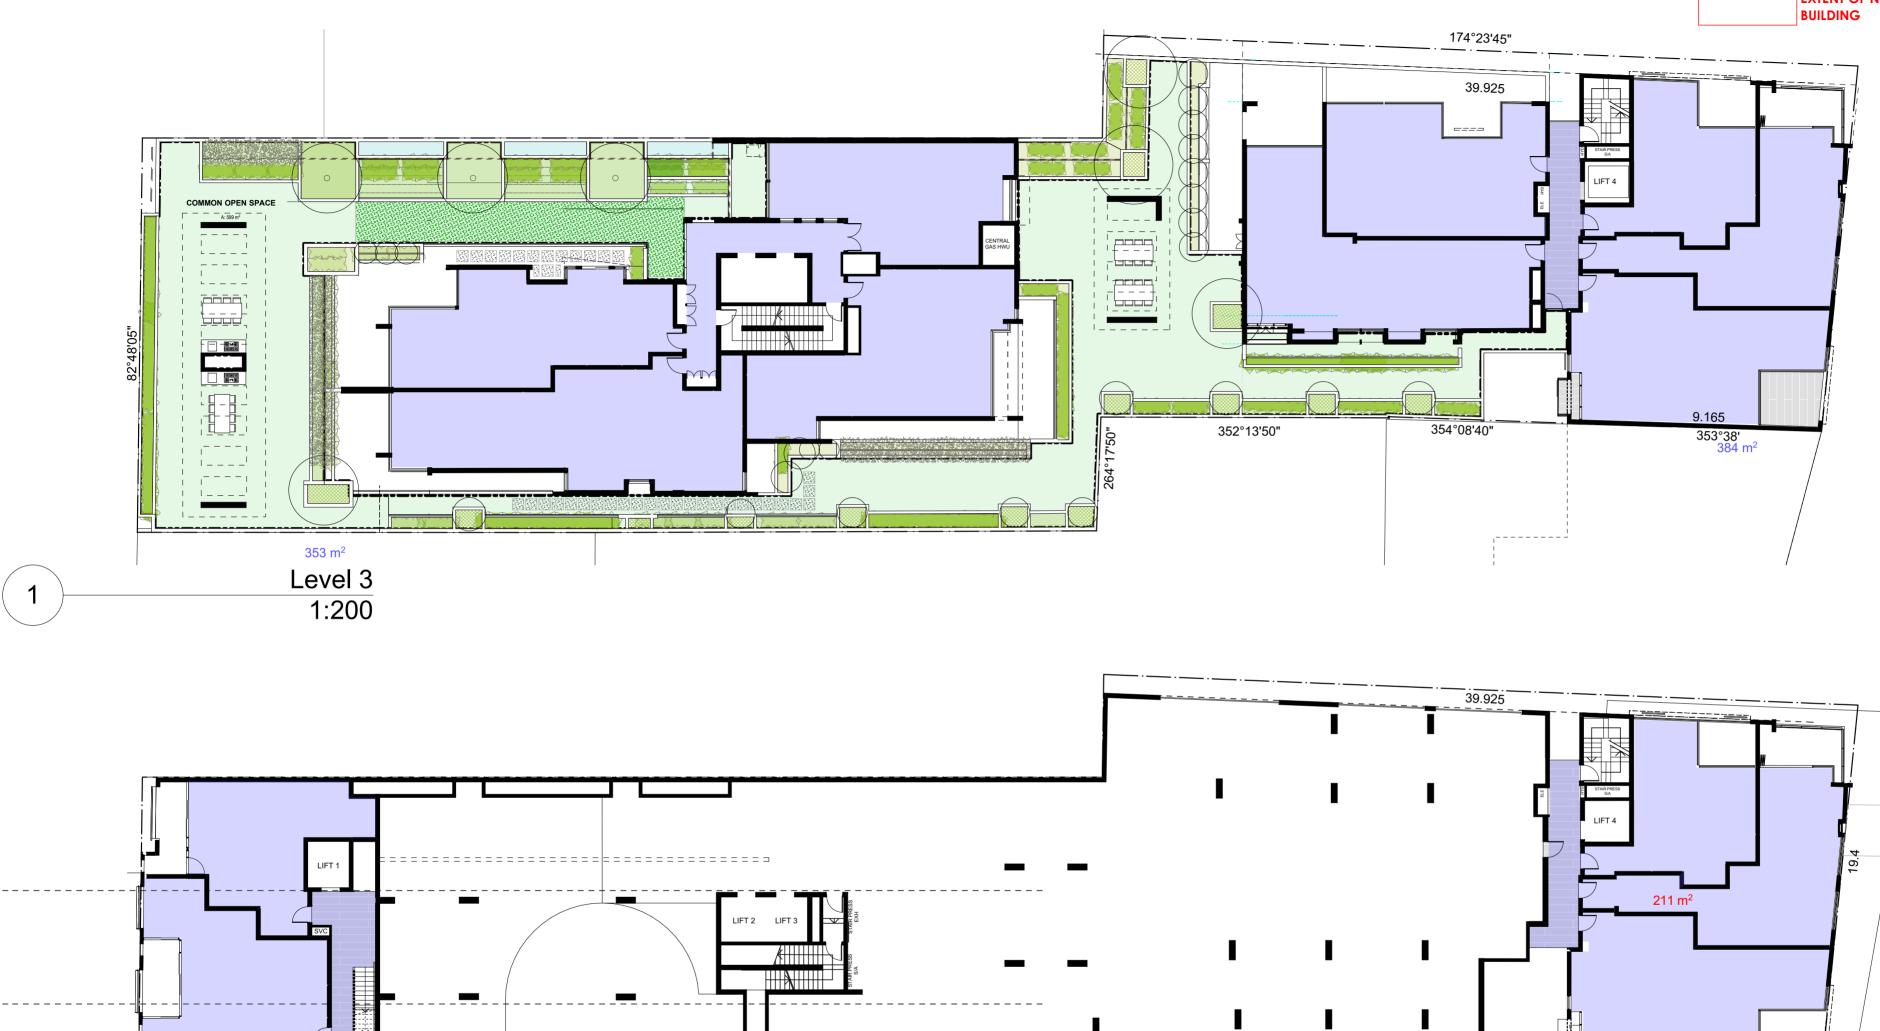

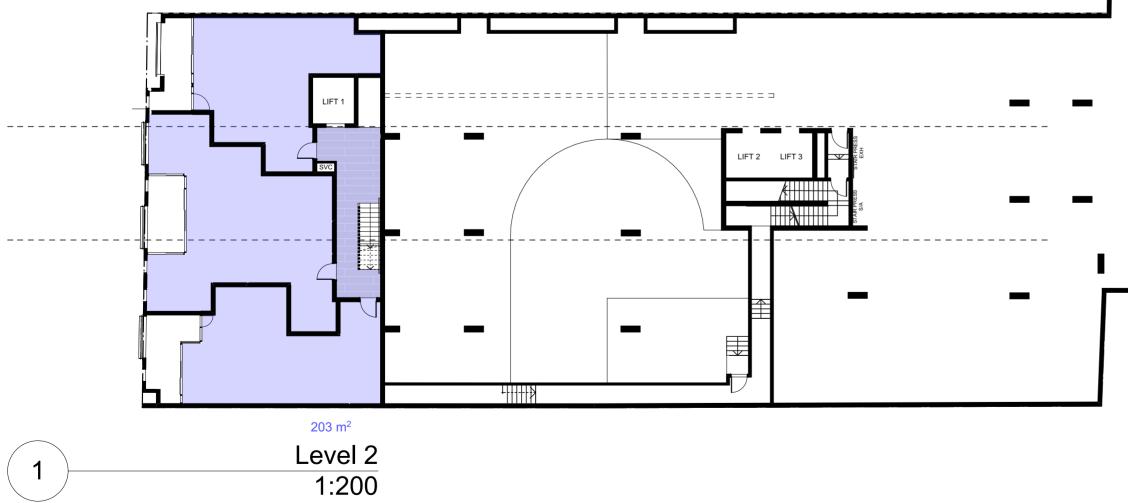





EXTENT OF NEW

REVISED DEVELOPMENT APPLICATION OCT 2019

9.165 353°38'

	RCHITE		
CHITE A Residential GFA Revised 60919 B Residential GFA Revised 60910 B B 60010 B B 60100 B B 60010 B C 100000	VISIONS	ò:	
COURT IN Residential GFA Revised 6.09 19 B B 6.00 10 C C 7.00 10 C <th>ATE</th> <th>REV</th> <th>DESCRIPTION</th>	ATE	REV	DESCRIPTION
	26 03 19	-	
ICHITECT: WOLSKI.COPPIN A R C H I T E C T U R E MOSMAN NSW 2088 I SYSS 8477 E INFORWORKICOPPIN.COM.OU NSW ARB NO. 5297 IDAVID WOLSKI INTER ED USE RESIDENTIAL FLAT BUILDING INTERRELATE & DOWLING COMMERCIAL INTERRELATE & DOWLING COMMERCIAL INTERRELATE & DOWLING COMMERCIAL INTERRELATE & DOWLING COMMERCIAL INTER INTE	0 03 13		
ICHITECT: WOLSKI.COPPIN A R C H I T E C T U R E MOSMAN NSW 2088 I SYSS 8477 E INFORWORKICOPPIN.COM.OU NSW ARB NO. 5297 IDAVID WOLSKI INTER ED USE RESIDENTIAL FLAT BUILDING INTERRELATE & DOWLING COMMERCIAL INTERRELATE & DOWLING COMMERCIAL INTERRELATE & DOWLING COMMERCIAL INTERRELATE & DOWLING COMMERCIAL INTER INTE			
ICHITECT: WOLSKI.COPPIN A R C H I T E C T U R E MOSMAN NSW 2088 I SYSS 8477 E INFORWORKICOPPIN.COM.OU NSW ARB NO. 5297 IDAVID WOLSKI INTER ED USE RESIDENTIAL FLAT BUILDING INTERRELATE & DOWLING COMMERCIAL INTERRELATE & DOWLING COMMERCIAL INTERRELATE & DOWLING COMMERCIAL INTERRELATE & DOWLING COMMERCIAL INTER INTE			
CHITECT: WOLSKI.COPPIN A R C H I T E C T U R E MOSMAN NSW 2088 IEVEL 1, 507 MULTARY ROAD DAVID WOLSKI DAVID WOLSKI DAVID WOLSKI MIXED USE RESIDENTIAL FLAT BUILDING OJECT TITLE: MIXED USE RESIDENTIAL FLAT BUILDING OJECT ADDRESS: 495-501 HUNTER STREET NEWCASTLE INTERRELATE & DOWLING COMMERCIAL AWING TITLE: GFA CALCULATIONS 02 OJECT NO: DRAWING NO: 21706 CIECT NO: DRAWING NO: 21706 CIECT NO: NORTH POINT: NORTH POINT: CIECT DATE: 1:200@A2 2/10/2019			
CHITECT: WOLSKI.COPPIN A R C H I T E C T U R E MOSMAN NSW 2088 IEVEL 1, 507 MILITARY ROAD DAVID WOLSKI DAVID WOLSKI DAVID WOLSKI MIXED USE RESIDENTIAL FLAT BUILDING OJECT ADDRESS: 495-501 HUNTER STREET NEWCASTLE INTERRELATE & DOWLING COMMERCIAL AWING TITLE: CFA CALCULATIONS 02 OJECT NO: DRAWING NO: 21706 CIECT NO: DRAWING NO: 21706 CIECT NO: CIECT NO: CI			
CHITECT: WOLSKI.COPPIN A R C H I T E C T U R E MOSMAN NSW 2088 IEVEL 1, 507 MILITARY ROAD DAVID WOLSKI DAVID WOLSKI DAVID WOLSKI MIXED USE RESIDENTIAL FLAT BUILDING OJECT ADDRESS: 495-501 HUNTER STREET NEWCASTLE INTERRELATE & DOWLING COMMERCIAL AWING TITLE: CFA CALCULATIONS 02 OJECT NO: DRAWING NO: 21706 CIECT NO: DRAWING NO: 21706 CIECT NO: CIECT NO: CI			
CHITECT: WOLSKI.COPPIN A R C H I T E C T U R E MOSMAN NSW 2088 IEVEL 1, 507 MULTARY ROAD DAVID WOLSKI DAVID WOLSKI DAVID WOLSKI MIXED USE RESIDENTIAL FLAT BUILDING OJECT TITLE: MIXED USE RESIDENTIAL FLAT BUILDING OJECT ADDRESS: 495-501 HUNTER STREET NEWCASTLE INTERRELATE & DOWLING COMMERCIAL AWING TITLE: GFA CALCULATIONS 02 OJECT NO: DRAWING NO: 21706 CIECT NO: DRAWING NO: 21706 CIECT NO: NORTH POINT: NORTH POINT: CIECT DATE: 1:200@A2 2/10/2019			
ICHITECT: WOLSKI.COPPIN A R C H I T E C T U R E MOSMAN NSW 2088 I SYSS 8477 E INFORWORKICOPPIN.COM.OU NSW ARB NO. 5297 IDAVID WOLSKI INTER ED USE RESIDENTIAL FLAT BUILDING INTERRELATE & DOWLING COMMERCIAL INTERRELATE & DOWLING COMMERCIAL INTERRELATE & DOWLING COMMERCIAL INTERRELATE & DOWLING COMMERCIAL INTER INTE			
ICHITECT: WOLSKI.COPPIN A R C H I T E C T U R E MOSMAN NSW 2088 I SYSS 8477 E INFORWORKICOPPIN.COM.OU NSW ARB NO. 5297 IDAVID WOLSKI INTER ED USE RESIDENTIAL FLAT BUILDING INTERRELATE & DOWLING COMMERCIAL INTERRELATE & DOWLING COMMERCIAL INTERRELATE & DOWLING COMMERCIAL INTERRELATE & DOWLING COMMERCIAL INTER INTE			
CHITECT: WOLSKI.COPPIN A R C H I T E C T U R E MOSMAN NSW 2088 IEVEL 1, 507 MULTARY ROAD DAVID WOLSKI DAVID WOLSKI DAVID WOLSKI MIXED USE RESIDENTIAL FLAT BUILDING OJECT TITLE: MIXED USE RESIDENTIAL FLAT BUILDING OJECT ADDRESS: 495-501 HUNTER STREET NEWCASTLE INTERRELATE & DOWLING COMMERCIAL AWING TITLE: GFA CALCULATIONS 02 OJECT NO: DRAWING NO: 21706 CIECT NO: DRAWING NO: 21706 CIECT NO: NORTH POINT: NORTH POINT: CIECT DATE: 1:200@A2 2/10/2019			
ICHITECT: WOLSKI.COPPIN A R C H I T E C T U R E MOSMAN NSW 2088 I SYSS 8477 E INFORWORKICOPPIN.COM.OU NSW ARB NO. 5297 IDAVID WOLSKI INTER ED USE RESIDENTIAL FLAT BUILDING INTERRELATE & DOWLING COMMERCIAL INTERRELATE & DOWLING COMMERCIAL INTERRELATE & DOWLING COMMERCIAL INTERRELATE & DOWLING COMMERCIAL INTER INTE			
CHITECT: WOLSKI.COPPIN A R C H I T E C T U R E MOSMAN NSW 2088 IEVEL 1, 507 MULTARY ROAD DAVID WOLSKI DAVID WOLSKI DAVID WOLSKI MIXED USE RESIDENTIAL FLAT BUILDING OJECT TITLE: MIXED USE RESIDENTIAL FLAT BUILDING OJECT ADDRESS: 495-501 HUNTER STREET NEWCASTLE INTERRELATE & DOWLING COMMERCIAL AWING TITLE: GFA CALCULATIONS 02 OJECT NO: DRAWING NO: 21706 CIECT NO: DRAWING NO: 21706 CIECT NO: NORTH POINT: NORTH POINT: CIECT DATE: 1:200@A2 2/10/2019			
CHITECT: WOLSKI.COPPIN A R C H I T E C T U R E MOSMAN NSW 2088 IEVEL 1, 507 MULTARY ROAD DAVID WOLSKI DAVID WOLSKI DAVID WOLSKI MIXED USE RESIDENTIAL FLAT BUILDING OJECT TITLE: MIXED USE RESIDENTIAL FLAT BUILDING OJECT ADDRESS: 495-501 HUNTER STREET NEWCASTLE INTERRELATE & DOWLING COMMERCIAL AWING TITLE: GFA CALCULATIONS 02 OJECT NO: DRAWING NO: 21706 CIECT NO: DRAWING NO: 21706 CIECT NO: NORTH POINT: NORTH POINT: CIECT DATE: 1:200@A2 2/10/2019			
ICHITECT: WOLSKI.COPPIN A R C H I T E C T U R E MOSMAN NSW 2088 I SYSS 8477 E INFORWORKICOPPIN.COM.OU NSW ARB NO. 5297 IDAVID WOLSKI INTER ED USE RESIDENTIAL FLAT BUILDING INTERRELATE & DOWLING COMMERCIAL INTERRELATE & DOWLING COMMERCIAL INTERRELATE & DOWLING COMMERCIAL INTERRELATE & DOWLING COMMERCIAL INTER INTE			
ICHITECT: WOLSKI.COPPIN A R C H I T E C T U R E MOSMAN NSW 2088 I SYSS 8477 E INFORWORKICOPPIN.COM.OU NSW ARB NO. 5297 IDAVID WOLSKI INTER ED USE RESIDENTIAL FLAT BUILDING INTERRELATE & DOWLING COMMERCIAL INTERRELATE & DOWLING COMMERCIAL INTERRELATE & DOWLING COMMERCIAL INTERRELATE & DOWLING COMMERCIAL INTER INTE			
A R C H I T E C T U R E LEVEL 1, 507 MILITARY ROAD TY953 8477 COJECT TITLE: MIXED USE RESIDENTIAL FLAT BUILDING COJECT ADDRESS: 495-501 HUNTER STREET NEWCASTLE INTERRELATE & DOWLING COMMERCIAL AWING TITLE: CIECT NO: DRAWING NO: 21706 CIECT NO: DRAWING NO: CIECT NO			_
A R C H I T E C T U R E LEVEL 1, 507 MILITARY ROAD TY953 8477 COJECT TITLE: MIXED USE RESIDENTIAL FLAT BUILDING COJECT ADDRESS: 495-501 HUNTER STREET NEWCASTLE INTERRELATE & DOWLING COMMERCIAL AWING TITLE: CIECT NO: DRAWING NO: 21706 CIECT NO: DRAWING NO: CIECT NO			_
LEVEL 1, 507 MILITARY ROAD MOSMAIN NSW 2088 2 Y953 8477 E info@wolskicooppin.com.au DAVID WOLSKI NIX ED USE MIXED USE RESIDENTIAL FLAT BUILDING COJECT TITLE: MIXED USE APS5-501 HUNTER STREET NEWCASTLE INTERRELATE & DOWLING COMMERCIAL INTERRELATE & DOWLING COMMERCIAL APSFACEULATIONS COMMERCIAL INTERRELATE & DOWLING COMMERCIAL INTERRELATE & DOWLING COMMERCIAL GFA CALCULATIONS 02 OJECT No: DRAWING NO: QUECT NO: DIT DATE: 1:200 @ A2 2/10/2019<	CHITEC	T:	
DAVID WOLSKI OJECT TITLE:		⊤:) L S	KI.COPPIN
ALE: PLOT DATE: AIXED USE RESIDENTIAL FLAT BUILDING A95-501 HUNTER STREET NEWCASTLE A95-501 HUNTER STREET NEWCASTLE A95-501 HUNTER STREET NEWCASTLE A95-501 HUNTER STREET NEWCASTLE A95-501 HUNTER STREET DOWLING COMMERCIAL DOWLING COMMERCIAL COMMERCI		т:) L S с ғ	KI.COPPIN
MIXED USE RESIDENTIAL FLAT BUILDING OJECT ADDRESS: 495-501 HUNTER STREET NEWCASTLE INTERRELATE & DOWLING COMMERCIAL WING TITLE: GFA CALCULATIONS 02 OJECT NO: DRAWING NO: 21706 GFA02 VISION: NORTH POINT: B JECT DATE: 1:200@A2 2/10/2019	CHITEC WC A R LEVEL 1, 3 T: 9953 84	T:) L S C F 507 MILITAI 477	KI . COPPIN HITECTURE RY ROAD MOSMAN NSW 2088 E: info@wolskicoppin.com.au
RESIDENTIAL FLAT BUILDING COJECT ADDRESS: 495-501 HUNTER STREET NEWCASTLE INTERRELATE & DOWLING COMMERCIAL WING TITLE: GFA CALCULATIONS 02 COJECT NO: DRAWING NO: 21706 CALE: PLOT DATE: 1:200@A2 2/10/2019	A R LEVEL 1, 3 T: 9953 84 DAVID W	T: DLS CH 507 militai 477 YOLSKI	KI . COPPIN HITECTURE RY ROAD MOSMAN NSW 2088 E: info@wolskicoppin.com.au
BUILDING OJECT ADDRESS: 495-501 HUNTER STREET NEWCASTLE IENT: INTERRELATE & DOWLING COMMERCIAL AWING TITLE: GFA CALCULATIONS 02 OJECT No: DRAWING NO: 21706 CALE: PLOT DATE: 1:200@A2 2/10/2019	A R LEVEL 1, 3 T: 9953 84 DAVID W	T: DLS CF 507 MILITAI 477 'OLSKI TITLE:	KI. COPPIN HITECTURE RY ROAD MOSMAN NSW 2088 E: Info@wolkkicoppin.com.au NSW ARB No. 5297
AP5-501 HUNTER STREET NEWCASTLE IENT: INTERRELATE & DOWLING COMMERCIAL AWING TITLE: GFA CALCULATIONS 02 OJECT No: DRAWING NO: 21706 GFA02 VISION: NORTH POINT: B ALLE: PLOT DATE: 1:200@A2 2/10/2019	A R LEVEL 1, 4 DAVID W	T: C F 507 MILITAI 477 YOLSKI TITLE: M	KI. COPPIN HITECTURE MOSMAN NSW 2088 E: info@wolkkicoppin.com.au NSW ARB No. 5297
AP5-501 HUNTER STREET NEWCASTLE IENT: INTERRELATE & DOWLING COMMERCIAL AWING TITLE: GFA CALCULATIONS 02 OJECT No: DRAWING NO: 21706 GFA02 VISION: NORTH POINT: B ALLE: PLOT DATE: 1:200@A2 2/10/2019	A R LEVEL 1, 4 DAVID W	T: C F 507 MILITAI 477 YOLSKI TITLE: M	KI. COPPIN HITECTURE MOSMAN NSW 2088 E: info@wolkkicoppin.com.au NSW ARB No. 5297
495-501 HUNTER STREET NEWCASTLE INTERRELATE & DOWLING COMMERCIAL C	A R LEVEL 1, 4 DAVID W	T: DLS CH 507 MILITAI 477 YOLSKI TITLE: M	KI.COPPIN HITECTURE RY ROAD MOSMAN NSW 2088 E: info@wolskicoppin.com.au NSW ARB No. 5297
STREET NEWCASTLE INTERRELATE & DOWLING COMMERCIAL AWING TITLE: GFA CALCULATIONS 02 OJECT No: DRAWING NO: 21706 GFA02 VISION: NORTH POINT: B ZALE: PLOT DATE: 1:200@A2 2/10/2019	A R LEVEL 1, 3 T: 9953 84 DAVID W	T: DLS C F 507 MILITAI 477 1015KI TITLE: M SID B	KI.COPPIN HITECTURE RYROAD MOSMAN NSW 2088 E: Info@wolkkicoppin.com.au NSW ARB NO. 5297
NEWCASTLE IENT: INTERRELATE & DOWLING COMMERCIAL AWING TITLE: GFA CALCULATIONS 02 OJECT NO: DRAWING NO: 21706 CALE: PLOT DATE: 1:200@A2 2/10/2019	A R LEVEL 1, 3 T: 9953 84 DAVID W	T: DLS C F 507 MILITAI 477 FOLSKI TITLE: M SID B ADDRES	KI. COPPIN HITECTURE MOSMAN NSW 2088 E: Info@wolkkicoppin.com.au NSW ARB No. 5297 IXED USE DENTIAL FLAT UILDING
IENT: INTERRELATE & DOWLING COMMERCIAL AWING TITLE: GFA CALCULATIONS 02 CJECT NO: DRAWING NO: 21706 CFA02 VISION: NORTH POINT: B FLOT DATE: 1:200@A2 2/10/2019	A R LEVEL 1, 3 T: 9953 84 DAVID W	T: DLS C F 507 MILITAI 477 FOLSKI TITLE: M SID B ADDRES	KI.COPPIN HITECTURE RY ROAD E: Info@wolkGoopin.com.au NSW ARB No. 5297 IXED USE DENTIAL FLAT UILDING 55: 5-501 HUNTER
INTERRELATE & DOWLING COMMERCIAL	A R LEVEL 1.3 DAVID W OJECT	T: DLS CF 507 MILITAL 477 YOLSKI TITLE: M SID B ADDRES 495	KI.COPPIN HITECTURE RY ROAD E:Info@wolskicoppin.com.au NSW ARB No.5227 IXED USE DENTIAL FLAT UILDING 55: 5-501 HUNTER STREET
INTERRELATE & DOWLING COMMERCIAL	A R LEVEL 1.3 DAVID W OJECT	T: DLS CF 507 MILITAL 477 YOLSKI TITLE: M SID B ADDRES 495	KI.COPPIN HITECTURE RY ROAD E:Info@wolskicoppin.com.au NSW ARB No.5227 IXED USE DENTIAL FLAT UILDING 55: 5-501 HUNTER STREET
DOWLING COMMERCIAL AWING TITLE: GFA CALCULATIONS 02 OJECT NO: DRAWING NO: 21706 GFA02 VISION: NORTH POINT: B ALE: PLOT DATE: 1:200@A2 2/10/2019	A R LEVEL 1.3 DAVID W OJECT	T: DLS CF 507 MILITAL 477 YOLSKI TITLE: M SID B ADDRES 495	KI.COPPIN HITECTURE RY ROAD E:Info@wolskicoppin.com.au NSW ARB No.5227 IXED USE DENTIAL FLAT UILDING 55: 5-501 HUNTER STREET
DOWLING COMMERCIAL AWING TITLE: GFA CALCULATIONS 02 OJECT NO: DRAWING NO: 21706 GFA02 VISION: NORTH POINT: B ALE: PLOT DATE: 1:200@A2 2/10/2019	A R LEVEL 1, 1, DAVID W OJECT	T: DLS CF 507 MILITAL 477 YOLSKI TITLE: M SID B ADDRES 495	KI.COPPIN HITECTURE RY ROAD E:Info@wolskicoppin.com.au NSW ARB No.5227 IXED USE DENTIAL FLAT UILDING 55: 5-501 HUNTER STREET
COMMERCIAL AWING TITLE: GFA CALCULATIONS 02 OJECT No: DRAWING No: 21706 GFA02 VISION: NORTH POINT: B ALLE: PLOT DATE: 1:200@A2 2/10/2019	CHITEC CHITEC A R LEVEL 1. 1 17: 9953 8- DAVID W OJECT RE	T: DLS C F 507 MILITAL 477 YOLSKI TITLE: M SID B ADDRES 495 N	KI.COPPIN HITECTURE MOSMAN NSW 2088 E Info@wolskicoppin.com.au NSW ARB No. 5297 IXED USE DENTIAL FLAT UILDING 35: 5-501 HUNTER STREET IEWCASTLE
RAWING TITLE: GFA CALCULATIONS 02 OJECT NO: 21706 DRAWING NO: 21706 GFA02 VISION: NORTH POINT: B \$	CHITEC CHITEC A R LEVEL 1. 1 17: 9953 8- DAVID W OJECT RE	T: DLS C F 507 MILITAI 477 FOLSKI TITLE: M SID B ADDRES 495 N INT	KI.COPPIN HITECTURE MOSMAN NSW 2088 E: Info@WolkGoopin.com.cu NSW ARB No. 5297 IXED USE DENTIAL FLAT UILDING 55: 5-501 HUNTER STREET IEWCASTLE
GFA CALCULATIONS 02 OJECT No: DRAWING No: 21706 GFA02 VISION: NORTH POINT: B FOR FACE ALE: PLOT DATE: 1:200@A2 2/10/2019	A R LEVEL 1, 1, DAVID W OJECT	T: DLS C F 507 MILITAL 477 FOLSKI TITLE: M SID B ADDRES 495 N INT [KI.COPPIN I T E C T U R E MOSMAN NSW 2088 E INFORWORKGORPHILCOM.CU NSW ARB NO. 5297 IXED USE DENTIAL FLAT UILDING 55: 5-501 HUNTER STREET IEWCASTLE IERRELATE & DOWLING
02 21706 DRAWING No: 21706 GFA02 VISION: NORTH POINT: B ALE: PLOT DATE: 1:200@A2 2/10/2019	A R LEVEL 1, 1, DAVID W OJECT	T: DLS C F 507 MILITAL 477 FOLSKI TITLE: M SID B ADDRES 495 N INT [KI.COPPIN I T E C T U R E MOSMAN NSW 2088 E INFORWORKGORPHILCOM.CU NSW ARB NO. 5297 IXED USE DENTIAL FLAT UILDING 55: 5-501 HUNTER STREET IEWCASTLE IERRELATE & DOWLING
02 21706 DRAWING No: 21706 GFA02 VISION: NORTH POINT: B ALE: PLOT DATE: 1:200@A2 2/10/2019	CHITEC WC AR IEVEL 1, 1 T: 9953 84 DAVID W OJECT T IENT:	T: DLS CF 507 MILITAL 477 YOLSKI TITLE: M SID SID B ADDRES 4955 N INT [CC	KI.COPPIN I T E C T U R E MOSMAN NSW 2088 E INFORWORKGORPHILCOM.CU NSW ARB NO. 5297 IXED USE DENTIAL FLAT UILDING 55: 5-501 HUNTER STREET IEWCASTLE IERRELATE & DOWLING
OJECT No: DRAWING No: 21706 GFA02 VISION: NORTH POINT: B ≥ CALE: PLOT DATE: 1:200@A2 2/10/2019	CHITEC CHITEC CAR LEVEL 1.1 17: 9953 8- DAVID W OJECT COJECT	T: DLS CF 507 MILITAL 477 YOLSKI TITLE: M SID SID B ADDRES 4955 N INT [CC	KI.COPPIN I T E C T U R E MOSMAN NSW 2088 E INFORWORKGORPHILCOM.CU NSW ARB NO. 5297 IXED USE DENTIAL FLAT UILDING 55: 5-501 HUNTER STREET IEWCASTLE IERRELATE & DOWLING
OJECT No: DRAWING No: 21706 GFA02 VISION: NORTH POINT: B A ALE: PLOT DATE: 1:200@A2 2/10/2019	CHITEC CHITEC CAR LEVEL 1. 1 17: 9953 8 DAVID W OJECT RE OJECT	T: DLS C F 507 MILITAL 477 FOLSKI TITLE: M SID SID B ADDRES 495 N INT [CC TITLE:	SKICOPPIN HITECTURE MOSMAN NSW 2088 E Info@WolkkGoppin.com.cu NSW ARB No. 5297 IXED USE DENTIAL FLAT UILDING 35: 5-501 HUNTER STREET IEWCASTLE IERRELATE & DOWLING DMMERCIAL
21706 GFA02 VISION: NORTH POINT: B PLOT DATE: 1:200@A2 2/10/2019	CHITEC CHITEC CAR LEVEL 1. 1 17: 9953 8 DAVID W OJECT RE OJECT	T: DLS C F 507 MILITAL 477 FOLSKI TITLE: M SID SID B ADDRES 495 N INT [CC TITLE:	SKI.CULATIONS
21706 GFA02 VISION: NORTH POINT: B PLOT DATE: 1:200@A2 2/10/2019	CHITEC CHITEC CAR LEVEL 1. 1 17: 9953 8 DAVID W OJECT RE OJECT	T: DLS C F 507 MILITAL 477 FOLSKI TITLE: M SID SID B ADDRES 495 N INT [CC TITLE:	SKI.CULATIONS
NORTH POINT: B ALE: PLOT DATE: 1:200@A2 2/10/2019	CHITEC WC A R LEVEL 1, 1 T: 9953 8 DAVID W OJECT RE	T: DLS C F 507 MILITAL 477 FOLSKI TITLE: M SID SID ADDRES 495 N INT [CC TITLE: CC	KI.CULATIONS KI.COPPIN MITECTULATIONS KI.CULATIONS
B ≥ ↓ ↓ ↓ ↓ ↓ ↓ ↓ ↓ ↓ ↓ ↓ ↓ ↓ ↓ ↓ ↓ ↓ ↓	CHITEC WC A R LEVEL 1, 1 17: 9953 84 DAVID W OJECT RE OJECT	T: DLS C F 507 MILITAL 477 FOLSKI TITLE: M SID B ADDRES 4955 N INT [CC TITLE: NO:	SKICOPPIN H I T E C T U R E MOSMAN NSW 2088 E INFORWORKICOPPIN.COM.CU NSW ARB NO. 5297 IXED USE DENTIAL FLAT UILDING 35: 5-501 HUNTER STREET IEWCASTLE IERRELATE & DOWLING DMMERCIAL ALCULATIONS 02 DRAWING NO:
B ≥ ↓ ↓ ↓ ↓ ↓ ↓ ↓ ↓ ↓ ↓ ↓ ↓ ↓ ↓ ↓ ↓ ↓ ↓	CHITEC WC A R LEVEL 1, 1 17: 9953 84 DAVID W OJECT RE OJECT	T: DLS C F 507 MILITAL 477 FOLSKI TITLE: M SID B ADDRES 4955 N INT [CC TITLE: NO:	SKICOPPIN H I T E C T U R E MOSMAN NSW 2088 E INFORWORKICOPPIN.COM.CU NSW ARB NO. 5297 IXED USE DENTIAL FLAT UILDING 35: 5-501 HUNTER STREET IEWCASTLE IERRELATE & DOWLING DMMERCIAL ALCULATIONS 02 DRAWING NO:
1:200 @ A2 2/10/2019	CHITEC WC A R LEVEL 1, 1 17: 9953 8 DAVID W OJECT COJECT IENT: COJECT	T: DLS C F 507 MILITAL 477 FOLSKI TITLE: M SID SID SID ADDRES 495 N INT [CC TITLE: No: 706	SKI.COPPIN A I T E C T U R E MOSMAN NSW 2088 E INFORMAN NOT STREET IEWCASTLE IERRELATE & DOWLING DMMERCIAL ALCULATIONS 02 DRAWING NOT GFA02
1:200 @ A2 2/10/2019	CHITEC WC A R LEVEL 1, 1 1:9953 8 DAVID W COJECT IENT: COJECT COJECT COJECT COJECT COJECT	T: DLS C F 507 MILITAL 477 FOLSKI TITLE: M SID SID SID ADDRES 495 N INT [CC TITLE: No: 706	SKI.COPPIN A I T E C T U R E MOSMAN NSW 2088 E INFORMAN NOT STREET IEWCASTLE IERRELATE & DOWLING DMMERCIAL ALCULATIONS 02 DRAWING NOT GFA02
1:200 @ A2 2/10/2019	CHITEC WC A R LEVEL 1, 1 17: 9953 8 DAVID W OJECT COJECT IENT: COJECT	T: DLS C F 507 MILITAL 477 FOLSKI TITLE: M SID SID SID ADDRES 495 N INT [CC TITLE: No: 706	SKI.COPPIN A I T E C T U R E MOSMAN NSW 2088 E INFORMAN NOT STREET IEWCASTLE IERRELATE & DOWLING DMMERCIAL ALCULATIONS 02 DRAWING NOT GFA02
	CHITEC WC A R LEVEL 1. 1 T: 9953 8 DAVID W OJECT COJECT COJECT COJECT COJECT COJECT COJECT COJECT COJECT COJECT	T: DLS C F 507 MILITAL 477 FOLSKI TITLE: M SID SID SID ADDRES 495 N INT [CC TITLE: No: 706	SKI.COPPIN I T E C T U R E MOSMAN NSW 2088 E INFORWORKGOPPIN.COM.CU NSW ARB NO. 5297 IXED USE DENTIAL FLAT UILDING 35: 5-501 HUNTER STREET IEWCASTLE IERRELATE & DOWLING DMMERCIAL ALCULATIONS 02 DRAWING NO: 5 GFA02
	CHITEC WC A R LEVEL 1. 1 T: 9953 8 DAVID W OJECT COJECT COJECT COJECT COJECT COJECT COJECT COJECT COJECT COJECT	T: DLS C F 507 MILITAL 477 FOLSKI TITLE: M SID SID SID ADDRES 495 N INT [CC TITLE: No: 706	SKI.COPPIN I T E C T U R E MOSMAN NSW 2088 E INFORWORKGOPPIN.COM.CU NSW ARB NO. 5297 IXED USE DENTIAL FLAT UILDING 35: 5-501 HUNTER STREET IEWCASTLE IERRELATE & DOWLING DMMERCIAL ALCULATIONS 02 DRAWING NO: 5 GFA02
E PATH:	CHITEC WC A R LEVEL 1.1 17:995384 DAVID W COJECT RE COJECT IENT: COJECT COJECT COJECT COJECT COJECT COJECT COJECT COJECT COJECT COJECT COJECT COJECT COJECT		SKI.COPPIN A I T E C T U R E MOSMAN NSW 2088 E INFORWORKCOPPIN.COM.CU NSW ARB NO. 5297 IXED USE DENTIAL FLAT UILDING DENTIAL FLAT UILDING DENTIAL FLAT UILDING DENTIAL FLAT UILDING DENTIAL FLAT IEWCASTLE IERRELATE & DOWLING DOWLING DRAWING NO: DRAWING NO: DR
	CHITEC WC A R LEVEL 1. 1 T: 9953 8 DAVID W OJECT RE OJECT COJECT		SKI.COPPIN A I T E C T U R E MOSMAN NSW 2088 E INFORWORKCOPPIN.COM.CU NSW ARB NO. 5297 IXED USE DENTIAL FLAT UILDING DENTIAL FLAT UILDING DENTIAL FLAT UILDING DENTIAL FLAT UILDING DENTIAL FLAT IEWCASTLE IERRELATE & DOWLING DOWLING DRAWING NO: DRAWING NO: DR
St Newcastle Alt Scheme 200919			SKI. COPPIN A LTECTURE MOSMAN NSW 2088 E:Info@wolskicoppin.com.ou NSW ARB No. 5297 IXED USE DENTIAL FLAT UILDING 35: 5-501 HUNTER STREET IEWCASTLE IERRELATE & DOWLING DMMERCIAL DRAWING No: CALCULATIONS 02 DRAWING NO: DRAWING NO:

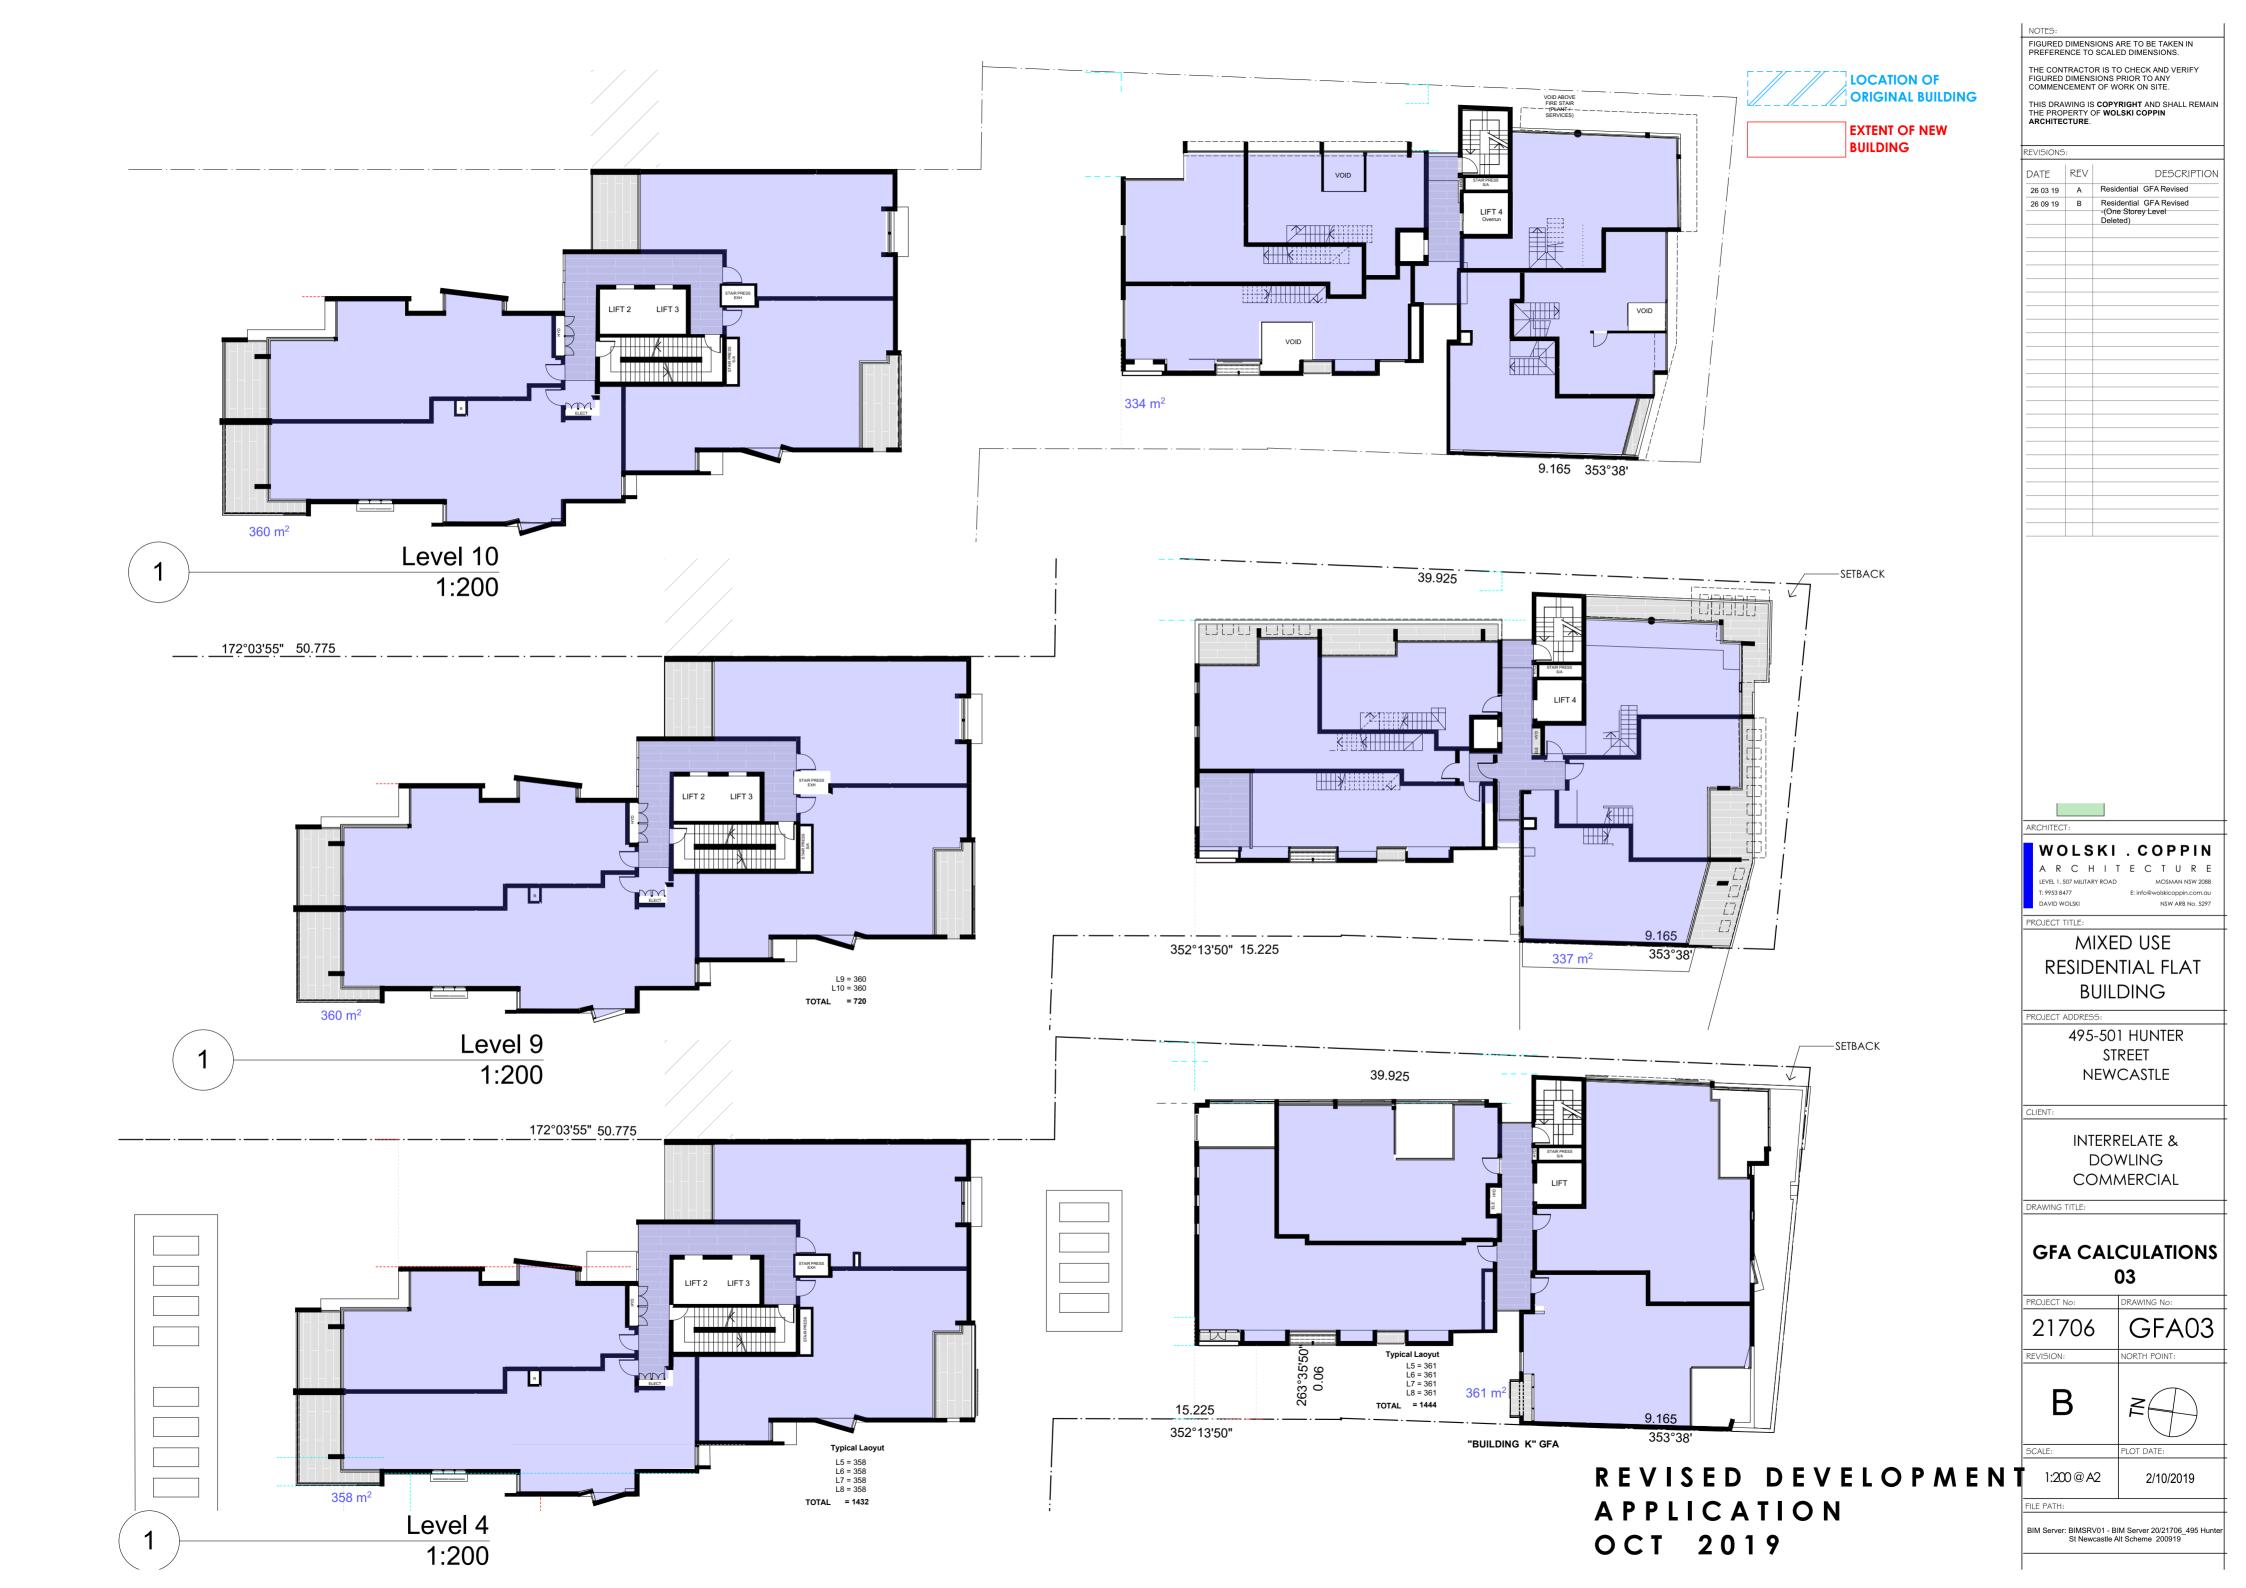

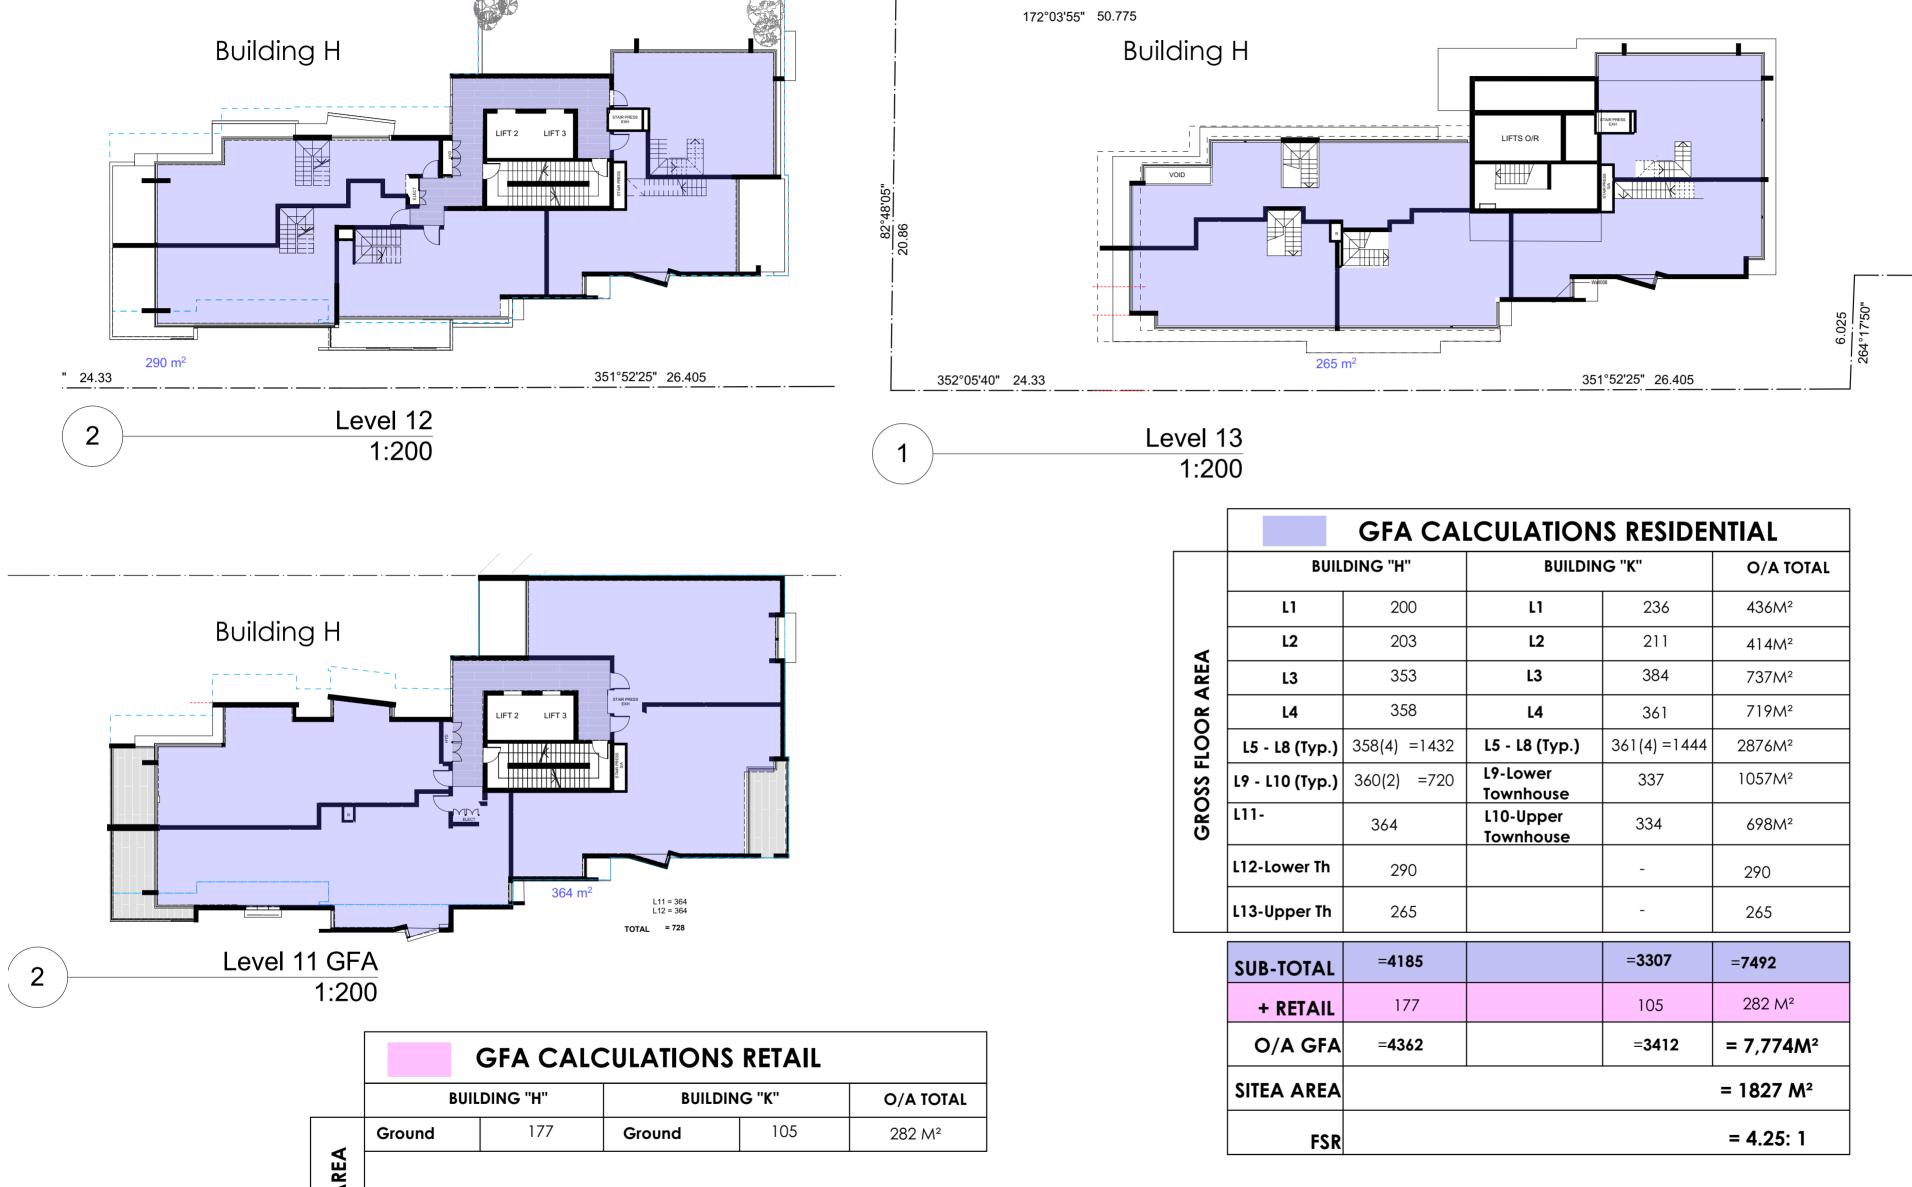

R ARE		
FLOO	SITEA AREA	= 1827 SQ. M
GROSS	O/A GFA	282 M ²
0		

03'55" 50.775



EXTENT OF NEW BUILDING

		GFA CAI		S RESIDE	NTIAL
	BUIL	DING "H"	BUILDIN	IG "K"	O/A TOTAL
	L1	200	LI	236	436M ²
1	L2	203	L2	211	414M ²
	L3	353	L3	384	737M ²
	L4	358	L4	361	719M ²
Š	L5 - L8 (Typ.)	358(4) =1432	L5 - L8 (Typ.)	361(4) =1444	2876M ²
	L9 - L10 (Typ.)	360(2) =720	L9-Lower Townhouse	337	1057M ²
	L11-	364	L10-Upper Townhouse	334	698M ²
	L12-Lower Th	290		-	290
	L13-Upper Th	265		-	265
	SUB-TOTAL	=4185		=3307	=7492
	+ RETAIL	177		105	282 M ²
	O/A GFA	=4362		=3412	= 7,774M ²
	SITEA AREA				= 1827 M ²
	FSR				= 4.25: 1

REVISED DEVELOPMENT APPLICATION OCT 2019

FIGURED	DIMEN	SIONS I	O CHECK AND VERIFY PRIOR TO ANY ORK ON SITE.
THIS DRAV	WING I	S COPY OF WO	ORK ON SITE. RIGHT AND SHALL RI L SKI COPPIN
REVISIONS			
DATE	REV	Booir	DESCRIP dential GFA Revised
26 03 19 26 09 19	A B	Resi	dential GFA Revised dential GFA Revised e Storey Level
		Dele	
A R	с н	нт	. СОРРІ ГЕСТИ В
wo	C H 07 MILITA 77	нт	T E C T U R
W O A R LEVEL 1, 5 T: 9953 84	C H C H 07 MILITA 77 OLSKI	H I I	F E C T U R MOSMAN NSW E: info@wolskicoppin.co NSW ARB No.
A R LEVEL 1, 5 T: 9953 84 DAVID WO	C H O7 MILITA 77 OLSKI TITLE:	H I RY ROAD	E C T U R MOSMAN NSW E: Info@wolskicoppin.co NSW ARB No.
A R LEVEL 1, 5 T: 9953 84 DAVID WO	DLS CH 07 MILITA 77 DISKI TITLE: M		E C T U R MOSMAN NSW E: Info@wolskicoppin.co NSW ARB NO. D USE TIAL FLA
A R LEVEL 1, 5 T: 9953 84 DAVID WO	DLS CH 07 MILITA 77 DISKI TITLE: M		E C T U R MOSMAN NSW E: Info@wolskicoppin.co NSW ARB No.
A R LEVEL 1, 5 T: 9953 84 DAVID WO	DLS CH 07 MILITA 77 DISKI TITLE: M SIC B	IXE DEN UIL	E C T U R MOSMAN NSW E: Info@woldkicoppin.co NSW ARB NO D USE TIAL FLAT DING
WO AR LEVEL 1.5 T: 9953 84 DAVID W(PROJECT T	DLS CH 07 MILITA 77 DISKI TITLE: M SIC B	IXE DEN UIL	E C T U R MOSMAN NSW E: Info@wolskicoppin.co NSW ARB NO. D USE TIAL FLA
WO AR LEVEL 1.5 T: 9953 84 DAVID W(PROJECT T	C H C H OT MILITA DOLSKI ITTLE: M SIC B ADDRES 495	IXE DEN UIL 5-50 ST	E C T U R MOSMAN NSW E: Info@wolskicoppin.co NSW ARB NO. D USE TIAL FLAT DING 1 HUNTER
PROJECT A	C H C H OT MILITA DOLSKI ITTLE: M SIC B ADDRES 495	IXE DEN UIL 5-50 ST	E C T U R MOSMAN NSW E: Info@wolskicoppin.co NSW ARB NO. D USE TIAL FLAT DING 1 HUNTER REET
WO AR LEVEL 1.5 T: 9953 84 DAVID W(PROJECT T	C H C H O7 MILITA O7 MILITA O	IXE DEN UIL 5-50 ST IEW	E C T U R MOSMAN NSW E: Info@wolskicoppin.co NSW ARB NO. D USE TIAL FLAT DING 1 HUNTER REET CASTLE
PROJECT A	C H C H OT MILITA TTTLE: M SID SID B A95 N IN	HIII RYROAD UIL 339: 5-50 ST IEW	E C T U R MOSMAN NSW E: Info@Woldklcoppin.co NSW ARB NO. D USE TIAL FLAT DING 1 HUNTER REET CASTLE
PROJECT A	C F C F O7 MILITA O7 MILITA O	IXE DEN UIL 5-50 ST IEW	E C T U R MOSMAN NSW E: Info@wolskicoppin.co NSW ARB NO. D USE TIAL FLAT DING 1 HUNTER REET CASTLE
PROJECT A		IXE DEN UIL 5-50 ST IEW	E C T U R MOSMAN NSW E: Info@Wolskicoppin.co NSW ARB NO. D USE TIAL FLAT DING 1 HUNTER REET CASTLE RELATE & WLING
PROJECT A CLIENT:		IXE DEN UIL 5-50 ST IEW	E C T U R MOSMAN NSW E: Info@Wolskicoppin.co NSW ARB NO. D USE TIAL FLAT DING 1 HUNTER REET CASTLE RELATE & MLING MERCIAL
PROJECT A CLIENT:		IXE DEN UIL 5-50 ST IEW TERF DON DMA	E C T U R MOSMAN NSW E: Info@Wolskicoppin.co NSW ARB NO. D USE TIAL FLAT DING 1 HUNTER REET CASTLE RELATE & WLING
PROJECT A CLIENT:		IXE DEN UIL 5-50 ST IEW TERF DON DMA	E C T U R MOSMAN NSW E: Info@Woldkicoppin.co NSW ARB NO. D USE TIAL FLAT DING 1 HUNTER REET CASTLE RELATE & WLING MERCIAL
RE PROJECT A CLIENT: DRAWING		IXE DEN UIL 55: 5-50 ST IEW TERF DON DMN	E C T U R MOSMAN NSW E: Info@Wolskicoppin.co NSW ARB NO. D USE TIAL FLAT DING 1 HUNTER REET CASTLE RELATE & MLING MERCIAL
RE PROJECT F		IXE DEN UIL 55: 5-50 ST IEW TERF DON DMN	TECTUR MOSMAN NSW E: Info@wolskicoppin.co NSW ARB NO. DUSE TIAL FLAT DING 1 HUNTER REET CASTLE RELATE & VLING MERCIAL CULATIO D4
PROJECT A CLIENT: DRAWING PROJECT T RE PROJECT A PROJECT A PROJECT A PROJECT A REVISION:		IXE DEN UIL 55: 5-50 ST IEW TERF DON DMN	E INTORVOSKICOPPINCO NSW ARB NO. D USE TIAL FLAT DING 1 HUNTER REET CASTLE RELATE & WLING MERCIAL CULATIO
PROJECT A CLIENT: DRAWING PROJECT T CLIENT: DRAWING PROJECT N CLIENT:		IXE DEN UIL 55: 5-50 ST IEW TERF DON DMN	E INTORVOSKICOPPINCO NSW ARB NO. D USE TIAL FLAT DING 1 HUNTER REET CASTLE RELATE & WLING MERCIAL CULATIO
RE PROJECT A PROJECT A PROJECT A PROJECT A PROJECT A PROJECT A PROJECT N PROJECT N PROJECT N		IXE DEN UIL 55: 5-50 ST IEW TERF DON DMN	E INTORVOSKICOPPINCO NSW ARB NO. D USE TIAL FLAT DING 1 HUNTER REET CASTLE RELATE & WLING MERCIAL CULATIO
RE PROJECT A CLIENT: DRAWING T CLIENT: DRAWING T CLIENT: DRAWING T CLIENT: DRAWING T CLIENT: DRAWING T CLIENT: CLIEN		IXE DEN UIL 55: 5-50 ST IEW TERF DON DMN	E INTORVOSKICOPPINCO NSW ARB NO. D USE TIAL FLAT DING 1 HUNTER REET CASTLE RELATE & WLING MERCIAL CULATIO
RE PROJECT A CLIENT: DRAWING T CLIENT: DRAWING T CLIENT: DRAWING T CLIENT: DRAWING T CLIENT: DRAWING T CLIENT: DRAWING T CLIENT: CLIENT: DRAWING T CLIENT: DRAWING T CLIENT:		IXE DEN UIL 5-50 ST IEW IERF DOV	E C T U R MOSMAN NSW E: Info@Woldkicoppin.co NSW ARB NO. D USE TIAL FLAT DING 1 HUNTER REET CASTLE RELATE & WLING MERCIAL DRAWING NO: GFAC

BIM Server: BIMSRV01 - BIM Server 20/21706_495 Hunter St Newcastle Alt Scheme 200919



DATE 30 09 19	REV		
			DESCRIPTIC
		EXTEN	IT OF ORIGINAL DA
A R	DLS CH 507 MILITA 477 VOLSKI	H I T ry road	E C T U R MOSMAN NSW 200 E: Info@wolskicoppin.com.c NSW ARB No. 525
	Μ	IXE	d USE
RE	SID	EN	TIAL FLAT
	В	UILI	DING
PROJECT			
			I HUNTER
		-	REET
	Ν	IEM	CASTLE
CLIENT:			
UPPEN I i			
			ELATE & VLING
			VLING AERCIAL
DRAWING	TITLE:		
SH			DIAGRAN NE 9AM
PROJECT			
217	706	5	SH01
REVISION	:		NORTH POINT:
ŀ	7		Z
SCALE:			PLOT DATE:
1:50	A@0	2	2/10/2019
FILE PATH	:		


HILT OF SHOOD

REVISED


DEVELOPMENT


APPLICATION

OCT 2019

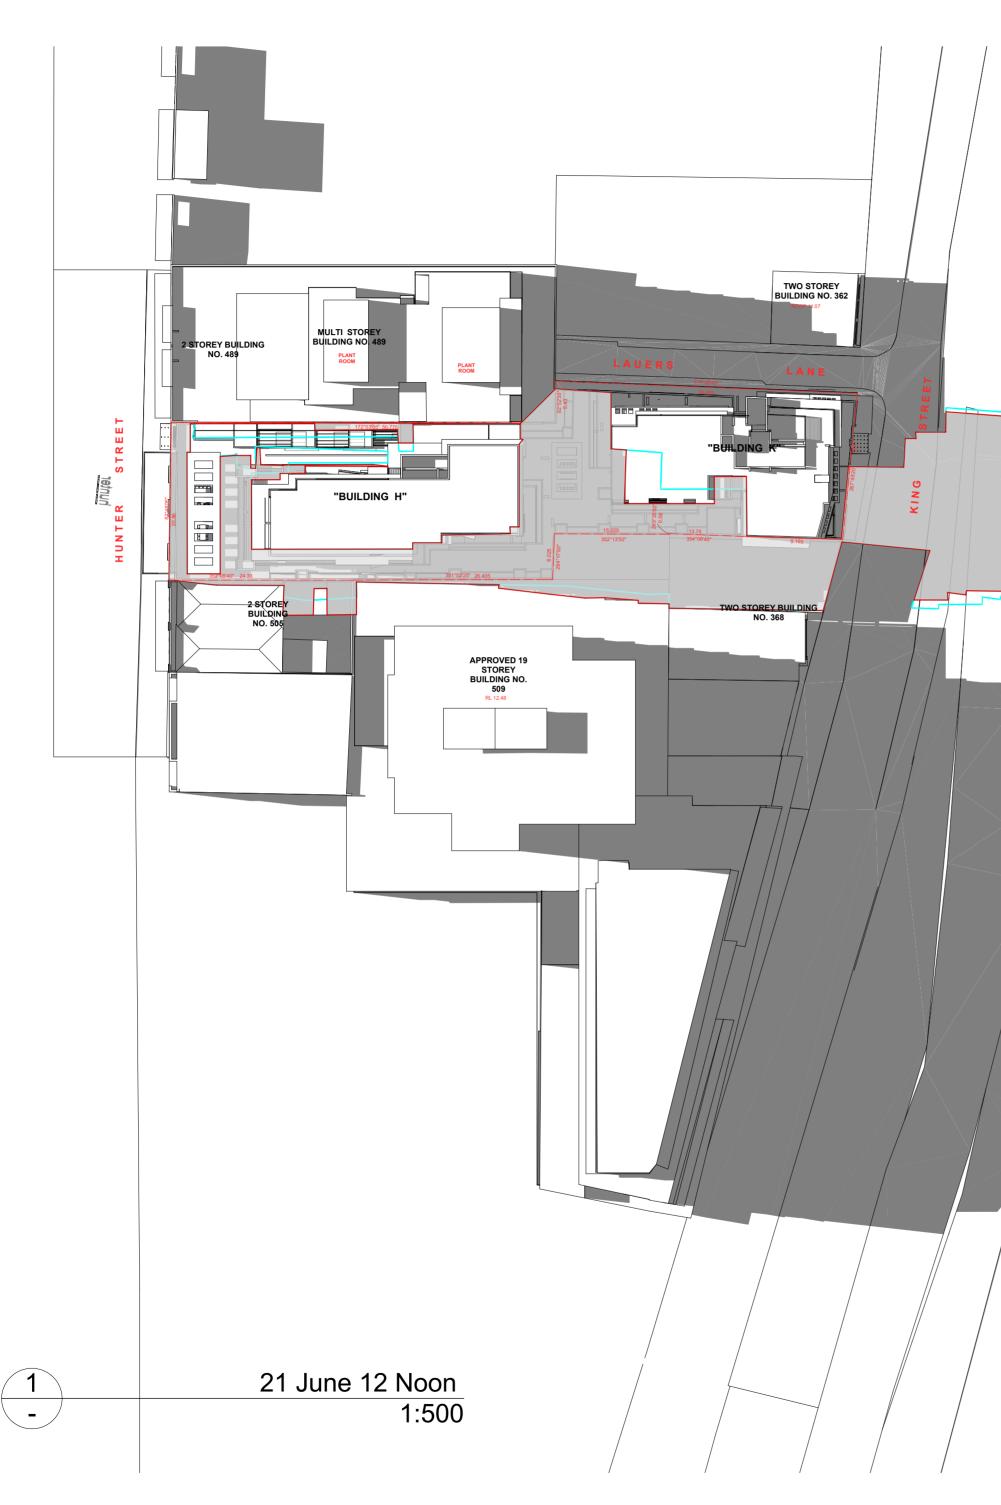



PREFERE	NCE TO	SIONS ARE TO BE TAKEN IN) SCALED DIMENSIONS. DR IS TO CHECK AND VERIFY SIONS PRIOR TO ANY
COMMEN THIS DRA	CEMEN	T OF WORK ON SITE. S COPYRIGHT AND SHALL REMAIL OF WOLSKI COPPIN
ARCHITE		
REVISIONS DATE	REV	DESCRIPTION
30 09 19	Α	UPDATE SHADOW AS SHOWN EXTENT OF ORIGINAL DA
		SHADOW ADDED
_		
ARCHITEC		
wc	DLS	KI.COPPIN
W C A R LEVEL 1, 5 T: 9953 84	DLS CH 507 MILITA 477	H I T E C T U R E RY ROAD MOSMAN NSW 2088 E: info@wolskicoppin.com.au
A R LEVEL 1, 5	DLS CH 507 MILITA 477 YOLSKI	H I T E C T U R E RY ROAD MOSMAN NSW 2088
A R LEVEL 1, 5 T: 9953 84 DAVID W	DLS CH 507 MILITA 477 YOLSKI TITLE :	H I T E C T U R E RY ROAD MOSMAN NSW 2088 E: info@wolskicoppin.com.au
A R LEVEL 1, 4 T: 9953 84 DAVID W PROJECT	DLS CH 507 MILITA 477 YOLSKI TITLE:	H I T E C T U R E RY ROAD MOSMAN NSW 2088 E: Info@wolskicoppin.com.au NSW ARB No. 5297
A R LEVEL 1, 4 T: 9953 84 DAVID W PROJECT	DLS CH 507 MILITA 477 YOLSKI TITLE: M	HITECTURE RYROAD MOSMAN NSW 2088 E: Info@wolskicoppin.com.au NSW ARB No. 5297
A R LEVEL 1, 4 T: 9953 84 DAVID W PROJECT	DLS CH 507 MILITA 477 'OLSKI TITLE: M SID B ADDRES	HITECTURE RY ROAD MOSMAN NSW 2088 E: Info@wolkicoppin.com.uu NSW ARB No. 5297
REP	DLS CH 507 MILITA 477 'OLSKI TITLE: M SID B ADDRES	HITECTURE RY ROAD MOSMAN NSW 2088 E: Info@wolkidcoppin.com.au NSW ARB No. 5297 IXED USE DENTIAL FLAT UILDING 55: 5-501 HUNTER
REP	DLS CH 507 MILITA 477 FOLSKI TITLE: M SID B ADDRES 495	HITECTURE RY ROAD MOSMAN NSW 2088 E: Info@wolkicoppin.com.uu NSW ARB No. 5297
REPROJECT	DLS CH 507 MILITA 477 FOLSKI TITLE: M SID B ADDRES 495	HITECTURE RY ROAD MOSMAN NSW 2088 E: Info@wolkicoppin.com.au NSW ARB No. 5297 IXED USE DENTIAL FLAT UILDING 55: 5-501 HUNTER STREET
REP	DLS CF 507 MILTA 477 TITLE: M ESID B SID B ADDRES 495	A I T E C T U R E MOSMAN NSW 2088 E: Info@wolkicoppin.com.au NSW ARB No. 5297
RE PROJECT	C H SOT MILITA ATT TITTLE: M SSID B SSID B SSID ADDRES 495	A I T E C T U R E MOSMAN NSW 2088 E: Info@wolkicopin.com.au NSW ARB No. 5297
RE PROJECT	C F S07 MILTA S07 MILTA STTTLE: M SSID B SSID B SSID B ADDRES 495 N	A I T E C T U R E MOSMAN NSW 2088 E: Info@wolkicoppin.com.au NSW ARB No. 5297
RE PROJECT	DLS CH 507 MILITA 4777 TITTLE: M ESID B ESID B ESID B 4955 N INT I CC	A I T E C T U R E RY ROAD E: Info@wolkidcoppin.com.au NSW ARB No. 5297 IXED USE DENTIAL FLAT UILDING 55: 5-501 HUNTER STREET IEWCASTLE IERRELATE & DOWLING
PROJECT	DLS CH 507 MILITA 4777 TITTLE: M ESID B ESID B ESID B 4955 N INT I CC	A I T E C T U R E RY ROAD E: Info@wolkidcoppin.com.au NSW ARB No. 5297 IXED USE DENTIAL FLAT UILDING 55: 5-501 HUNTER STREET IEWCASTLE IERRELATE & DOWLING
RE PROJECT	DLS CF 507 MILITA 477 TITTLE: M ESID B SSID B SSID B SSID B ADDRES 495 N INT I CC TITTLE:	A I T E C T U R E MOSMAN NSW 2088 E: Info@wolkicoppin.com.au NSW ARB No. 5297 IXED USE DENTIAL FLAT UILDING 35: 5-501 HUNTER STREET IEWCASTLE IERRELATE & DOWLING DMMERCIAL
RE PROJECT	ADDES	A I T E C T U R E MOSMAN NSW 2088 E: Info@wolkicoppin.com.au NSW ARB No. 5297 IXED USE DENTIAL FLAT UILDING 35: 5-501 HUNTER STREET IEWCASTLE IERRELATE & DOWLING DMMERCIAL
RE PROJECT	DLS CF S07 MILITA MATT COLSKI TITTLE: M SSID B SSID B SSID B SSID C SSID SSID	A I T E C T U R E MOSMAN NSW 2088 E: Info@wolkicoppin.com.au NSW ARB No. 5297 IXED USE DENTIAL FLAT UILDING DS: 5-501 HUNTER STREET IEWCASTLE IERRELATE & DOWLING DMMERCIAL DW DIAGRAM NE 12 NOON
RE PROJECT	DLS CH S07 MILITA 477 COLSKI TITTLE: M SSID B SSID B SSID COL TITTLE: NO:	A I T E C T U R E MOSMAN NSW 2088 E: Info@wolkicoppin.com.au NSW ARB No. 5297
RE PROJECT		A I T E C T U R E MOSMAN NSW 2088 E: Info@wolkicoppin.com.au NSW ARB No. 5297 IXED USE DENTIAL FLAT UILDING DS: 5-501 HUNTER STREET IEWCASTLE IERRELATE & DOWLING DMMERCIAL DW DIAGRAM NE 12 NOON
RE PROJECT		A I T E C T U R E MOSMAN NSW 2088 E: Info@wolkidcoppin.com.au NSW ARB No. 5297
RE PROJECT		A I T E C T U R E MOSMAN NSW 2088 E: Info@wolkidcoppin.com.au NSW ARB No. 5297
RE PROJECT		A I T E C T U R E MOSMAN NSW 2088 E: Info@wolkidcoppin.com.au NSW ARB No. 5297
CLIENT: CRE PROJECT		A I T E C T U R E MOSMAN NSW 2088 E: Info@wolkicoppin.com.au NSW ARB No. 5297

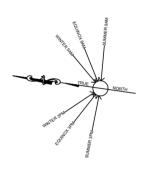

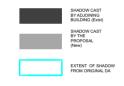



REVISED DEVELOPMENT APPLICATION OCT 2019

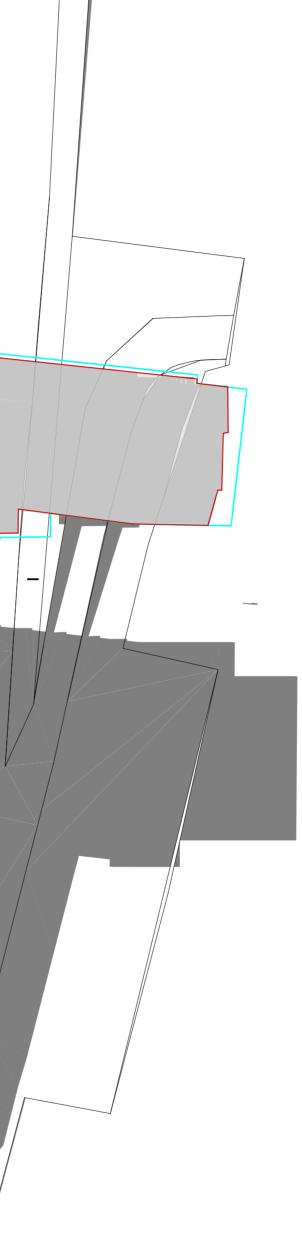

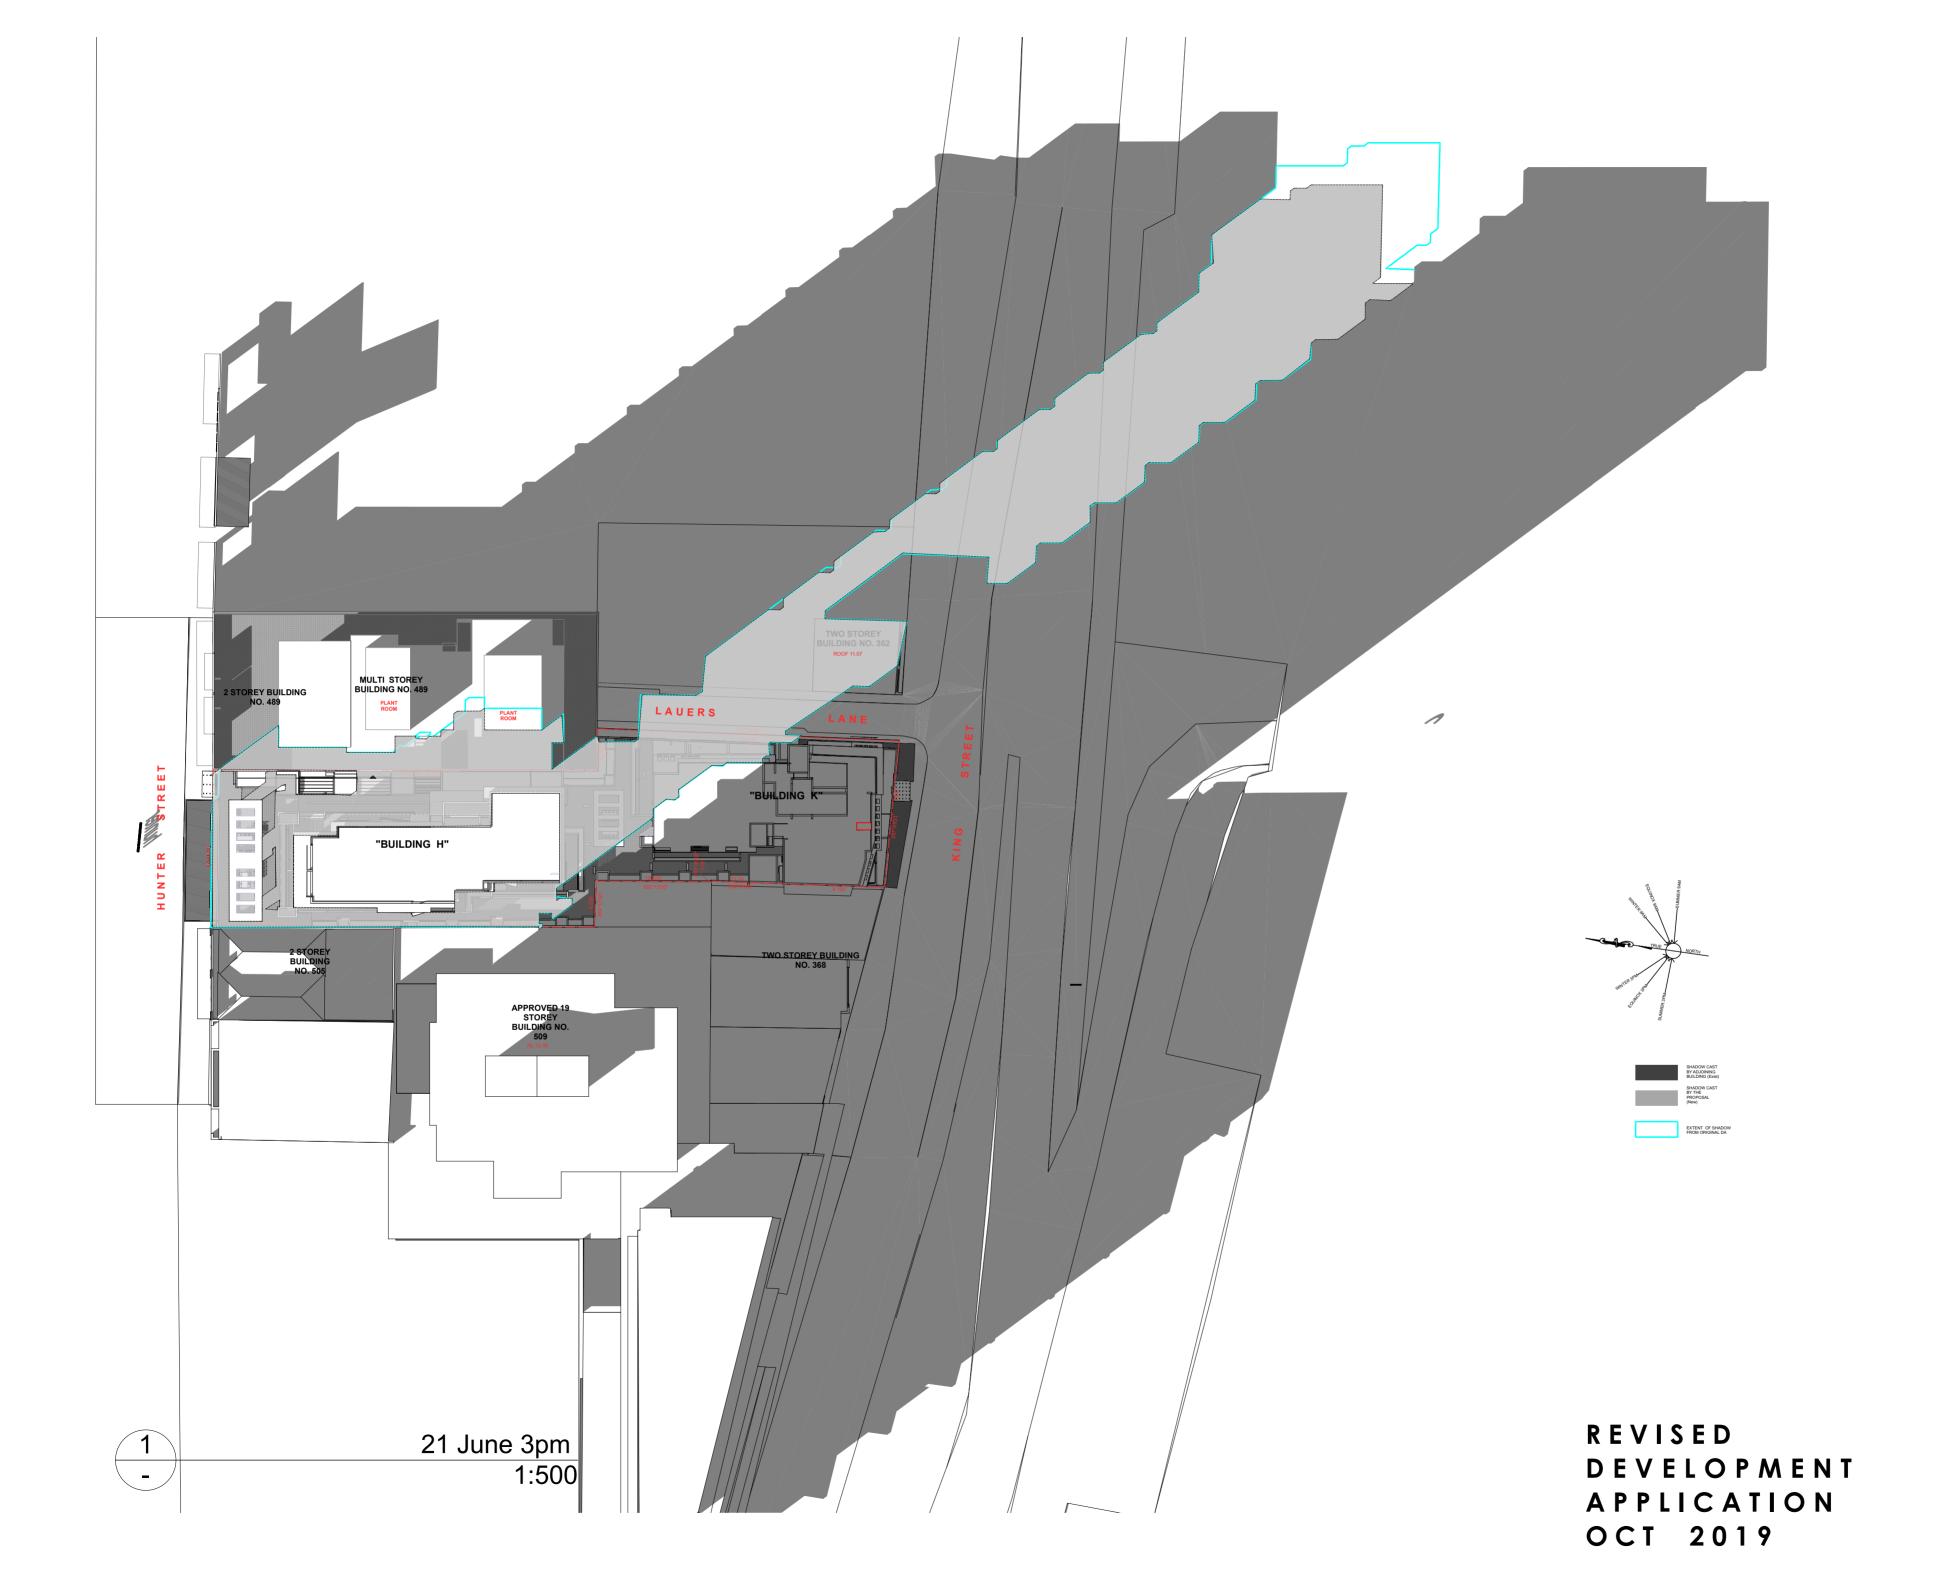


FIGURED		OR IS TO CHECK AND VERIFY SIONS PRIOR TO ANY T OF WORK ON SITE.
	PERTY	S COPYRIGHT AND SHALL REMAIN OF WOLSKI COPPIN
EVISION	ð:	
DATE	REV	DESCRIPTION
30 09 19	A	UPDATE SHADOW AS SHOWN EXTENT OF ORIGINAL DA SHADOW ADDED
		_
A R LEVEL 1, T: 9953 8 DAVID V	DLS CH 507 MILITA 4477 VOLSKI TITLE:	KI.COPPIN HITECTURE RY ROAD E: Info@wolskicoppin.com.au NSW ARB No. 5297
A R LEVEL 1, T: 9953 8 DAVID V	DLS CH 507 MILITA 1477 VOLSKI TITLE: M SSID	HITECTURE RYROAD MOSMAN NSW 2088 E: info@wolskicoppin.com.au NSW ARB No. 5297
RE	DLS CH 507 MILITA 4777 VOLSKI TITLE: M SSID B ADDRES	IXED USE DENTIAL FLAT UILDING
REPROJECT	DLS CH 507 MILITA 4777 VOLSKI TITLE: M SID B ADDRES 495	I T E C T U R E MOSMAN NSW 2088 E: Info@wolkicoppin.com.au NSW ARB No. 5297
RE PROJECT	DLS CH 507 MILITA 4477 VOLSKI TITLE: M SID SID B ADDRES 495	A I T E C T U R E MOSMAN NSW 2088 E: Info@wolskicoppin.com.au NSW ARB No. 5297
RE PROJECT	DLS CH 507 MILITA 477 VOLSKI TITLE: M SID B ADDRES 495 N INT I CC TITLE:	A I T E C T U R E MOSMAN NSW 2088 E: Info@wolkkcoppin.com.au NSW ARB No. 5297
RE PROJECT CLIENT: DRAWING	DLS CF 507 MILITA 4777 VOLSKI TITLE: M SID B ADDRES 495 ADDRES 495 N INT I CC TITLE: ADC 21	A I T E C T U R E MOSMAN NSW 2088 E: Info@wolskicoppin.com.au NSW ARB No. 5297
RE CLIENT: CLIENT: CRE	DLS CH 507 MILITA 477 VOLSKI TITLE: M SID B ADDRES 495 ADDRES 495 N INT INT INT INT CC 21 No:	A LITECTURE RY ROAD E: Info@wolskicoppin.com.au NSW ARB No. 5297 IXED USE DENTIAL FLAT UILDING 35: 5-501 HUNTER STREET IEWCASTLE IERRELATE & DOWLING DMMERCIAL DW DIAGRAM JUNE 3PM
RE PROJECT CLIENT: DRAWING SHA		A I T E C T U R E MOSMAN NSW 2088 E:Info@wolkkcoppin.com.au NSW ARB No. 5297 IXED USE DENTIAL FLAT UILDING 35: 5-501 HUNTER STREET IEWCASTLE IERRELATE & DOWLING DMMERCIAL DOWLING DMMERCIAL DRAWING NO: 5 SH03
A R LEVEL 1, T: 9953 8 DAVID V PROJECT PROJECT		A LITECTURE RY ROAD E: Info@wolskicoppin.com.au NSW ARB No. 5297 IXED USE DENTIAL FLAT UILDING 35: 5-501 HUNTER STREET IEWCASTLE IERRELATE & DOWLING DMMERCIAL DW DIAGRAM JUNE 3PM
RE PROJECT CLIENT: DRAWING SHA		A I T E C T U R E MOSMAN NSW 2088 E:Info@wolkkcoppin.com.au NSW ARB No. 5297 IXED USE DENTIAL FLAT UILDING 35: 5-501 HUNTER STREET IEWCASTLE IERRELATE & DOWLING DMMERCIAL DOWLING DMMERCIAL DRAWING NO: 5 SH03
REVISION REVISION		A I T E C T U R E MOSMAN NSW 2088 E:Info@wolskicoppin.com.au NSW ARB No. 5297 IXED USE DENTIAL FLAT UILDING 35: 5-501 HUNTER STREET IEWCASTLE IERRELATE & DOW DIAGRAM JUNE 3PM DRAWING No: 5 SH03 NORTH POINT: PLOT DATE:

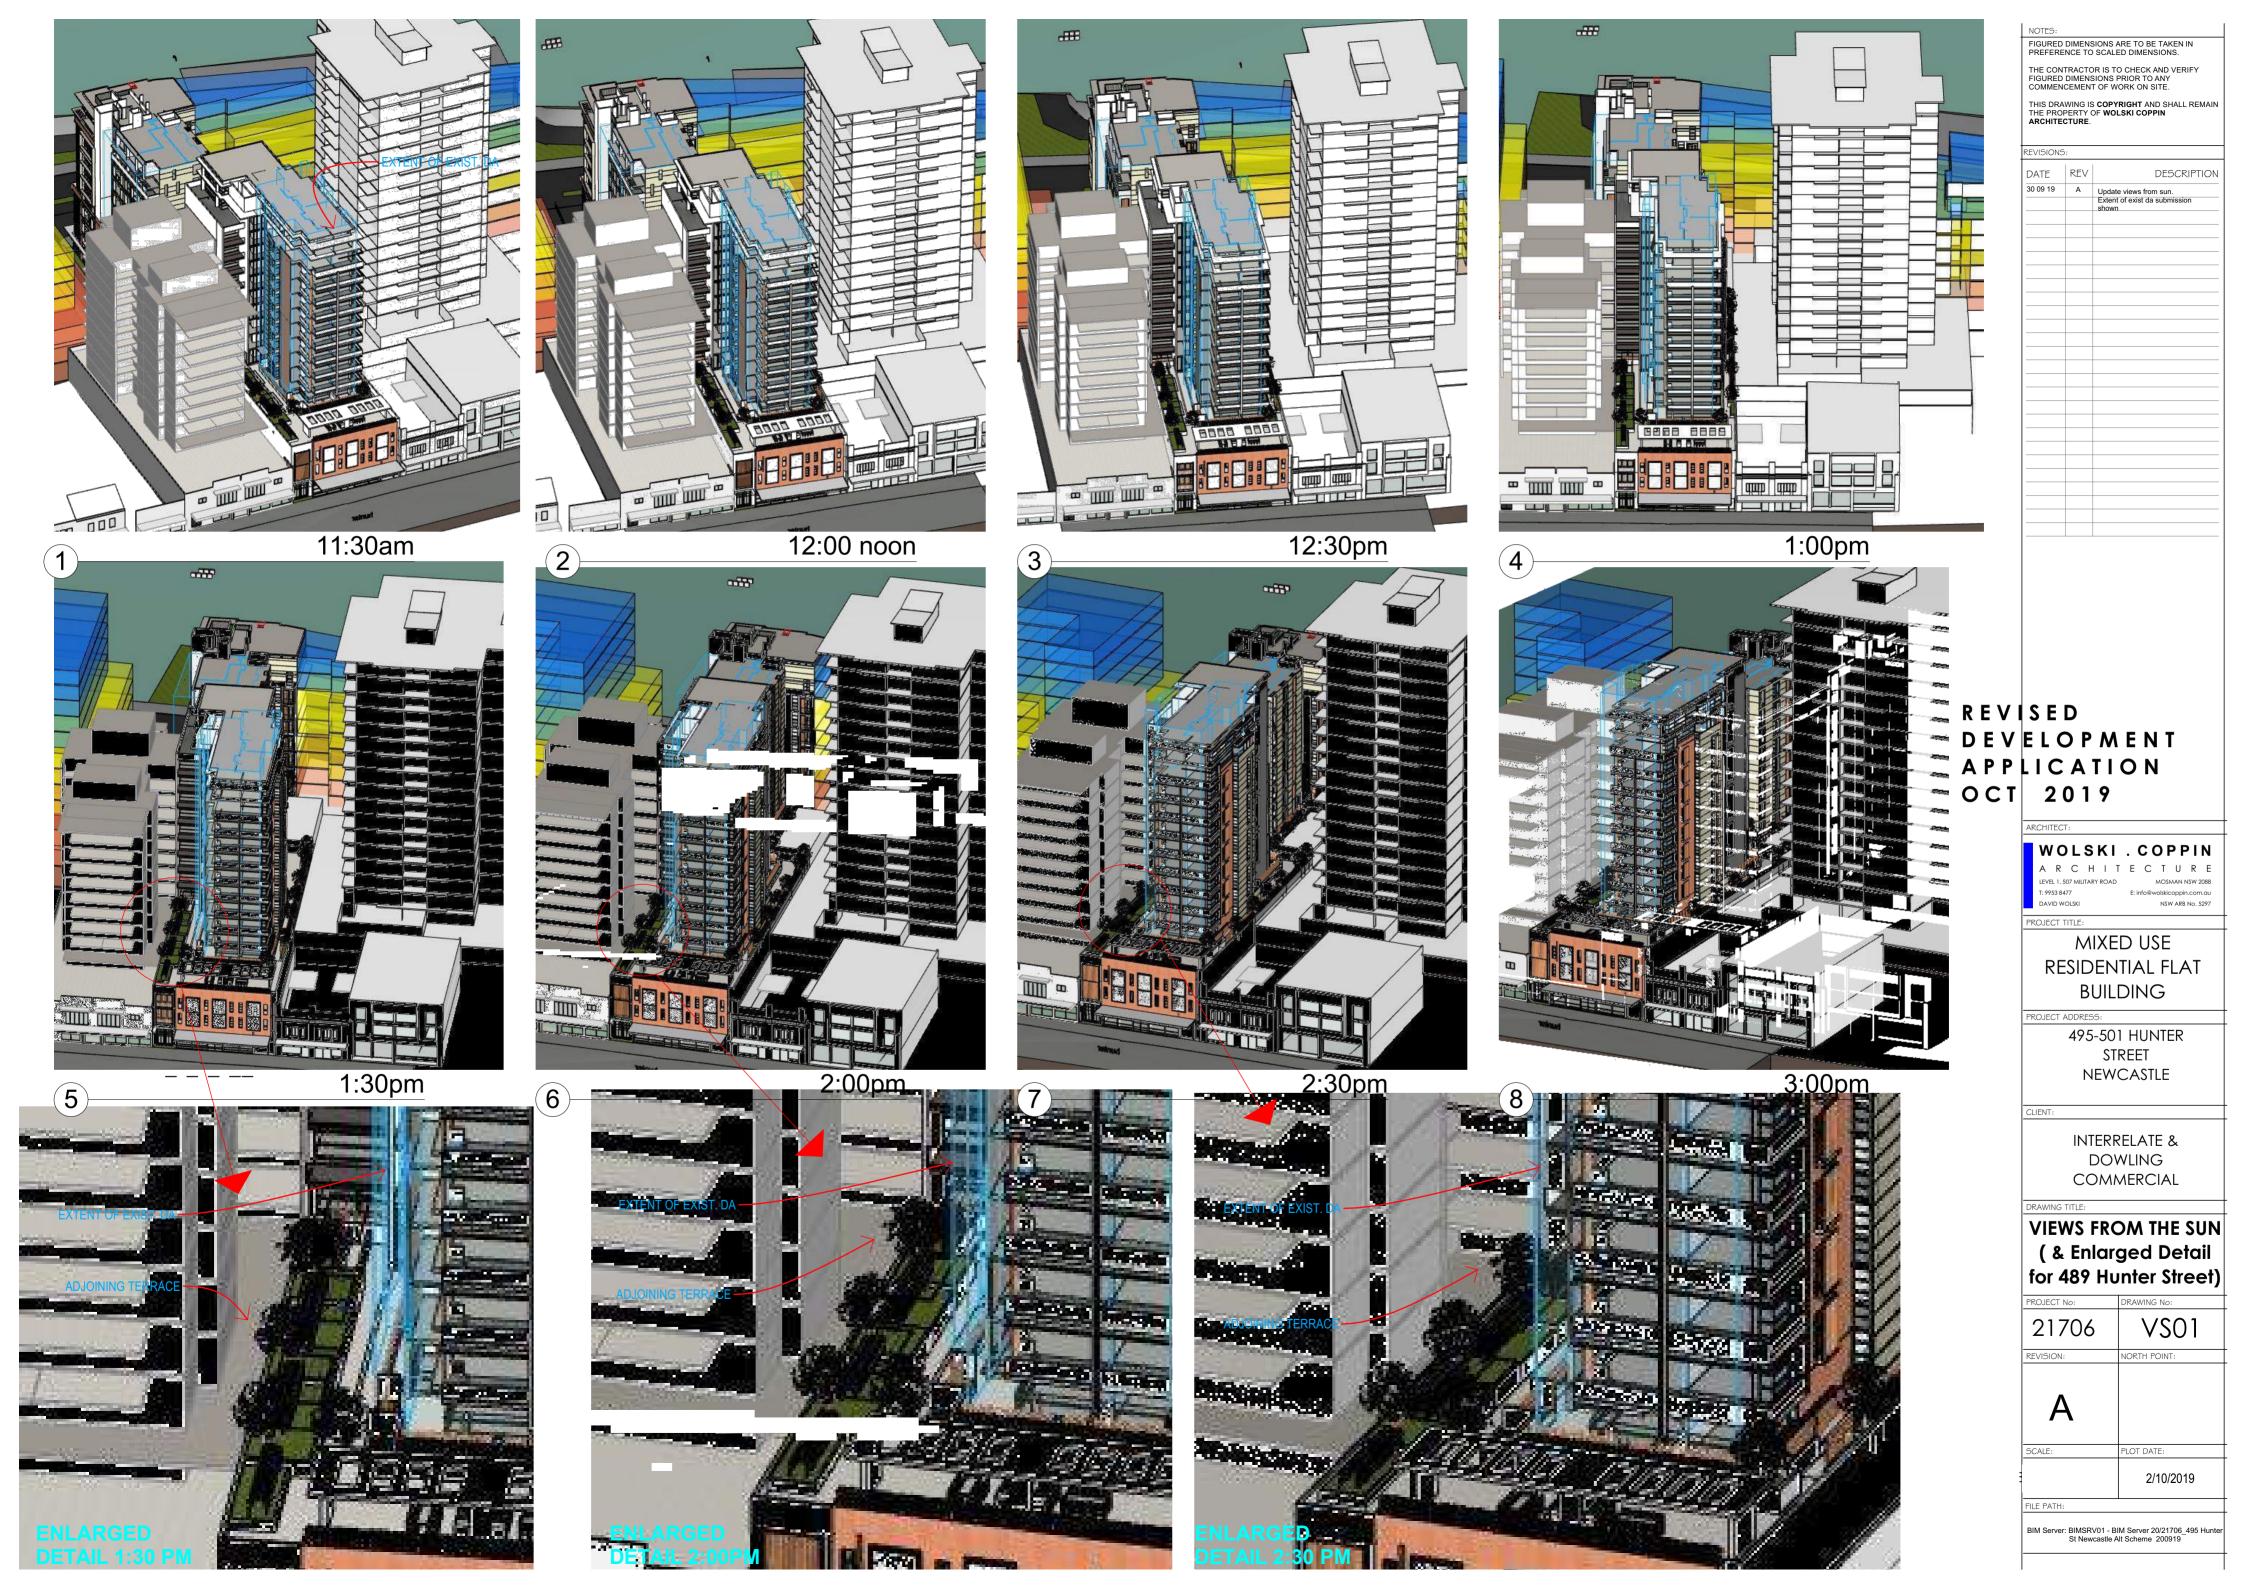

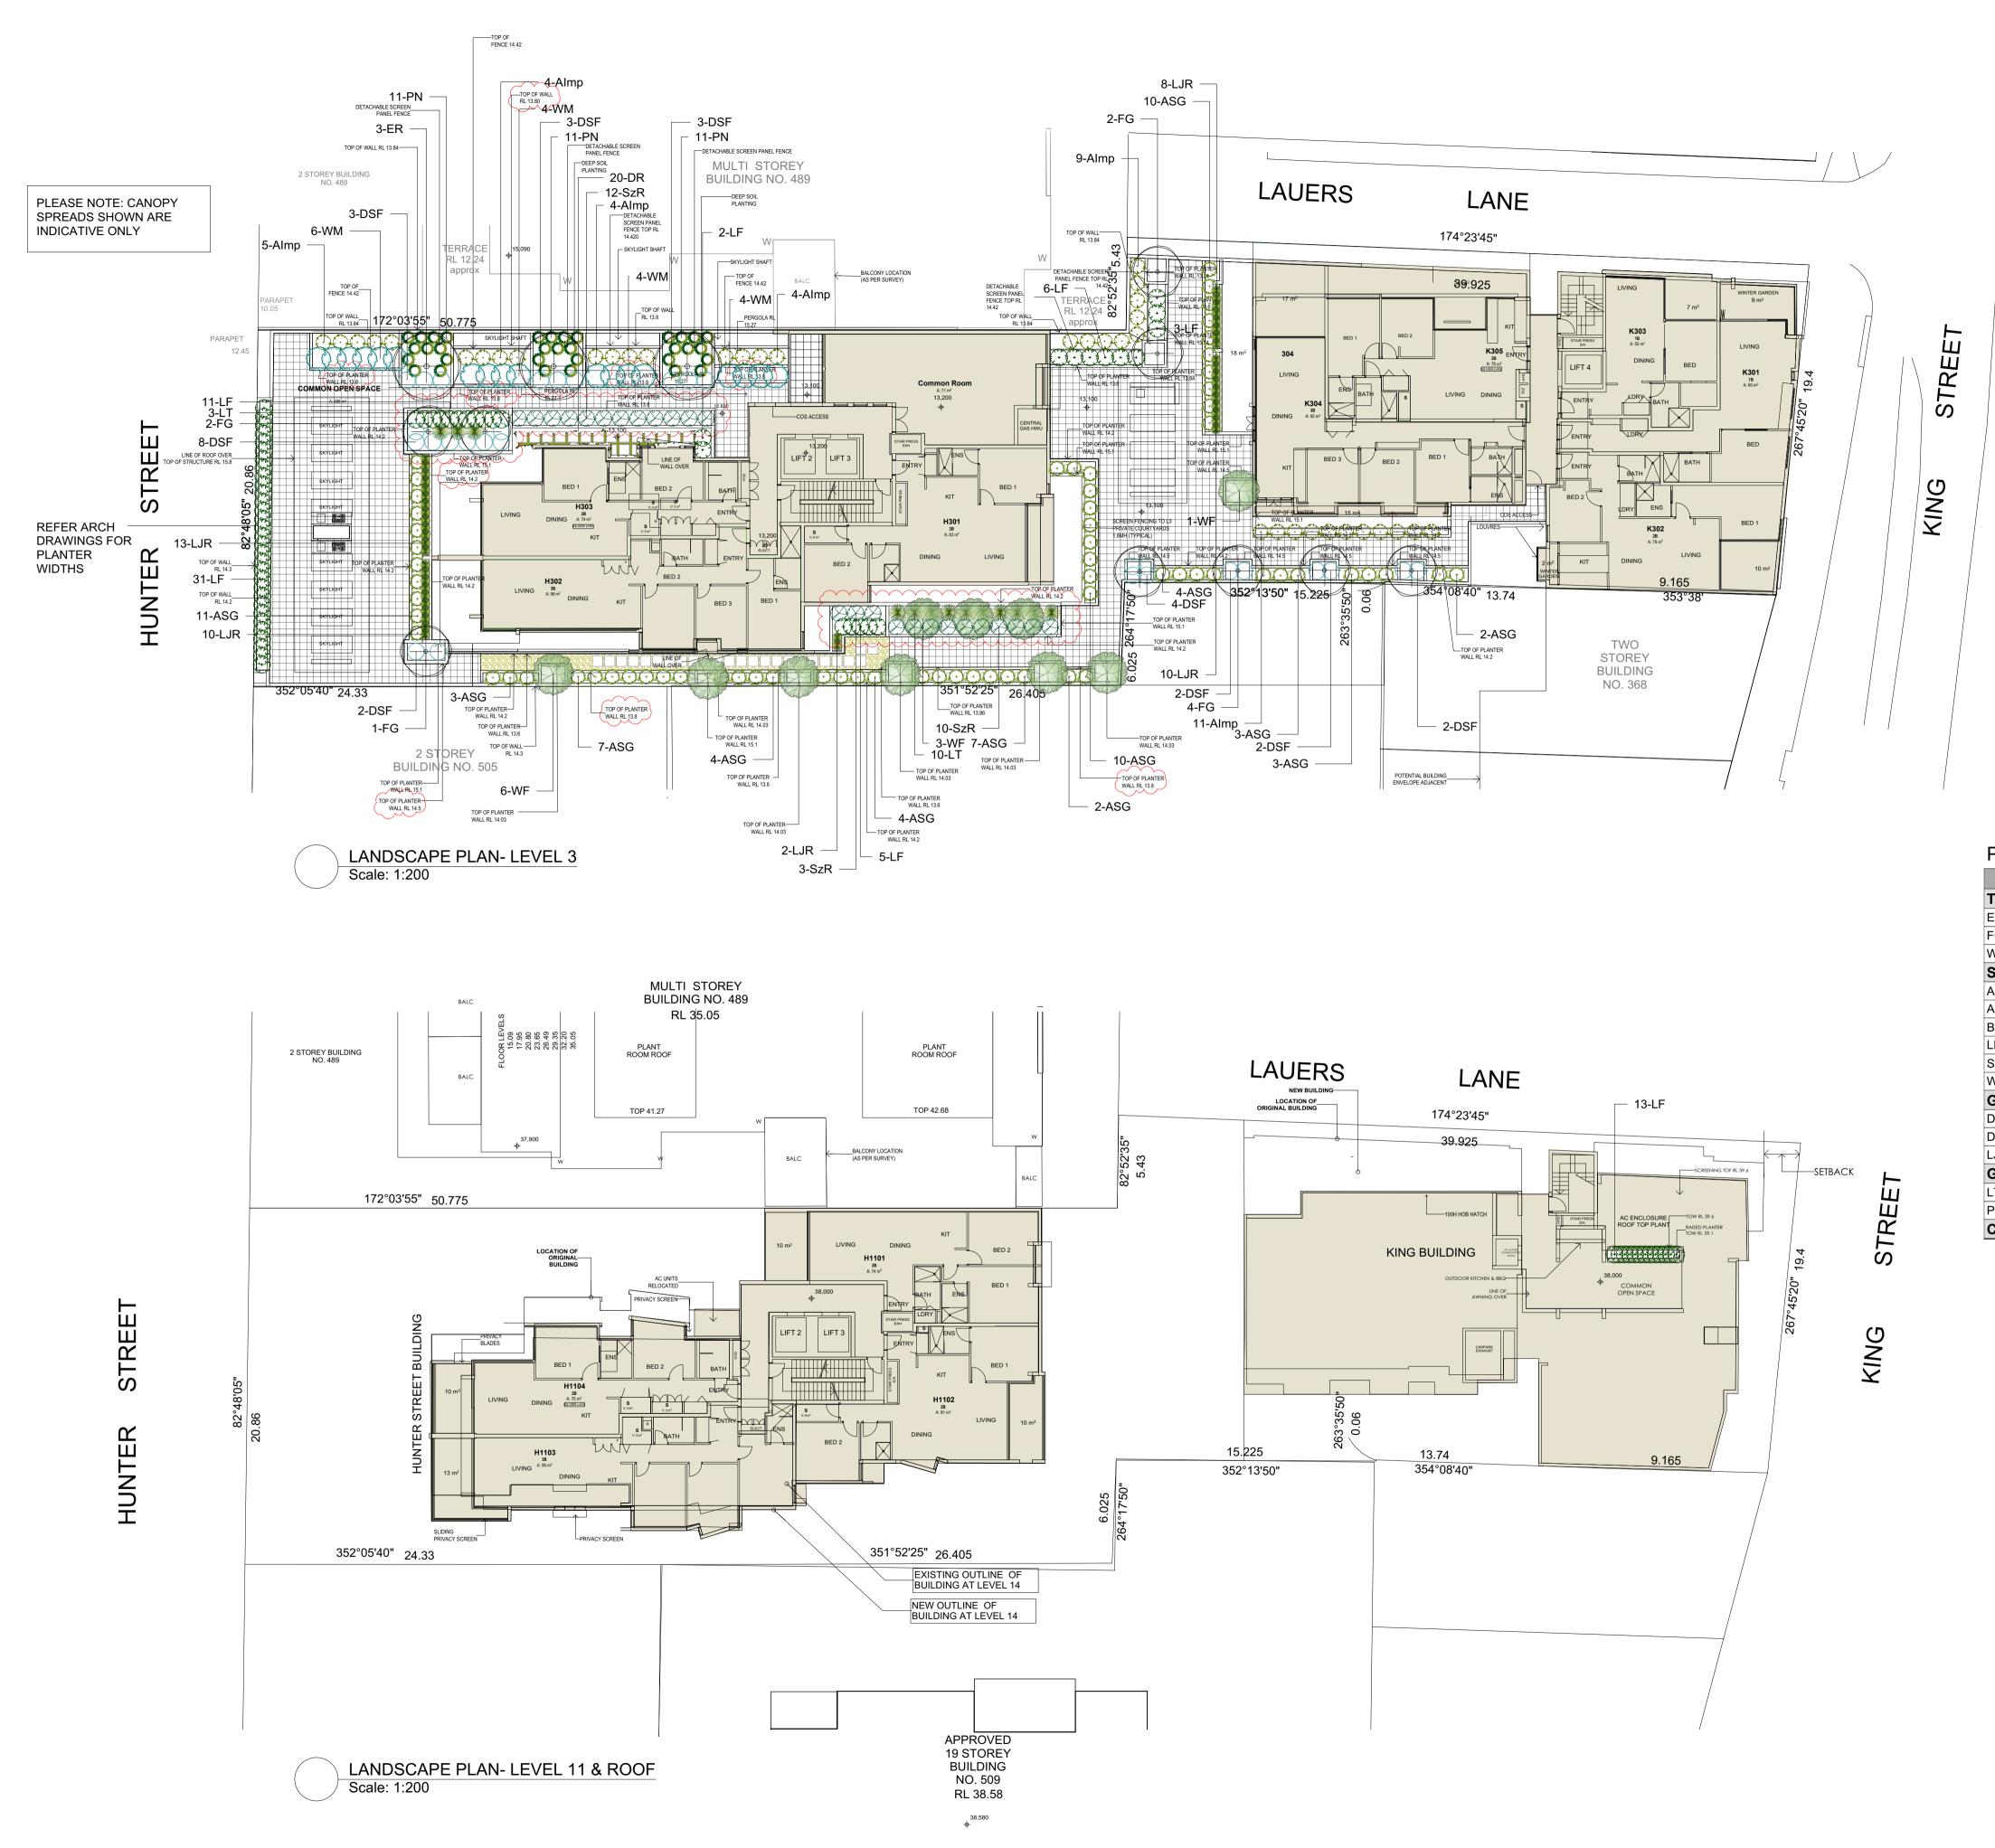

Plant List ID Botani

ID	Botanical Name	Common Name	Pot Size	Mature Height	Mature Spread	Qty
Trees						
ER	Elaeocarpus reticulatus	Blueberry Ash	45L	. 5 - 10m	3.5 - 6m	3
FG	Fraxinus grifithii	Evergreen Ash	45L	. 6 - 8m	4 - 6m	9
WF	Waterhousia floribunda	Weeping Lilly Pilly	45L	. 5 - 10m	3.5 - 6m	10
Shrubs						
ASG	Acmena 'Green Form'	Green Form	200mm	5m	2 - 3m	70
Almp	Acronychia imperforata	Fraser Island Apple	200mm	ı 4m	3m	37
BM	Buxus microphylla	Japanese Box	200mm	1m	1m	13
LF	Leptospermum 'Foreshore'	'Foreshore'	200mm	0.5m	1m	58
SzR	Syzygium 'Resilience'	Resilience	200mm	3m	1m	25
WM	Westringia mundi	Mundi	200mm	0.6m	1.5m	18
Ground	I Covers					
DR	Dichondra repens	Kidney Grass	tube	0.0 - 0.3m	0.0 - 0.3m	20
DSF	Dichondra 'Silver Falls'	Silver Kidney Weed	140mm	0.0 - 0.3m	1.2 - 2.0m	29
LJR	Liriope 'Just Right'	Just Right	140mm	0.45 - 0.6m	0.3 - 0.6m	43
Grasse	S					
LT	Lomandra 'Tanika'	Dwarf mat rush	140mm	0.45 - 0.6m	0.6 - 0.9m	13
PN	Pennisetum 'Nafray'	Nafray	140mm	0.6 - 0.75m	0.3 - 0.6m	33
Climbe	rs					

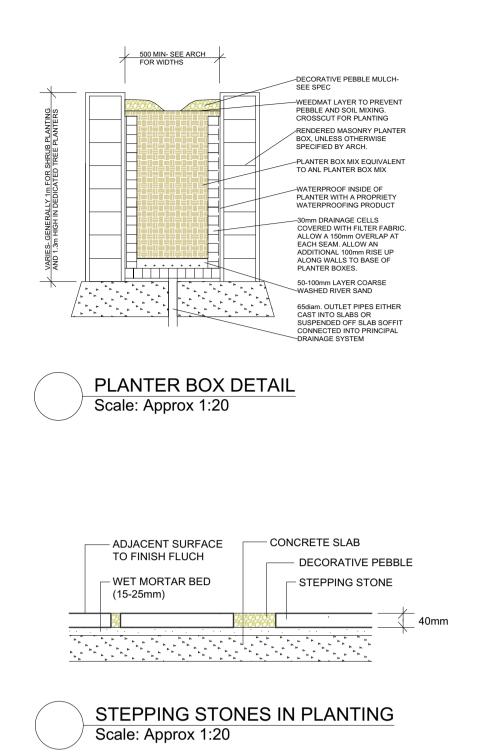

0m	5m	10m	
SCALE 1	200		
C REC D BUIL	NOTES OF MEETING DUCED PLANT CANOPI LDING SHIFTED WEST NTER BOXES WIDER &		02.08.18 07.11.18 23.01.20 29.01.20
Client C	ATALYST PROJEC	T CONSUL	TING
Proposed Multi Residential Development 495-501 Hunter Street NEWCASTLE			
Drawing Nam Date	Drawing Name Landscape Plan Date AUGUST 2017		
Scale 1	^{Scale} 1:200 @ A1		Page no. 1/2
	Cubov Pan BLARCH (UNSW)	Drawing No. US 71046	LP.01E
	BLARCH (UNSW)	5	

LANDSCAPE WORK SPECIFICATION Proiect:

PRELIMINARIES

1.01 GENERAL

The following general conditions should be considered prior to the commencement of landscape works:

- The landscape plans should be read in conjunction with the architectural plans, hydraulic plans, service plans and survey prepared for the proposed development.

- All services including existing drainage should be accurately located prior to the commencement of landscape installation. Any proposed tree planting which falls close to services will be relocated on site under the instruction of the landscape architect.

- Installation of conduit for required irrigation, electrical and other services shall be completed prior to the commencement of hardscape works and hardstand pours.

- All outdoor lighting specified by architect or client to be installed by qualified electrician

- Anomalies that occur in these plans should be brought to our immediate attention

- Where an Australian Standard applies for any landscape material testing or installation technique, that standard shall be followed.

- All work is to be carried out to a tradesman-like standard.

1.02 PROTECTION OF ADJACENT FINISHES

The Contractor shall take all precautions to prevent damage to all or any adjacent finishes by providing adequate protection to these areas / surfaces prior to the commencement of the Works

1.03 EROSION & POLLUTION CONTROL

The Contractor shall take all proper precautions to prevent the erosion of soil from the subject site. The contractor shall install erosion & sediment control barriers and as required by council, and maintain these barriers throughout the construction period. Note that the sediment control measures adopted should reflect the soil type and erosion characteristics of the site

Erosion & pollution control measures shall incorporate the following: - Construction of a sediment trap at the vehicle access point to the subject site.

- Sediment fencing using a geotextile filter fabric in the location indicated on the erosion control plan or as instructed on site by the landscape architect

- Earth banks to prevent scour of stockpiles
- Sandbag kerb sediment traps
- Straw bale & geotextile sediment filter.

- Exposed banks shall be pegged with an approved Jute matting in preparation for mass planting

Refer to "Sitewise Reference Kit" as prepared by DLWC & WSROC (1997) for construction techniques

SOIL WORKS

2.01 MATERIALS

Planter Box Areas

Imported soil mix is only to be installed to planter boxes following the completion of sheet drainage installation. All planter boxes are to be backfilled with an imported soil mix suitable for planter box applications, for their entire depth. The backfilling is to be undertaken in 150mm deep layers with a light compaction by foot at each layer to reduce the extent of settling in the future. The soil is to finish 100mm below the finished edge of the planter box to allow for mulch installation.

Soil Mix: Equivalent to OZ landscaping supplies planter box mix is to be used in planter boxes.

2.02 INSTALLATION

a) Drainage Works

Install surface and subsurface drainage where required and as detailed on the drawing. Drain subsurface drains to outlets provided, with a minimum fall of 1:100 to outlets and / or service pits.

PLANTING

3.01 MATERIALS

a) Quality and Size of Plant Material

In General, the principles & standards outlined in "Specifying Trees - a guide to assessment of tree quality" by Ross Clark will be demanded in the quality of all planting stock specified. These principles include, but are not limited to:

Above - Ground Assessment:

The following plant quality assessment criteria should be followed: Plant true to type, Good vigour and health, free from pest & disease, free from injury, self-supporting, good stem taper, has been pruned correctly, is apically dominant, has even crown symmetry, free from included bark & stem junctions, even trunk position in pot, good stem structure Below -Ground Assessment:

Good root division & direction, rootball occupancy, rootball depth, height of crown, non-suckering For further explanation and description of these assessment criteria, refer to Ross Clark's book.

All Plant material shall be to the type and size specified. No substitutions of plant material shall be permitted without written prior approval by the Landscape Architect. No plant shall be accepted which does not conform to the standards listed above.

b) Fertilizers

Fertilizers shall be approved slow release fertilisers suitable for the proposed planting types. Note that for native plants, specifically Proteaceae family plants including Grevillea species, low phosphorus fertilizers shall be used.

c) Mulch

Mulch shall be an approved leaf litter equal to "Forest Blend" as supplied by ANL. In areas of high wind velocity, pebble mulch will be used in lieu of organic leaf litter mulch. Pebbles are to be laid on weedmat to prevent soil and mulch mixing. Weedmat to be crosscut to accomodate planting. Mulch shall be completely free from any soil, weeds, rubbish or other debris.

3.02 INSTALLATION

a) Setting Out

All planting set out shall be in strict accordance with the drawings, or as directed. Note that proposed tree planting located near services should be adjusted at this stage. Notify Landscape Architect for inspection for approval prior to planting.

b) Planting

All plant material shall be planted as soon after delivery as possible. Planting holes for trees shall be excavated as detailed and specified. Plant containers shall be removed and discarded, and the outer roots gently teased from the soil mass. Immediately set plant in hole and backfill with specified soil mix, incorporating the approved quantity of fertiliser for each plant type. Ensure that plants are set plumb vertically and root balls set to the consolidated finished grades detailed on the drawings. Compact the backfilled soil and saturate by hand watering to expel any remaining air pockets immediately after planting.

c) Staking and Tying

Trees shall be of a quality that, when planted, are freestanding, without the aid of stakes or ties, else they will be rejected.

d) Mulchina

Mulch should be spread so that a compacted thickness of 75mm is achieved after settlement in all planting beds and around each individual plant. Apply immediately following planting and watering in, ensuring that a 50mm radius is maintained around the trunk of each plant . In all planter boxes, mulch to finish between 25-50mm below top of planter.

There shall be no mixing of soil and mulch material

e) Root Barrier

Ensure root barrier is installed to all edges/junctions beween the garden bed and adjacent hard surfaces including but not limited to retaining walls, carparking, paths, underground pipes and tanks and buildings within a 3m radius of the trunk of any proposed trees.

Equivalent to treemax root barrier. Install Root barrier: root barrier to manufacturer's instructions.

f) Stepping Stones

Precast concrete slabs of 400-500mm SQ (or similar approved dimensions) shall be placed as indicated on plan at 200mm intervals. Finish and colour of stepping stones shall be nominated by the client. Install stepping stones as detail, flush with adjoining elements. Compact area under stepping stones locally where stepping stones occur in garden areas and generally where stepping stones occur in pea gravel areas

g) Pea Gravel/Decorative Pebble

Compact area for pea gravel and Decorative Pebble installation with vibrating plate compactor before installation of pea gravel or Decorative Pebble

Gravel/Pebbles are to be installed loose to the gap between the installed		
stepping stones. They are to finish flush with the adjacent paved surface		
and be topped up should they settle after installation. At the edges of a		
stepping stone and gravel/pebble area the gravel/pebble is to be retained		
by a garden edge.		

Gravel Inlays:	Equivalent to 10mm Indo Cream pea gravel.
Pebbles:	Equivalent to 20mm Indo Cream Pebble

h) Filter Fabric in Planter Boxes

All planter boxes are to have sheet drainage equivalent to 50mm Atlantis Drainage Cell installed to their entire base and sides finishing 200mm below the top of the finished planter walls. A 3-4 oz non-woven filter fabric is to cover the sheet drainage prior to the addition of planter soil. Drainage cell is only to be installed after the planter boxes have been waterproofed and tested for water tightness (by others) and there is a drainage point (by others) within each planter, which in turn drains to the site stormwater system. The Landscape Contractor is to confirm to their satisfaction that the planter boxes are waterproofed and well drained prior to the installation of any sheet drainage.

HARDSCAPE WORKS

4.01 GENERAL

The Contractor shall undertake the installation of all hardscape works as detailed on the drawing, or where not detailed, by manufacturers specification

- Paving - refer to typical details provided, and applicable Australian Standards

Permeable paving may be used as a suitable means of satisfying Council

permeable surface requirements, while providing a useable, hardwearing.

practical surface. In most instances, the client shall nominate the appropriate

paving material to be used.

Planters on-slab - refer to the details provided and the architectural plans for size & dimensions. Waterproof as detailed, and backfill with specified soil mix

Australian Standards shall be adhered to in relation to all concrete, masonry & metal work. Some details are typical and may vary on site. All hardscape works shall be setout as per the drawings, and inspected and approved by the Landscape Architect prior to installation. All workmanship shall be of the highest standard. Any queries or problems that arise from hardscape variations should be bought to the attention of the Landscape Architect.

IRRIGATION WORKS

5.01 GENERAL (PERFORMANCESPECIFICATION)

New irrigation systems to planting areas shall be a Commercial Grade Irrigation System conforming to AS 3500 & the latest Sydney Water Code

The irrigation system shall be installed prior to all planting works. It shall incorporate a commercially available irrigation system, with dripper lines for all trees, and suitable jet sprinkler heads for the shrub species specified. It shall also incorporate a suitable back flow prevention device for the scale of works, an in-line filter, check valves, and suitable high and low density poly hose fittings and PVC piping to achieve flow rates suitable for specified planting.

This shall include, but not be limited to, the following items where and as required:

winter

The landscape contractor shall check the existing pressure available from the ring mains and size irrigation piping to suit. Supply shall be from local hose cock where available. All piping and fittings are to be buried 50mm below the finished soil levels in garden bed areas, and secured in position at 5m centre with galv wire pins. Sizing of pipes shall be done so as to ensure that the working pressure at the end of the line does not decrease by more than 5%.

Upon completion of installation, the system shall be tested and all components are to be satisfactorily functional and operational prior to approval. Should any defect develop, or the capacity or efficiency of the system decline during the agreed maintenance system, then these faults shall be immediately rectified.

Detailed drawings of the entire proposed irrigation system shall be made available to the client for records and future maintenance of the system.

CONSOLIDATION AND MAINTENANCE

6.01 GENERAL

The consolidation and maintenance period shall be 12 months beginning from the approved completion of the specified construction work (Practical Completion). A qualified landscape maintenance contractor shall undertake the required landscape maintenance works. Consolidation and maintenance shall mean the care and maintenance of Contracted works by accepted landscaping or horticultural practices, ensuring that all plants are in optimum growing conditions and appearance at all times, as well as rectifying any defects that become apparent in the contracted works.

- Watering all planting and lawn areas / irrigation maintenance.
- Clearing litter and other debris from landscaped areas.
- Removing weeds, pruning and general plant maintenance.
- Replacement of damaged, stolen or unhealthy plants.
- Make good areas of soil subsidence or erosion.
- Topping up of mulched areas.
- Spray / treatment for Insect and disease control.
- Fertilizing with approved fertilizers at correct rates.
- Mowing lawns & trimming edges each 14 days in summer or 18 days in

- Maintenance of all paving, retaining and hardscape elements.

On the completion of the maintenance period, the landscape works shall be inspected and at the satisfaction of the superintendent or landscape architect, the responsibility will be signed over to the client.

Client CATALYST PROJECT CONSULTING		
Project Proposed Multi Residential Development 495-501 Hunter Street NEWCASTLE		
Drawing Name Specification S Date AUGUST 20178	Sheet	
Size A3		Page no. 2/2
Drawn by Lubov Pan BLARCH (UNSW)	Drawing No. US 71046 I	LP.02A
FORUM URBAN SANCTUM Indscape design PO BOX 261 67 McMICHAEL ST MARYVILLE NSW 2293 T: 02 4961 4980 F: 02 4969 1282 E: admin@forumengs.com.au A.B.N. 48 157 853 677		

PUBLIC VOICE COMMITTEE MEETING

18 February 2020

PV 18/02/2020

DA2017/01376 - 495-501 Hunter Street & 364 King Street Newcastle

Attachment B: Processing Chronology

DISTRIBUTED UNDER SEPARATE COVER



PROCESSING CHRONOLOGY

DA2017/01376 - 495-501 Hunter Street & 364 King Street Newcastle

2 November 2017	Development application lodged
11 November 2017	Public notification
21 February 2018	Advice from Urban Design Consultative Group meeting
30 April 2018	Request for additional information
May and June 2018	Advice from Urban Design Consultative Group meeting
26 June 2018	Amended plans submitted
June and November 2018	Request for additional information
15 January 2019	Amended plans submitted
24 January 2019	Request for additional information
12 February 2019	Public notification of amended plans
20 February 2019	Advice from Urban Design Consultative Group meeting
28 Feb – April 2019	Additional information submitted
16 July 2019 meeting	Application considered at Public Voice Committee
28 August 2019	CN final advice letter - request for additional information
October 2019	Amended plans submitted
29 October 2019	Public notification of amended plans
20 November 2019	Advice from Urban Design Consultative Group meeting
18 February 2020 meeting	Application scheduled for Public Voice Committee